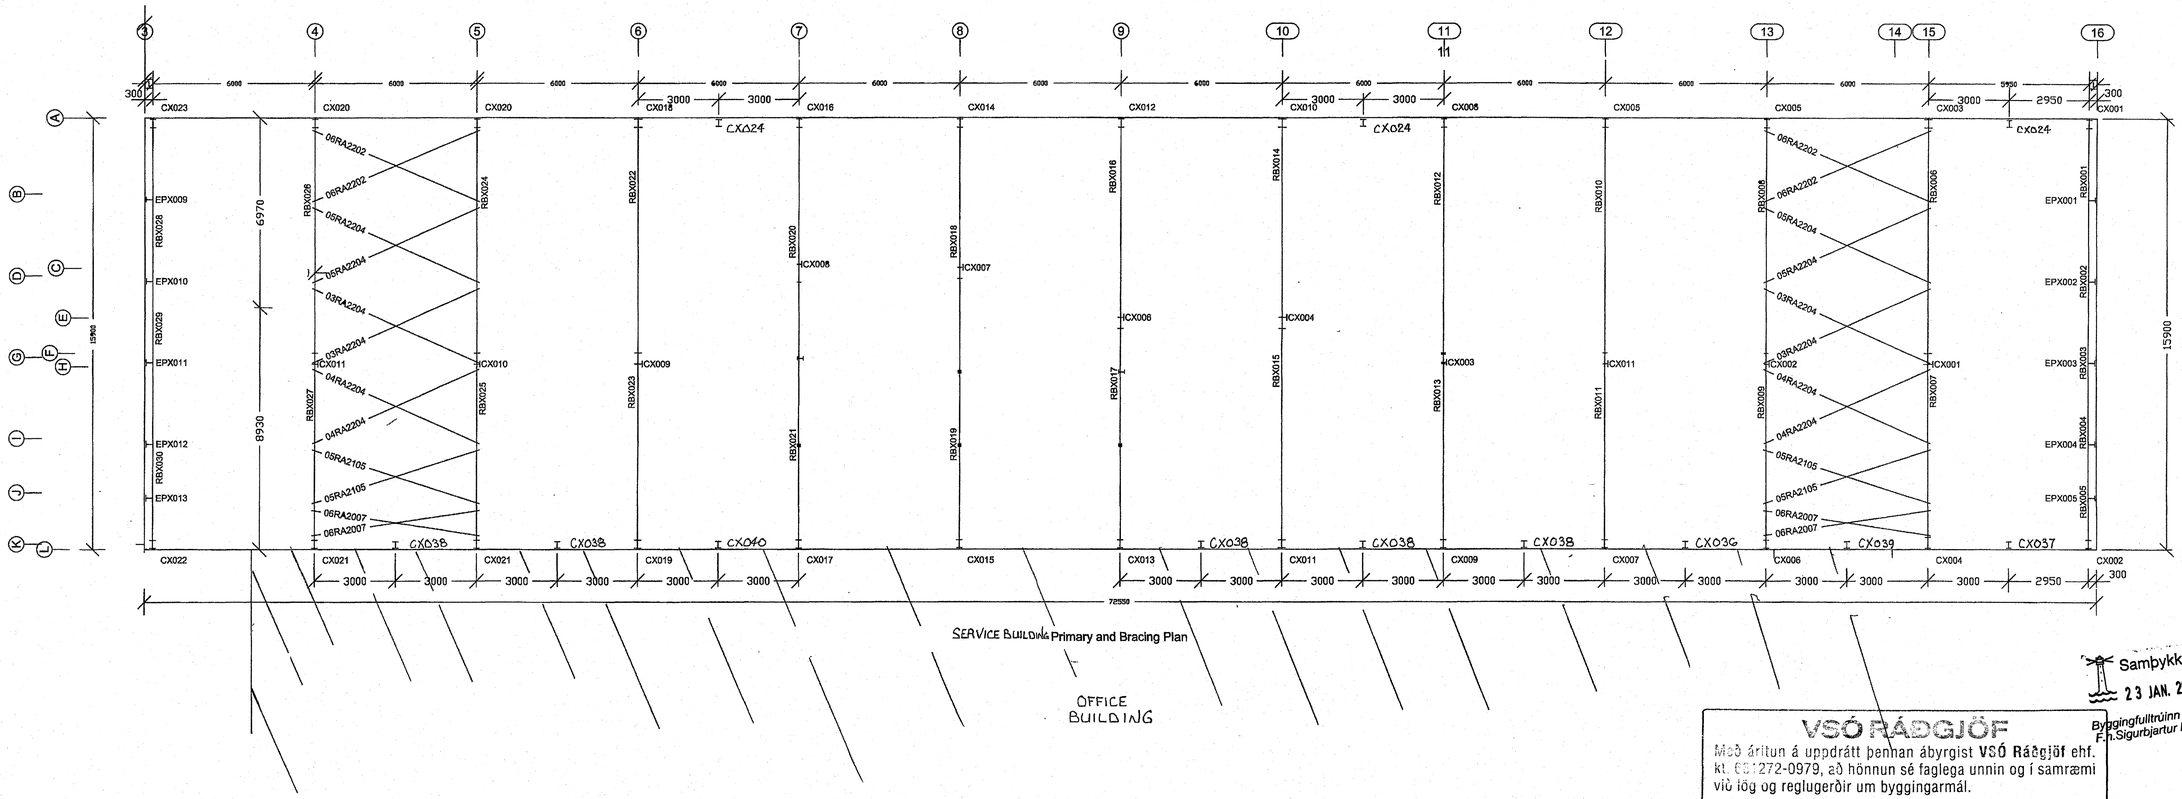

THE VP ENGINEER'S SEAL APPLIES ONLY TO THE WORK PRODUCT OF VP AND DESIGN AND PERFORMANCE REQUIREMENTS SPECIFIED BY VP. THE VP ENGINEER'S SEAL DOES NOT APPLY TO THE PERFORMANCE OR DESIGN OF ANY OTHER PRODUCT OR COMPONENT FURNISHED BY VP EXCEPT TO ANY DESIGN OR PERFORMANCE REQUIREMENTS SPECIFIED BY VP.

THIS DRAWING, INCLUDING THE INFORMATION HEREON, REMAINS THE PROPERTY OF VP BUILDINGS.

IT IS PROVIDED SOLELY FOR ERECTING THE BUILDING DESCRIBED IN THE APPLICABLE PURCHASE ORDER AND SHALL NOT BE MODIFIED, REPRODUCED OR USED FOR ANY OTHER PURPOSE WITHOUT PRIOR WRITTEN APPROVAL OF VP BUILDINGS.

THE GENERAL CONTRACTOR AND/OR ERECTOR IS SOLELY RESPONSIBLE FOR ACCURATE, GOOD QUALITY WORKMANSHIP IN ERECTING THIS BUILDING IN CONFORMANCE WITH THIS DRAWING, DETAILS REFERENCED IN THIS DRAWING, ALL APPLICABLE VP ERECTION GUIDES, AND INDUSTRY STANDARDS PERTAINING TO PROPER ERECTION, INCLUDING THE CORRECT USE OF TEMPORARY BRACING.

VP Buildings, Inc.
3200 Players Club Circle Memphis TN 38125

REV	DATE	BY	DESCRIPTION
1	07/11/2007	ELM	CHANGED TUBE BASE PLATES AT F.L. 3.8 & 10.8 FROM D20 TO D35

NTS

ANCHOR ROD PLAN

Norðurhella 2 · 221 Hafnarfjörður

Norðurhella 2 - Hafnarfirði
Súlur, þakbitar, stífingar
Yfirlitsmynd, verkstæðishl.
Bl. nr. 5

VP BUILDINGS
VARCO-PRUDEN

VPC VERSION: 5.6d

JOBNO	07-4487
DATE	7/10/2007
DRAWN/CHECK	DJS DJS
PAGE	5

6/26/2007 13:59:31

FILENAME: Hafnarfjordur 14.VPC

Verkfræðistofa Hauks Ásgeirssonar ehf.
Kt. 560600-3050
Dalvegi 18
201 Kópavogur
VHA

EYKT
26 OCT 2007
MÓTTEKIÐ

C:\DOCUMENTS AND SETTINGS\DSTRON PAGE 1 - 8/22/2007 4:23:26 PM