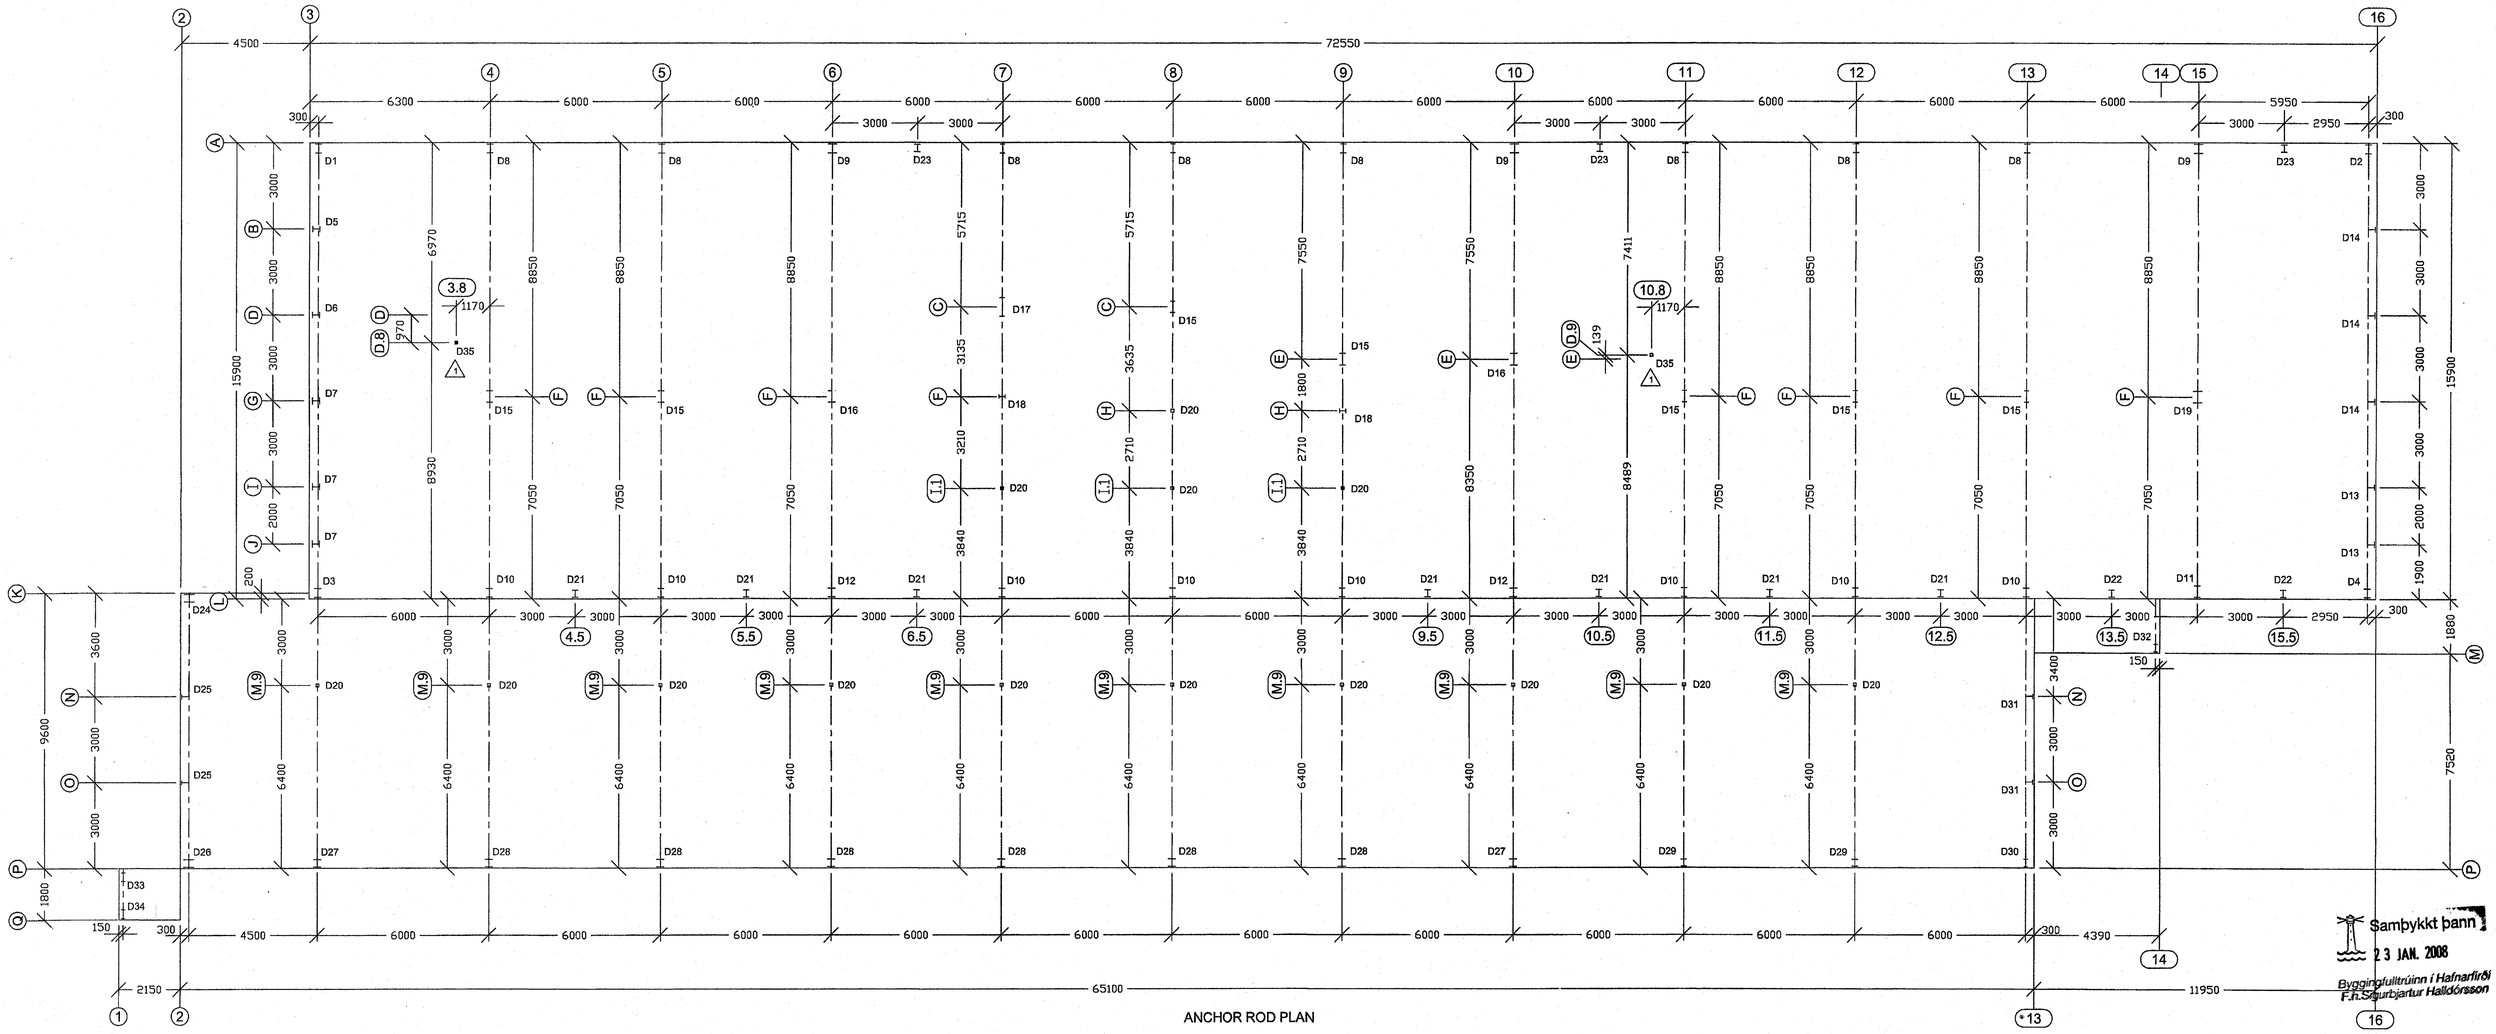


ANCHOR ROD PLAN

Samþykkt þann
23 JAN. 2008
Byggingafulltrúinn í Hafnarfirði
F.h. Sigurbjartur Halldórsson

VSÓ RÁÐGJÖF
Með áritun á uppdrátt þennan ábyrgist VSÓ Ráðgjöf ehf. kt. 631272-0979, að hönnun sé faglega unnin og í samræmi við lög og reglugerðir um byggingarmál.

Dags. Nafn Kennitala

FOR CONSTRUCTION

Finished Floor Elevation = 100000 (Unless Noted Otherwise)

THE VP ENGINEER'S SEAL APPLIES ONLY TO THE WORK PRODUCT OF VP AND DESIGN AND PERFORMANCE REQUIREMENTS SPECIFIED BY VP. THE VP ENGINEER'S SEAL DOES NOT APPLY TO THE PERFORMANCE OR DESIGN OF ANY OTHER PRODUCT OR COMPONENT FURNISHED BY VP EXCEPT TO ANY DESIGN OR PERFORMANCE REQUIREMENTS SPECIFIED BY VP.

THIS DRAWING, INCLUDING THE INFORMATION HEREON, REMAINS THE PROPERTY OF VP BUILDINGS.
IT IS PROVIDED SOLELY FOR ERECTING THE BUILDING DESCRIBED IN THE APPLICABLE PURCHASE ORDER AND SHALL NOT BE MODIFIED, REPRODUCED OR USED FOR ANY OTHER PURPOSE WITHOUT PRIOR WRITTEN APPROVAL OF VP BUILDINGS.

THE GENERAL CONTRACTOR AND/OR ERECTOR IS SOLELY RESPONSIBLE FOR ACCURATE, GOOD QUALITY WORKMANSHIP IN ERECTING THIS BUILDING IN CONFORMANCE WITH THIS DRAWING, DETAILS REFERENCED IN THIS DRAWING, ALL APPLICABLE VP ERECTION GUIDES, AND INDUSTRY STANDARDS PERTAINING TO PROPER ERECTION, INCLUDING THE CORRECT USE OF TEMPORARY BRACING.

VP Buildings, Inc.
3200 Players Club Circle Memphis TN 38125

| REV | DATE | BY | DESCRIPTION |
|---|---|---|---|
| 1 | 07/11/2007 | ELM | CHANGED TUBE BASE PLATES AT F.L. 3.8 & 10.8 FROM D20 TO D35 |

NTS

6/26/2007 13:59:31

ANCHOR ROD PLAN

Norðurhella 2 · 221 Hafnarfjörður

Norðurhella 2 - Hafnarfirði
Bolta- og súluplan
Grunnmynd
Bl. nr. 3

VP BUILDINGS
VARCO-PRUDEN

VPC VERSION: 5.6d

JOBNO 07-4487
DATE 7/10/2007
DRAWN/CHECK ELM DAW
PAGE 3

FILENAME: Hafnarfjordur 14.VPC

Verkfræðistofa Hauks Ásgeirssonar ehf.
Kt. 560600-3050
Dalvegi 18
201 Kópavogur

VHA

EYKT
26 OCT 2007
MÓTTEKIÐ