
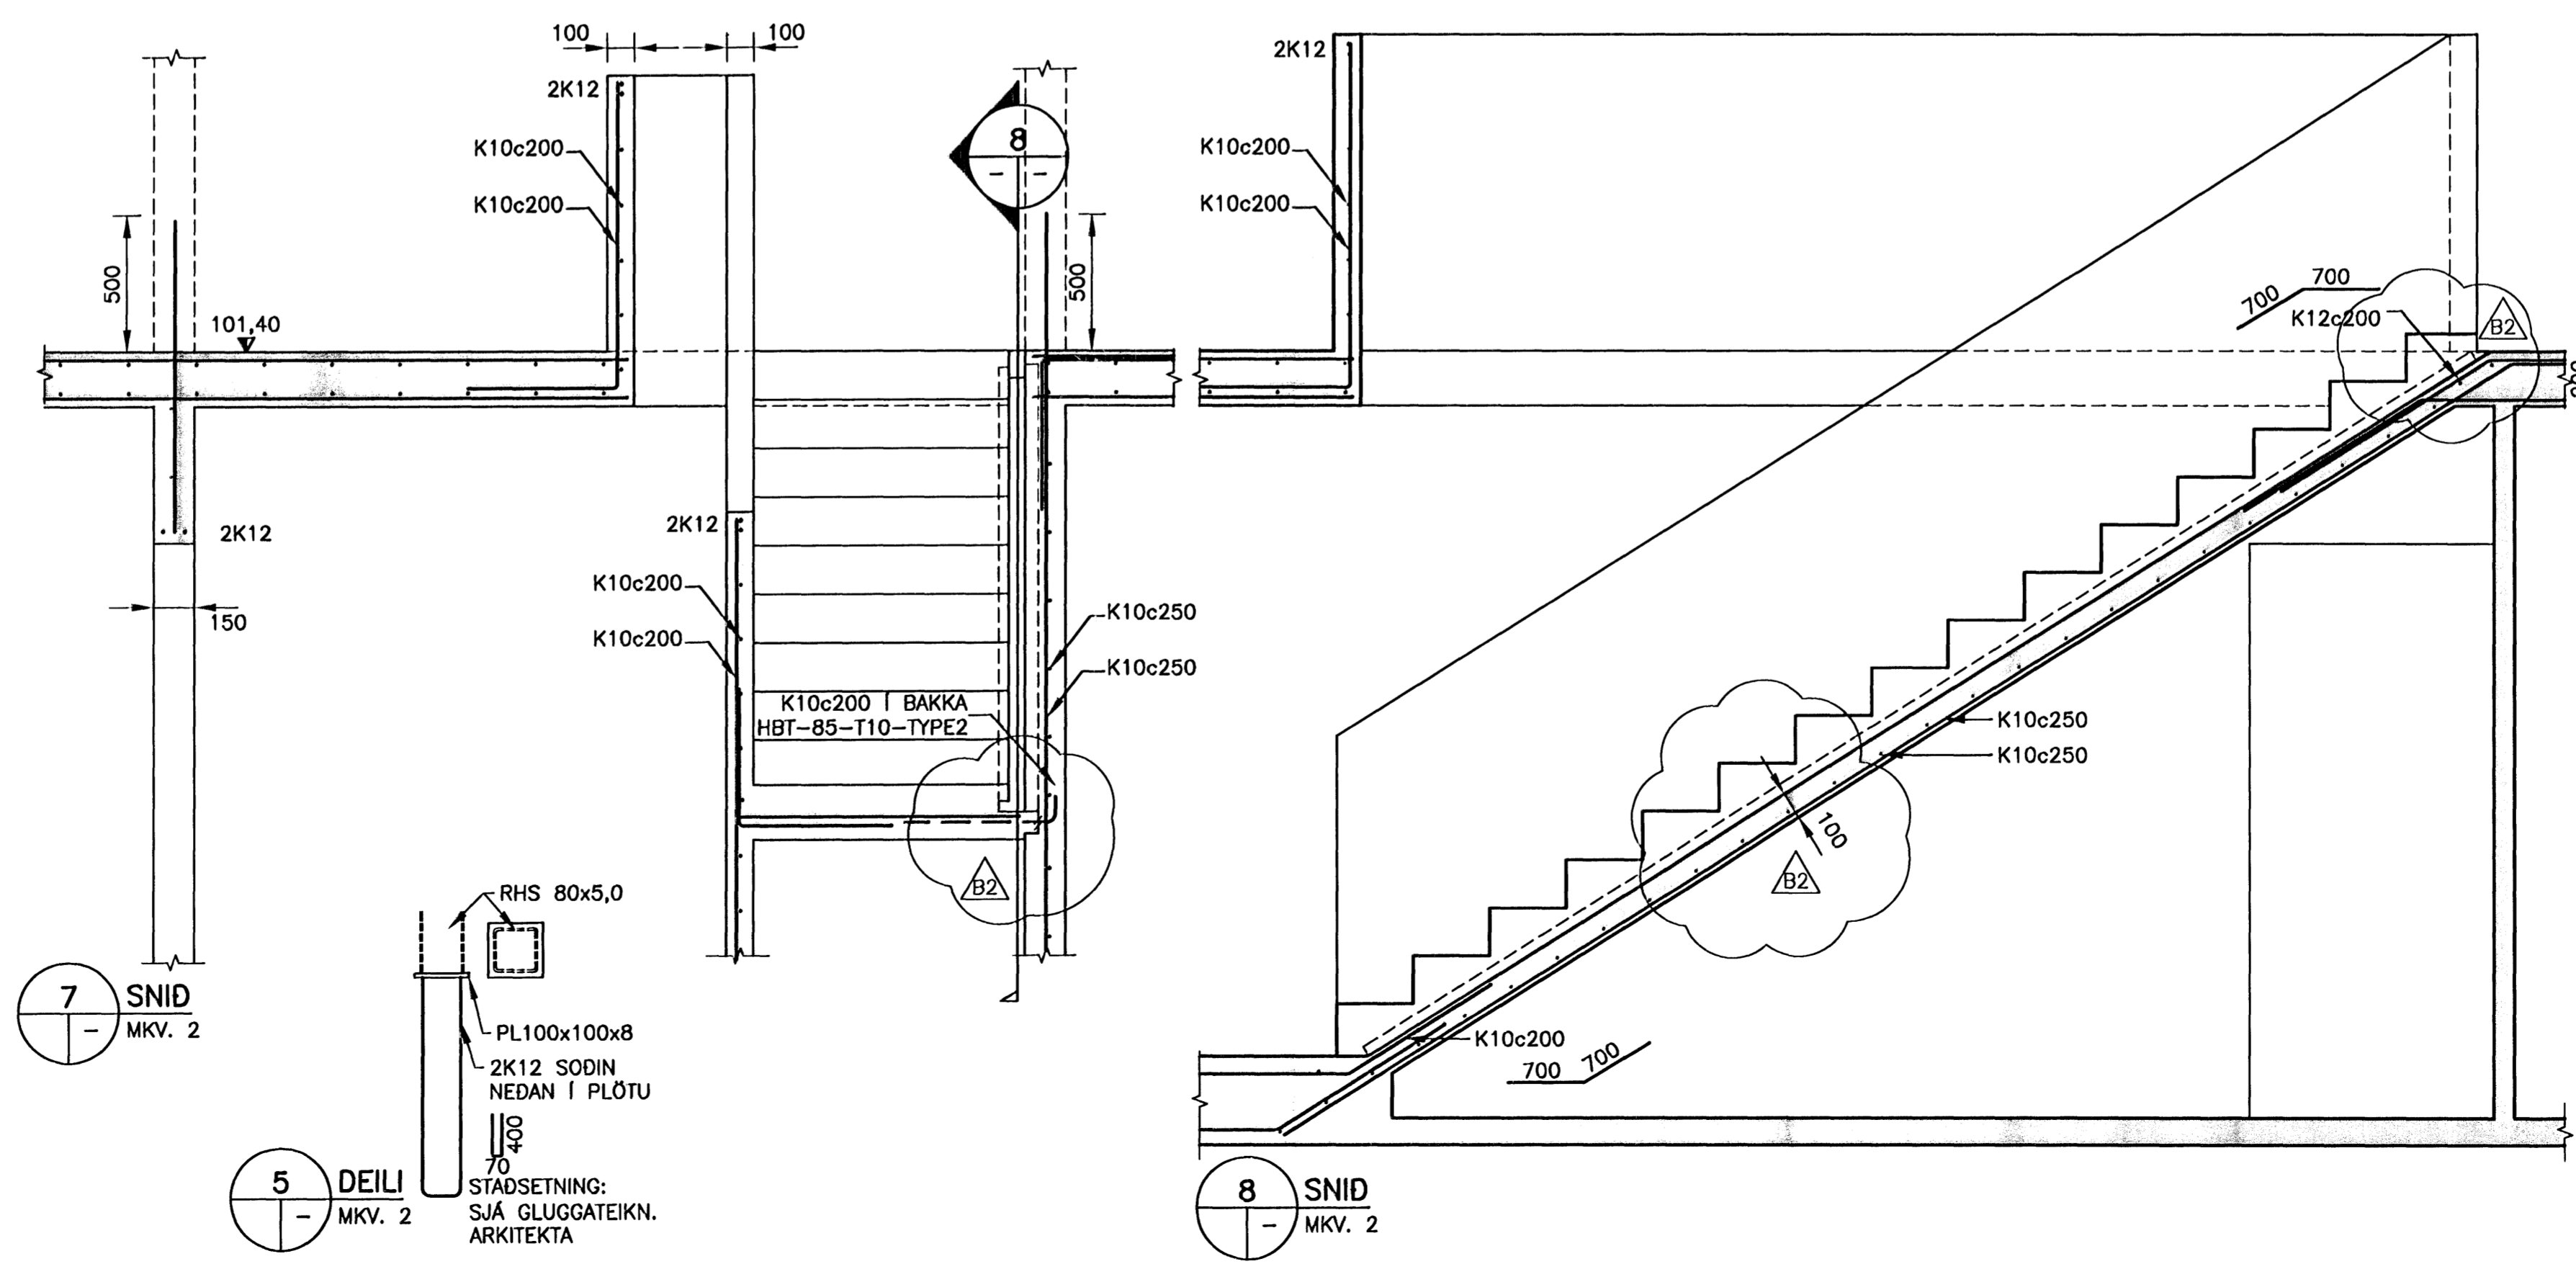


GRUNNMYND MKV. 1



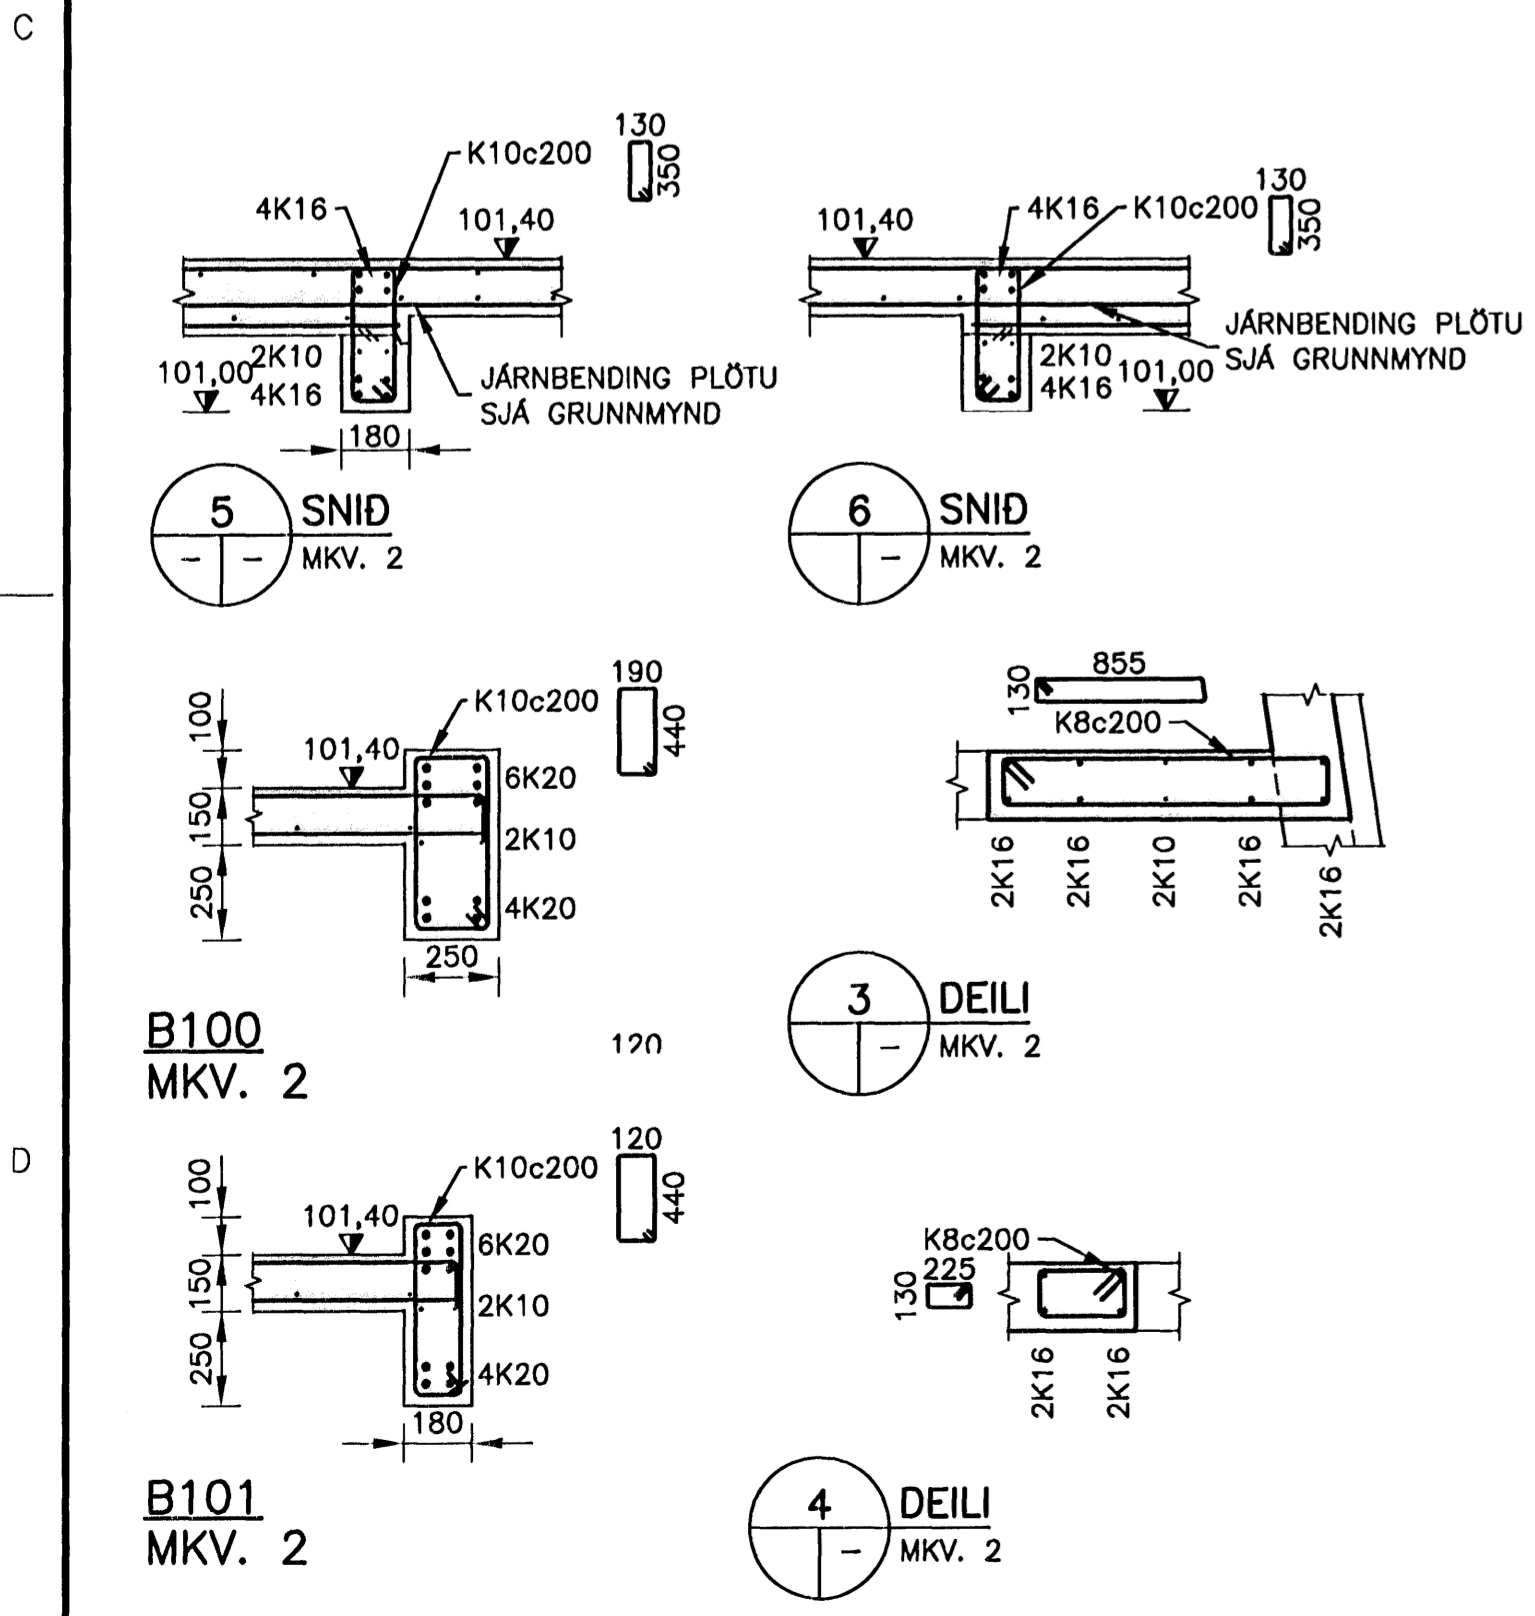


ÓTGÁFUFERILL			
NÚMÉR:	DAGS:	SKÝRINGAR:	HANNAÐ:
B1	30.07.2007	BYGGINGARTEIKNING	JSP
B2	24.10.2007	YMSAR BREYTINGAR	JSP

DAGS. UNDRSKRIFTAR: *24.10.2007* NAFN OG KT. SAMREINGARHÖNNUNAR: *VGK-HÖNNUN hf*
 UNDRSKRIFT SAMREINGARHÖNNUNAR: *VGK-HÖNNUN hf*

SKÝRINGAR:
 FYRIR INNSTEYPTAR LAGNIR, SJÁ LAGNATEIKNINGAR.
 FYRIR ALMENNAR SKÝRINGAR, SJÁ TEIKNINGU B100.

Sambýkkt þann
 27 NOV. 2007
 Bygginguflutránn í Hafnarfirði
 F.h. Sigurbjartur Halldórsson

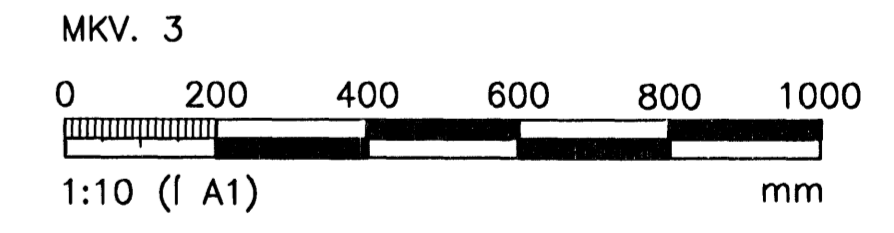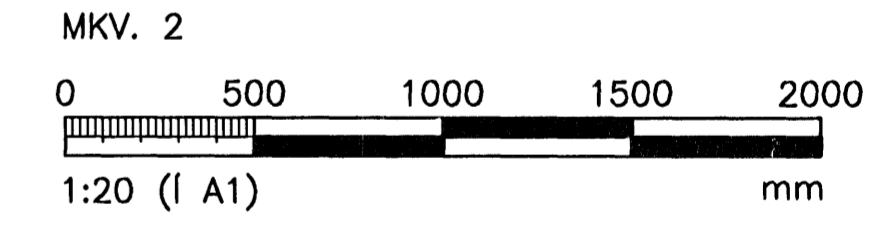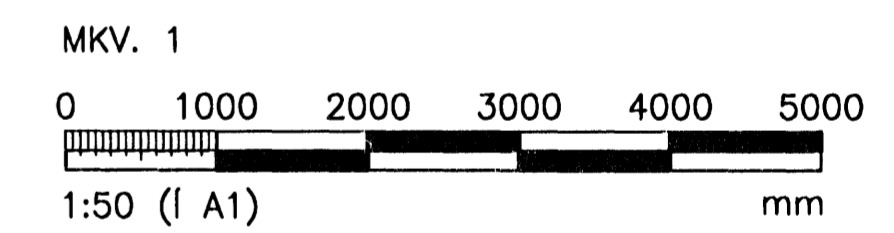

ÖLL AFNOT OG AFRITUN TEIKNINGAR, AD HLUTA EDA HEILD, ER HAD SKRIFLEGGU LEYFI HÖFUNDNA.

VGK HÖNNUN
 GRENSÁSVEGI 1 · 108 REYKJAVÍK · Sími: 422 3000 · FAX: 422 3001
 VEFANG: www.vgkhonnun.is · NETFANG: vgkhonnun@vgkhonnun.is

HEITI TEIKNINGAR:
SKÓGARÁS F
 ÁSLANDI, HAFNARFIRÐI

HEITI TEIKNINGAR:
BURDARVIRKI:
 VEGGIR 1. HÆÐAR OG MILLIPLATA
 GRUNNMYND OG SNID

MELI:	TEIKNAR:	GEYMSLUNÚMÉR:	VNR:
HANNAÐ:	JSP		3.151.231
YRIFARÐ:	JSP	MKV: 1:50 1:20	NR. TEIKNINGAR:
DAGS. UNDRSKRIFTAR:	24.10.07	NAFN OG KT. HÖNNUNAR:	B102
UNDRSKRIFT HÖNNUNAR:	<i>VGK-HÖNNUN hf</i>	ÓTGÁFA:	B2