


G: 08.10.2007 Reynartekningar
F: 7.2.2006 Nurðum í lagnatöskum snúð
E: 19.12.2005 Innra skipulagi breytt
C:
B: 25.07.2005
A: 08.11.2004

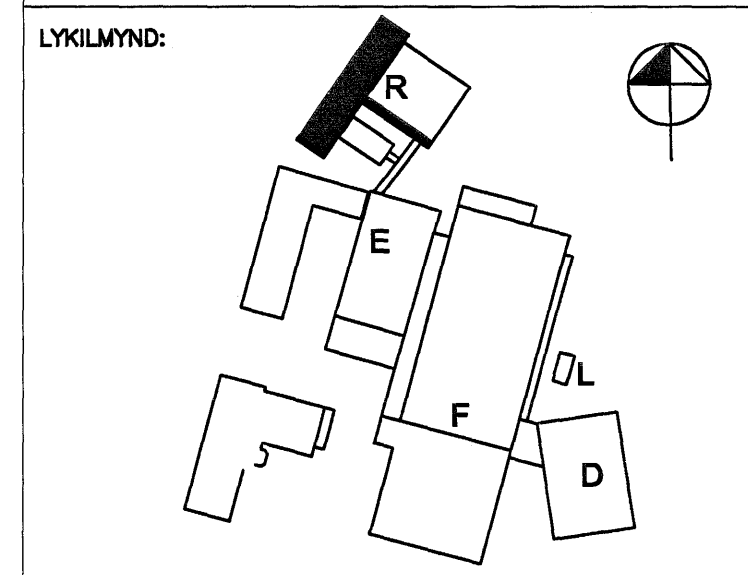

VERKKAUPLI:
actavis
REYKJAVÍKURVEGUR 80,
R-BAÐNÁSÓNARHÖG

REYNDARTEIKNINGAR
4.HÆÐ
VERK: DAGS: 21.10.2004
KVAÐI: 1:50 TEKNAD: JPP
SKRÁ: .DWG

ÚTI INNI
ARKITEKTAR
ÞINGHOLTSTRÆTI 27 101 REYKJAVÍK
SÍMAR 5527660 & 5527660 FAK 5527661
NETFANG: u@u.is
VEFANG: http://www.u.is
BALDUR Ó. SVAVARSSON ARKITEKTAR FAI
JÓN ÞÓR ÞORVALDSSON ARKITEKTAR FAI
TEIKNINGARNR: **A-R-204** BREYTINGAR: **G**