


LYKILMYND M1:1000

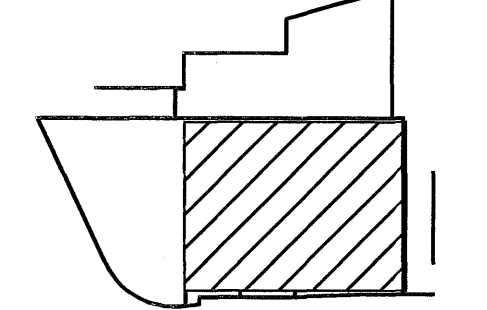

Byggingarfulltrúin Linnarjörður
 Ágúst Þórunn
 29. NOV. 2005

ÁRITUN BYGGINGARFULLTRÚA
 101/101-2768

SJÁ SKÝRINGAR Á TEIGN NR. -7-01 OG -7-02

B	22.11.05	REYNDARTEIKNING	
A	15.10.05	LOFTI BREYTT	
NR.	DAGS.	BREYTING	SAMP.

ferill
 VERKFRÆÐISTOFA

TJARNARVELLIR 15 HAFNARFJÖRÐUR

VATNSÚÐAKERFI
 GRUNNMYND 2. HLUTI
 INNRÝMI

MKV	1:50	TEIGN	DAGS ÚTG.	TEIGN NÚMÉR
ÁRITUN BYGGINGARFULLTRÚA		DAG	12.09.05	1061-7-04
HÖNNUNUR		KT		SAMPYKKT
HÖNNUNUR BREYTINGAR		DAGS BREYTINGAR	22.11.05	BREYTING NR.
				B