

KERFI 9

Table with columns: Nr., Tæki, Staðsetning, Hlutverk, Tegund/Umboð, Gerð/afköst. Contains technical specifications for various electrical components like switches, relays, and control units.

KERFI 9


Table with columns: Nr., Tæki, Staðsetning, Hlutverk, Tegund/Umboð, Gerð/afköst. Contains technical specifications for various electrical components like relays, contactors, and control units.

KERFI 11

Table with columns: Nr., Tæki, Staðsetning, Hlutverk, Tegund/Umboð, Gerð/afköst. Contains technical specifications for various electrical components like relays, contactors, and control units.

KERFI 12

Table with columns: Nr., Tæki, Staðsetning, Hlutverk, Tegund/Umboð, Gerð/afköst. Contains technical specifications for various electrical components like relays, contactors, and control units.

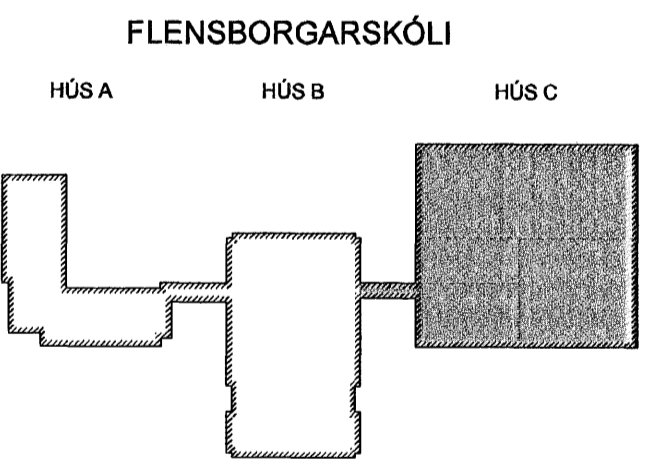

A 02.08 SVÆRD Á HITURUM BS / SAS

Úng. Dags. Skýring Hannabeyri/rið

VSB

VERKFRÆDISTOFA

BAEJRAHRAUNI 20 · 220 HAFNARFJÖRÐUR · KENNIT. 710795-2899

Administrative form containing project details, dates, and signatures. Includes fields for 'Sampykkt þann', date '09 MAI 2008', and a signature.