


SELHELLA

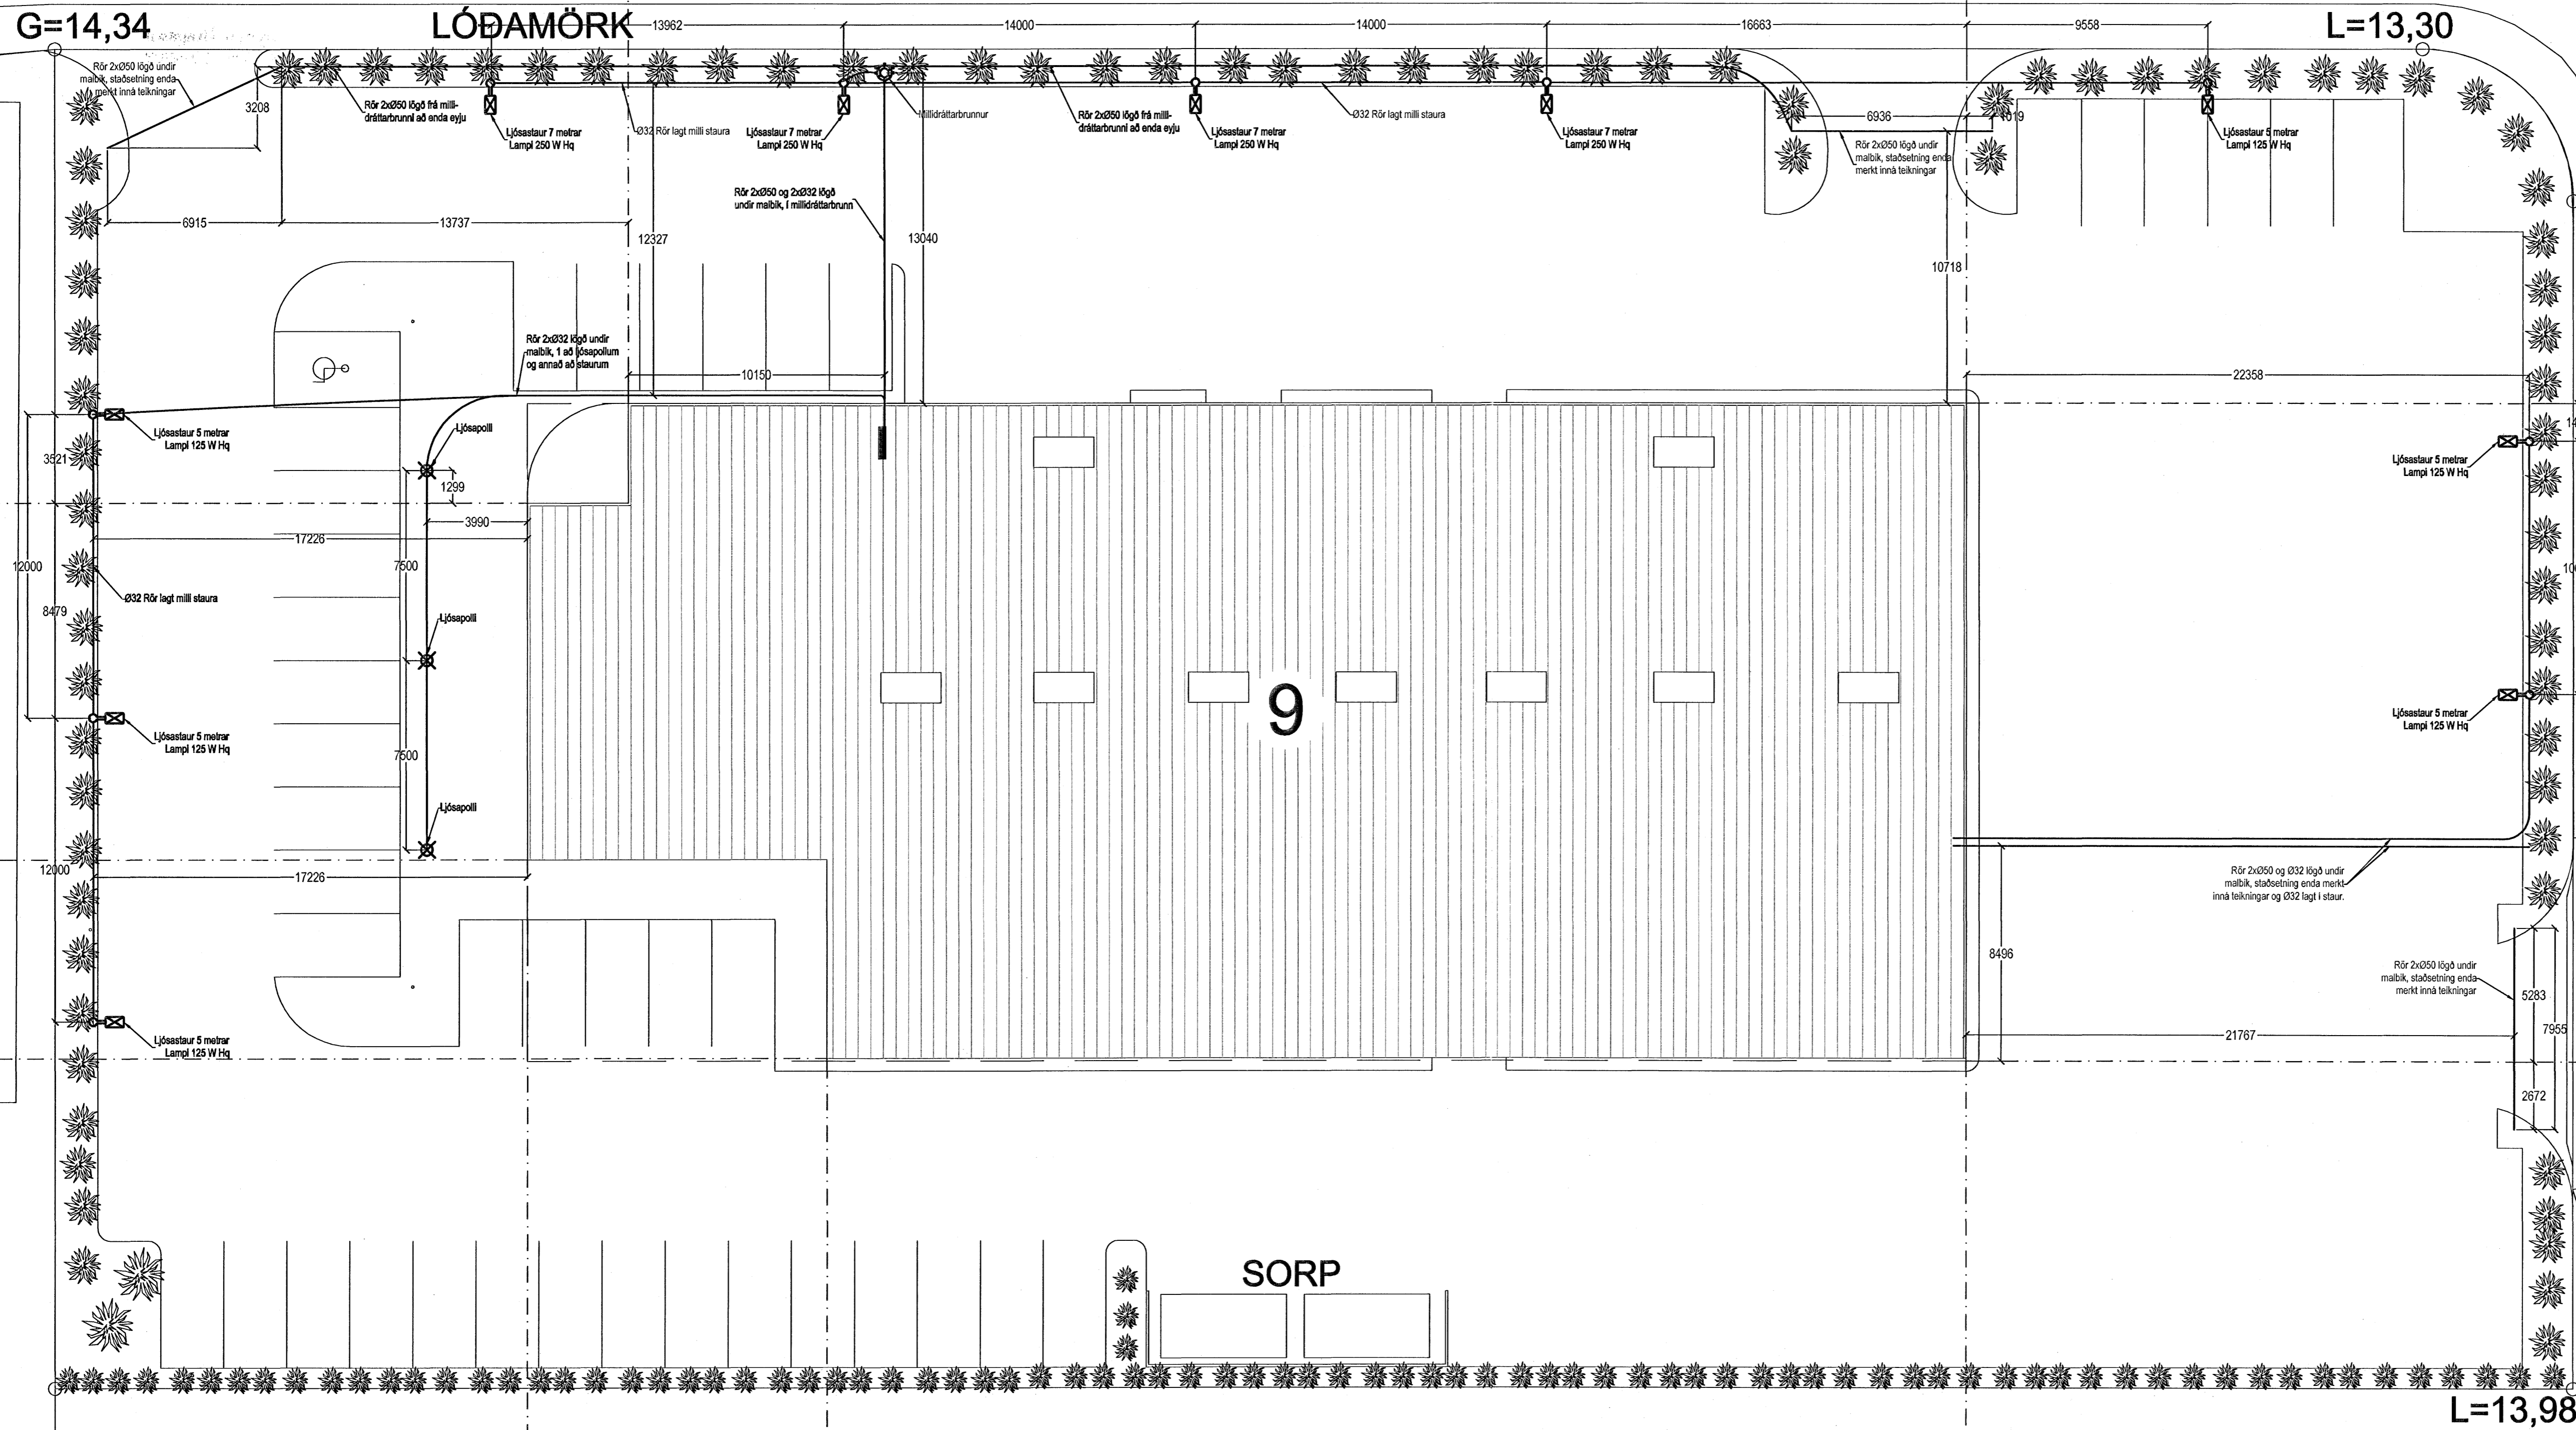

Hönnuður:
DES
Yfirfarir:
Magnús Mathiasson
Samþykkt: Davíð Sólvason
Kt. 280455-4909
kt. 100356-3336

Breytingar:

Aðalhönnuður: *gy*

Fedex - hraðflutningar
Selhella 9
221 Hafnafjörður

Raflagnir í lóð

Mkv: 1:150

RTS
VERKFRÆÐISTOFA

Grensásvegur 3
108 Reykjavík
Sími 520 9900
Fax 520 9901
www.rts.is



28-2050-1-
06.07.2007
xx0401
A

V:\282050\malmakjup\A\02\fræðing_áskorun\282050-01.dwg, vsk01, 13.7.2007 13:24:13, hsk