


SNID F:F

Byggingafulltrúi Hafnarjarðar
 Algreitt þann
 05. DES. 2005

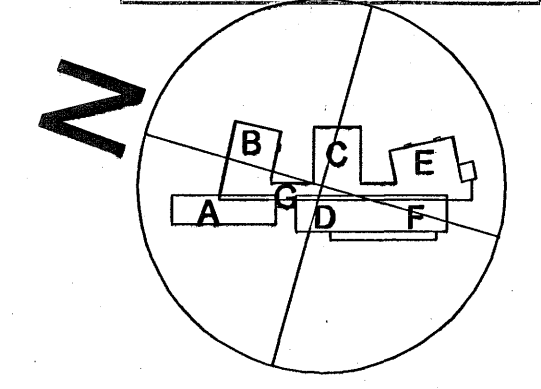

A - 28.11.2004. Inngangur aðir á milli Mjólkströy
 10. DMS. 05/11/04. HEKKA. EYKKA

á stofunni arkitektar
 Bergstaðastræði 10. Rvk. Sími 551 1460. Stofun@stofunni.is

| | |
|------------------------------------|-----------------------|
| Finnaur Björgvinsson, arkitekt FAI | KT: 180946-3069 |
| Hilmar Þór Björnsson, arkitekt FAI | KT: 200045-3109 |
| Sigríður Ólafsdóttir, arkitekt FAI | KT: 071070-5069 |
| DREKAVELLIR 9 | HAFNAR/TONN 19990 |
| HRAUNVALLASKOLI 1. AFANGI | AFL |
| SNID G-G | Stofnun |
| | KT: 660569-1399 |
| 05-01 | TEKNI NÚM. 01.05.2004 |
| | TEKNI NÚM. A-VS-005 |