



SÚÐURHLIÐ M 1 : 50

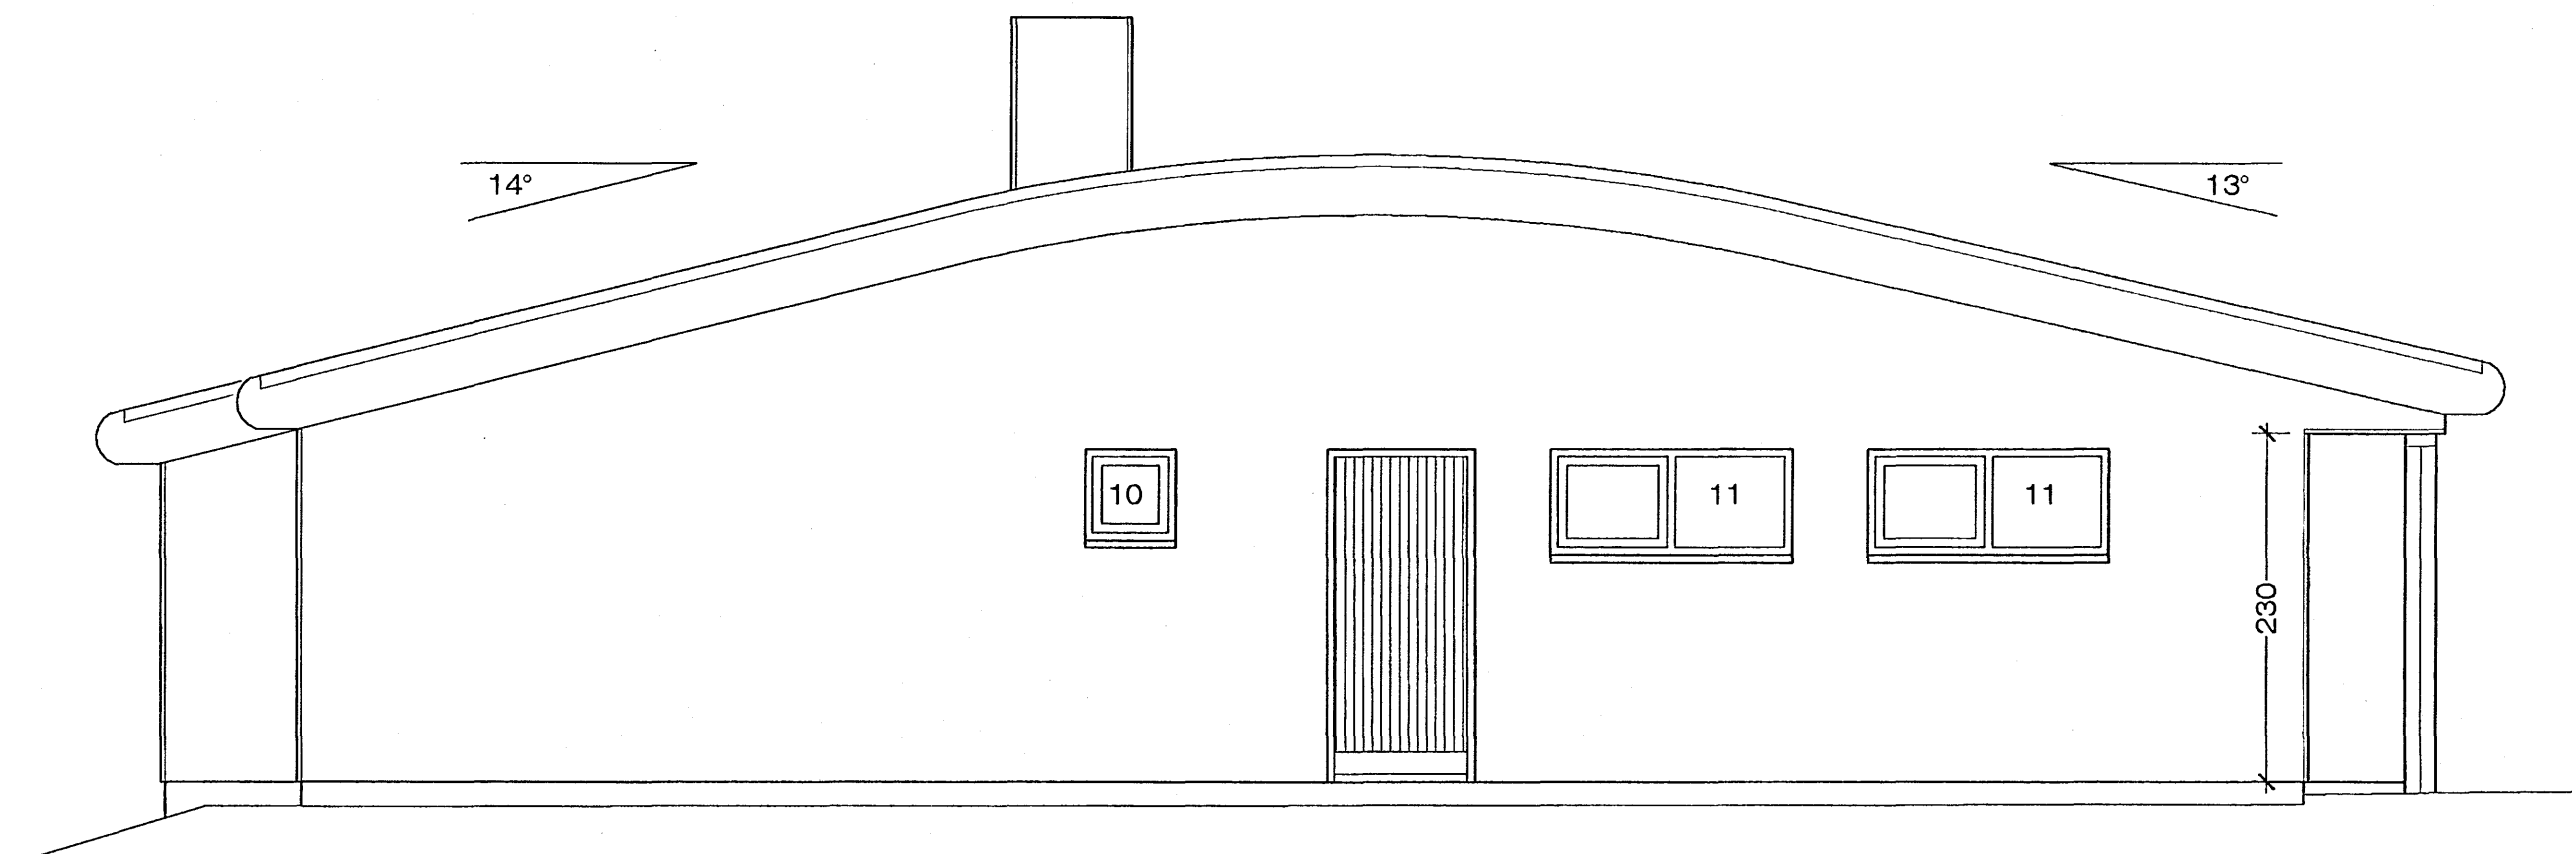

AUSTURHLIÐ M 1 : 50

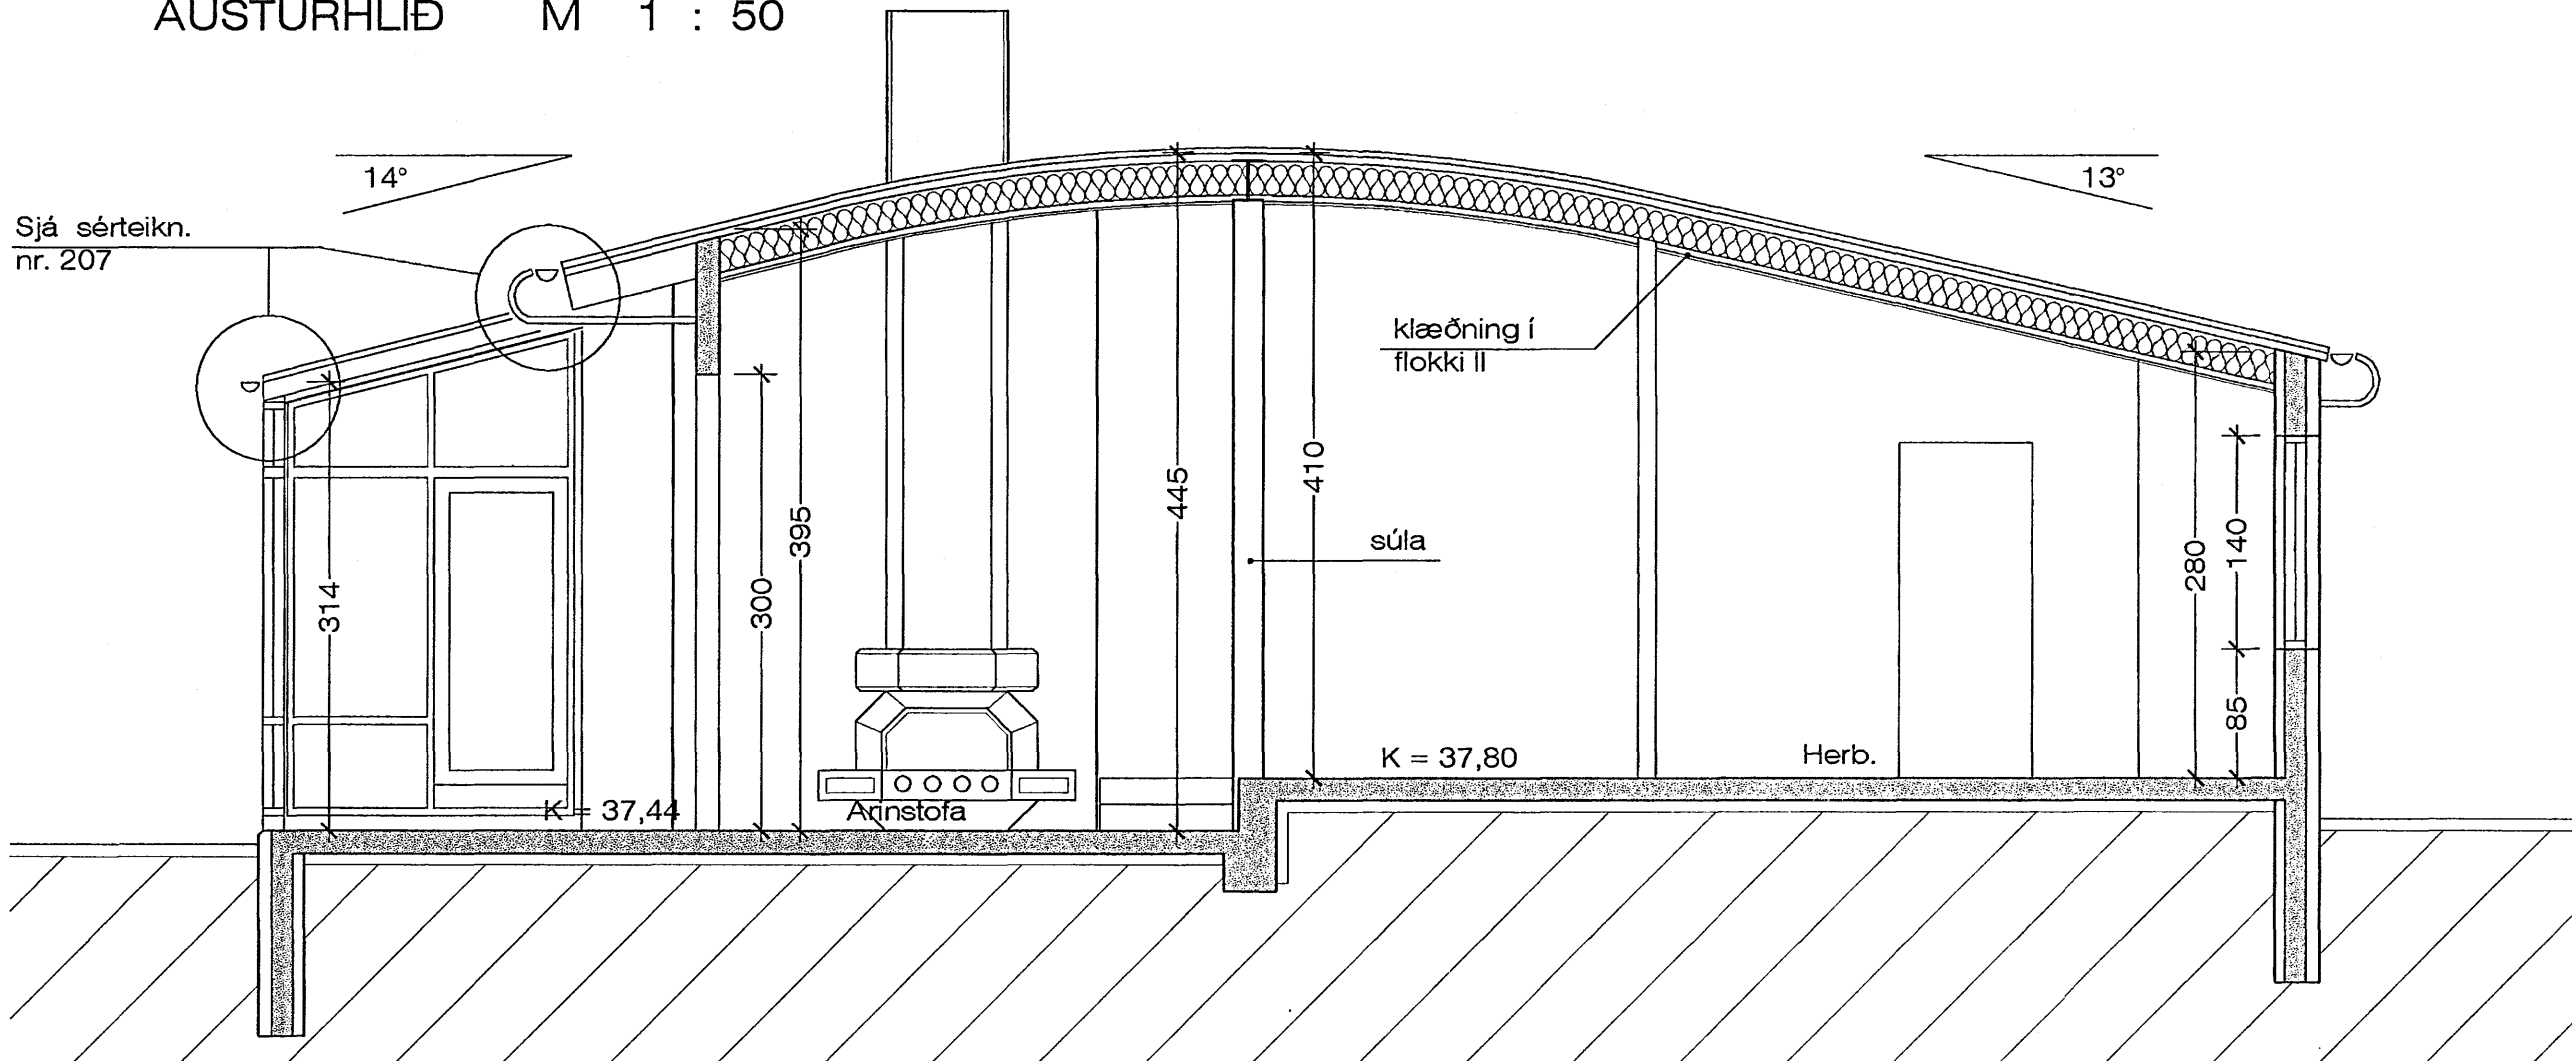

SNEIÐING B - B M 1 : 50



Breytt. 6. - 6. - 2006  
Breytt útlit á sólstofu.

SPÓAÁS 10, HAFNARFIRÐI ÚTLIT, SNIÐ

VERK. NR. 223      DAGS. 22.02.2000      MÁL. 1:50  
TEIKN. NR. 203      BREYTT. 6. - 6. - 2006

**JÓN GUÐMUNDSSON** ARKITEKT *Jón Guðmundsson* KT. 310551  
VINNUSTOFA. SKÚLAGÖTU 63 REYKJAVÍK. SÍMI 552 5055 3259

Jón Guðmundsson arkitekt. Suðurlandsbraut. 16 7.6.2006 11:09 sparm2001.dwg