



GRUNNMYND SÓLSTOFU M 1 : 20

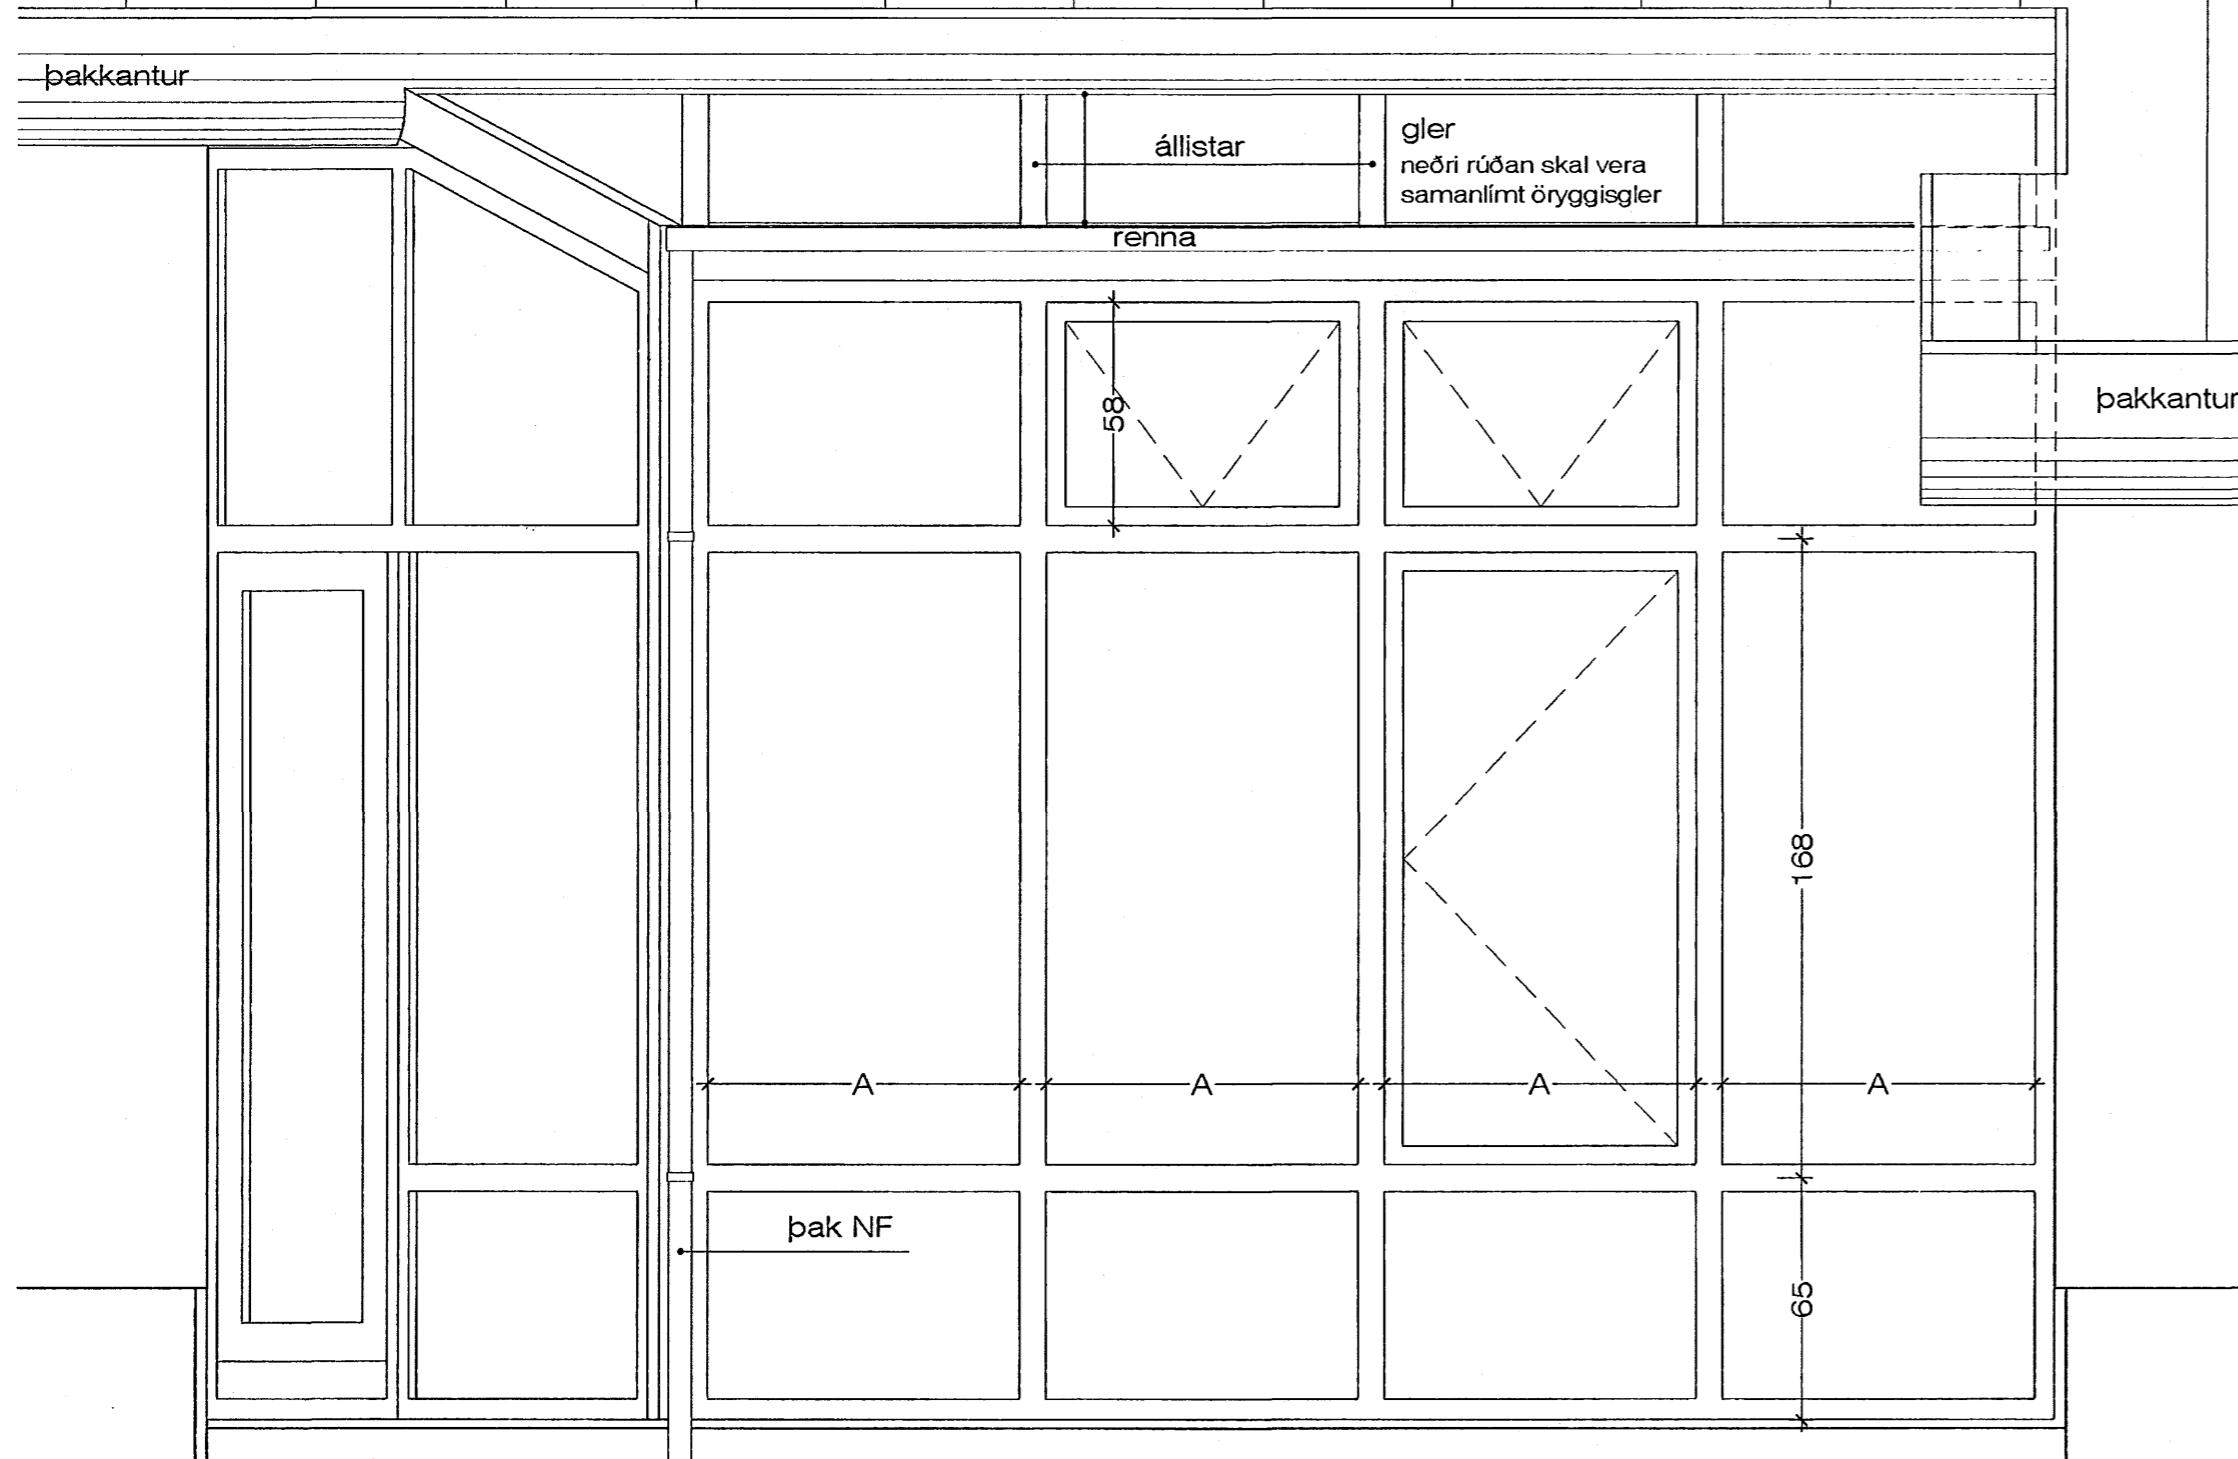

SÉD FRAMAN Á SÓLSTOFU M 1 : 20

Athuga skal öll utarmál á gluggakarmi á staðnum áður en smíði hefst

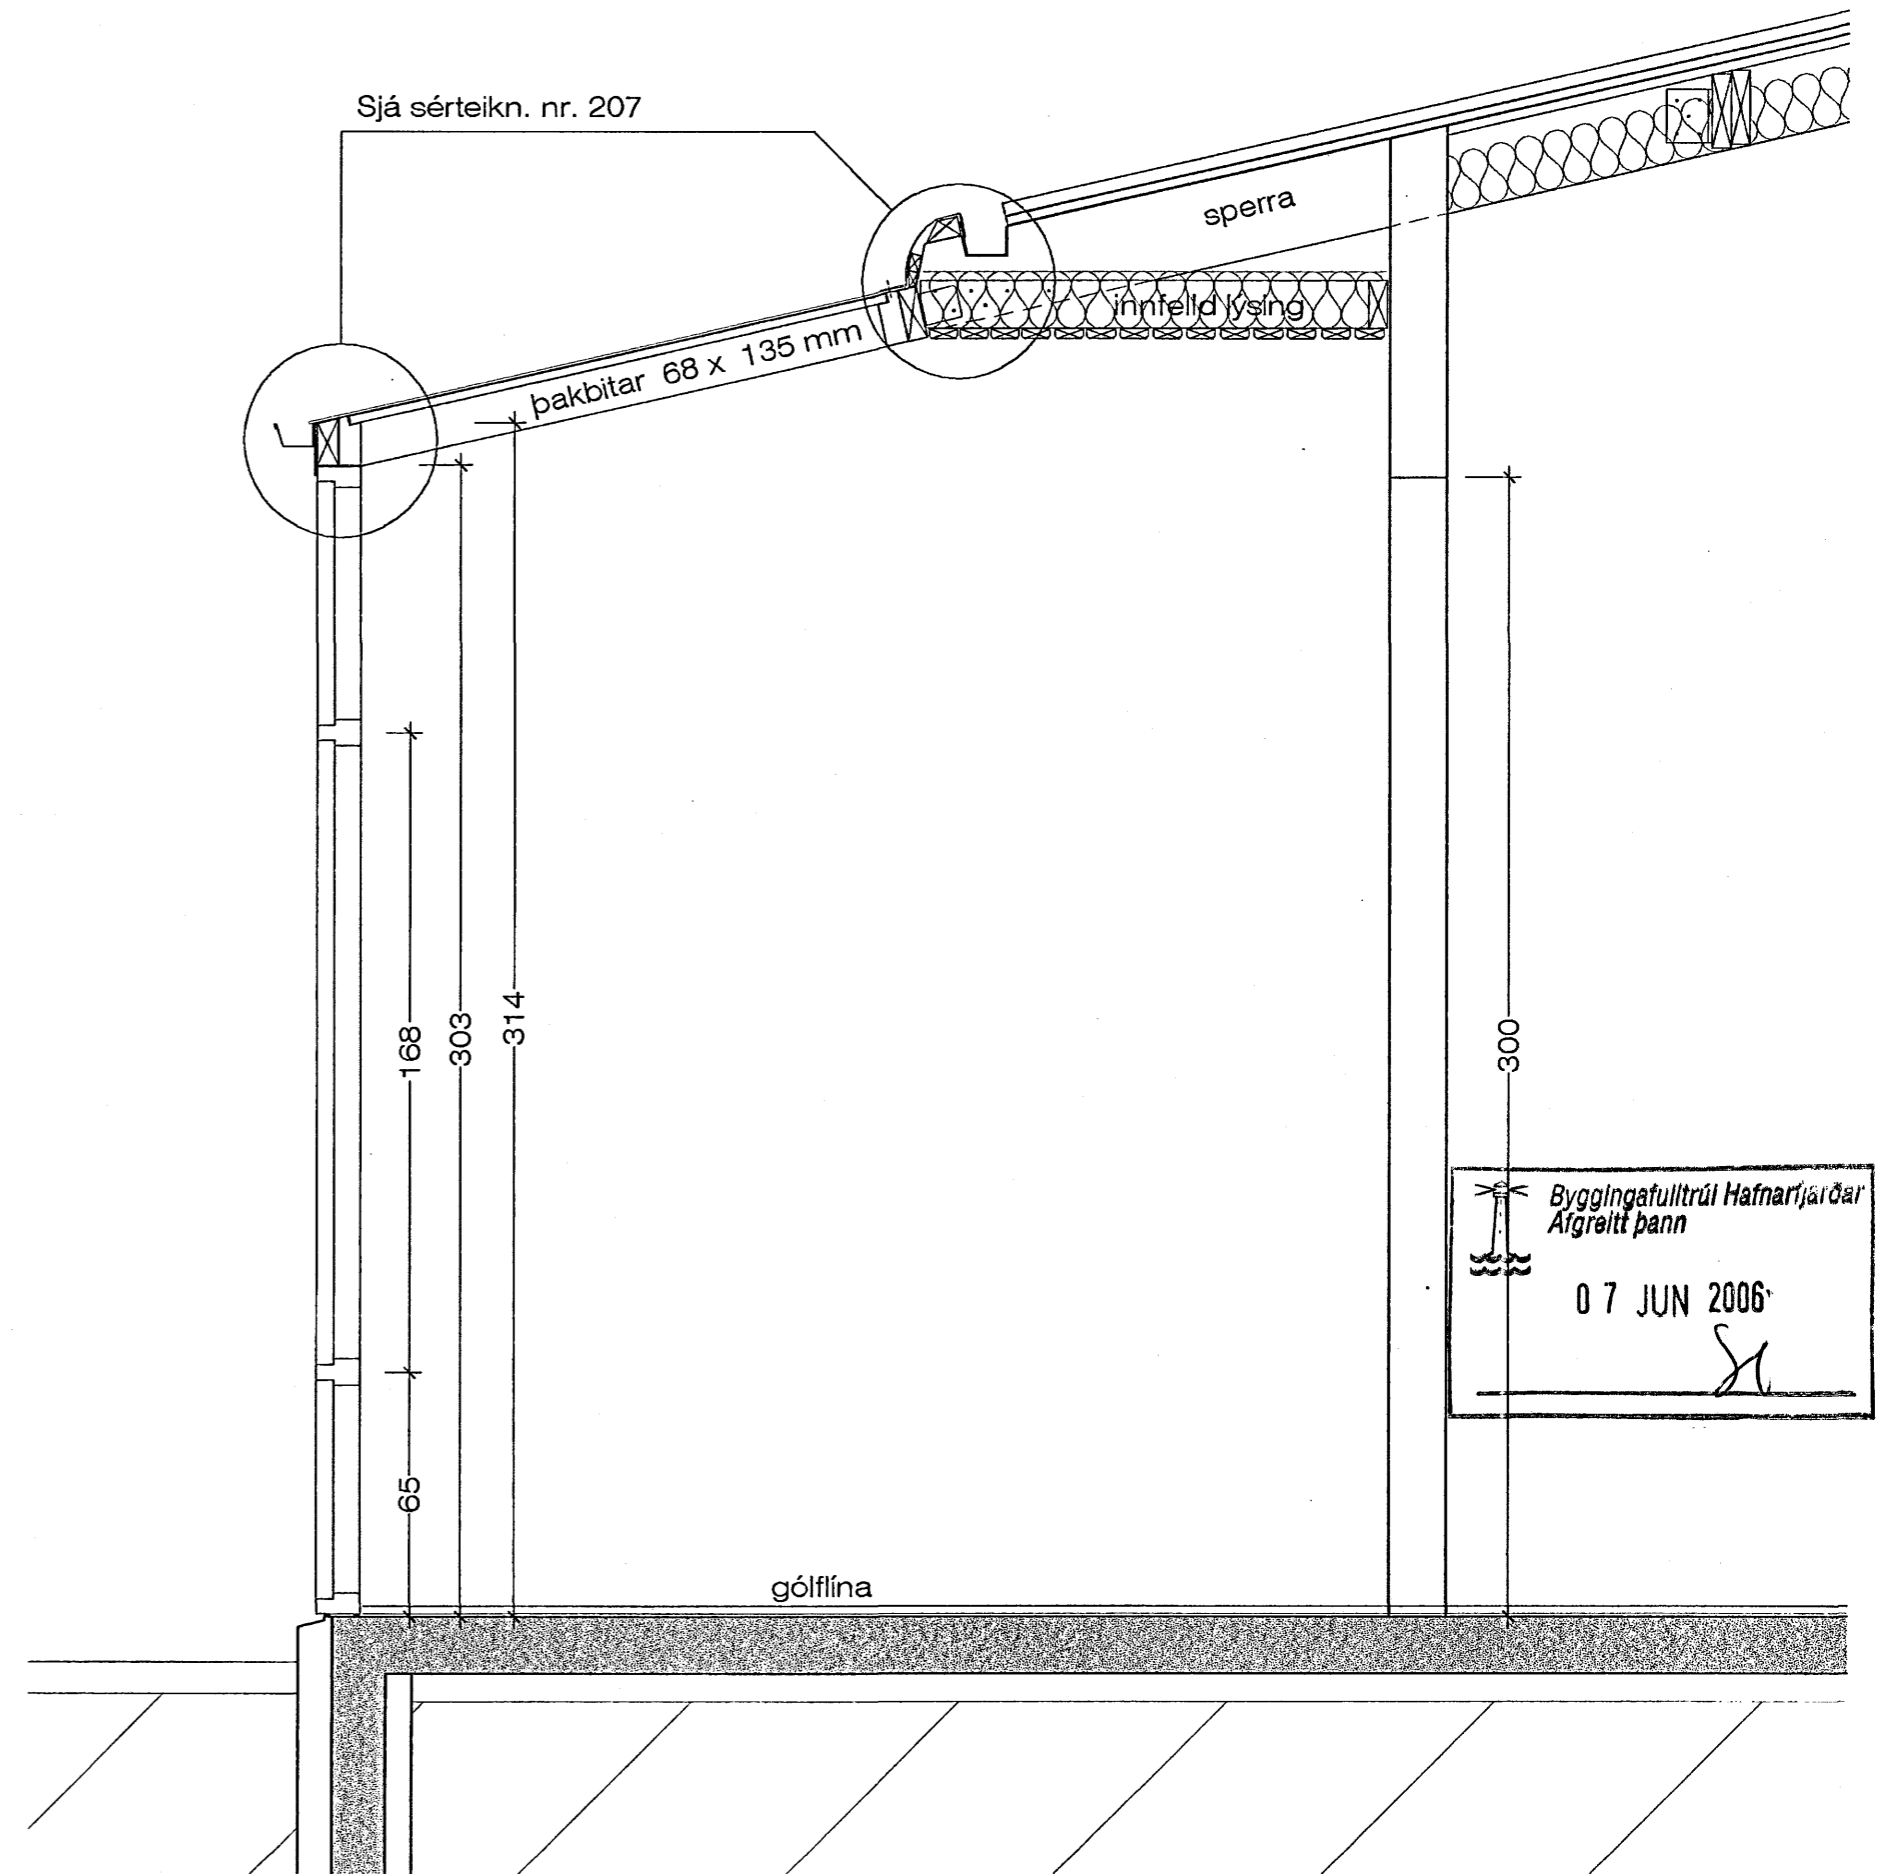

SNEIDING M 1 : 20

 Afgreitt þann
 07 JUN 2006
SJ

Breytt. 6. - 6. - 2006
 Breytt útlit á sólstofu.

SPÓAÁS 10, HAFNARFIRÐI SÓLSTOFA

VERK. NR. 223

DAGS. 22.02.2000

MÁL. 1:20

TEIKN. NR. 206

BREYTT. 6. - 6. - 2006

JÓN GUÐMUNDSSON ARKITEKTUR *Jón Guðmundsson* KT. 310551
 VINNUSTOFA. SKÚLAGÖTU 63 REYKJAVÍK. Sími 552 5055 3259