




Veggur 1

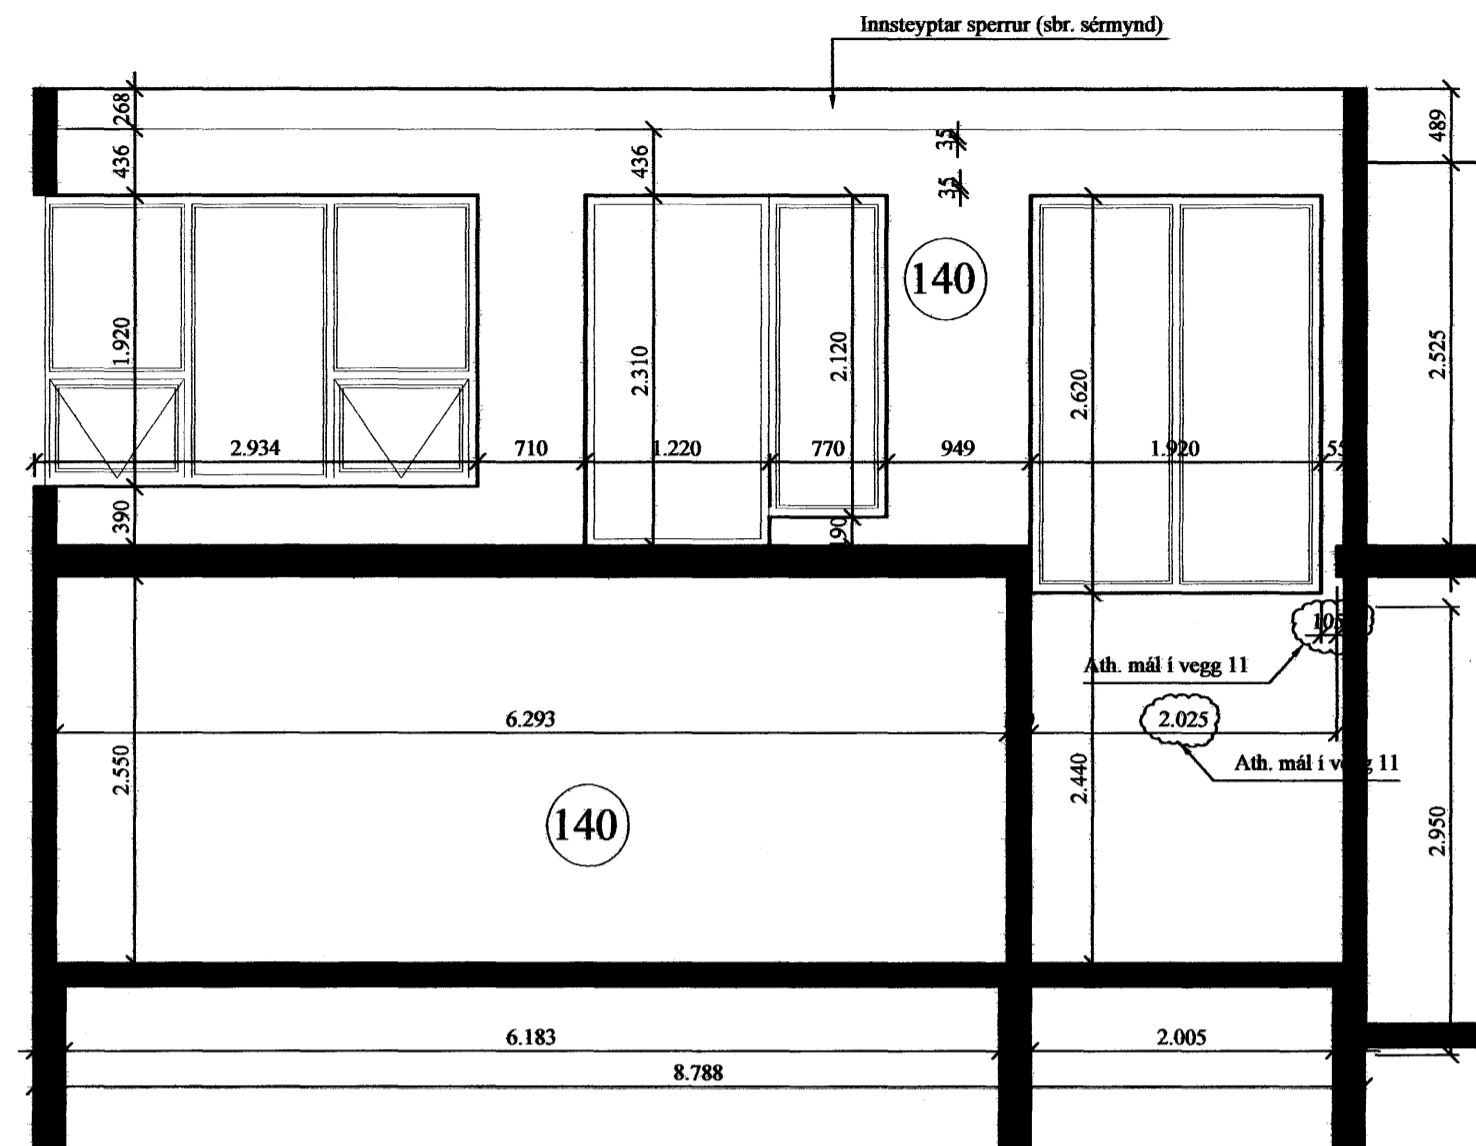

Veggur 2

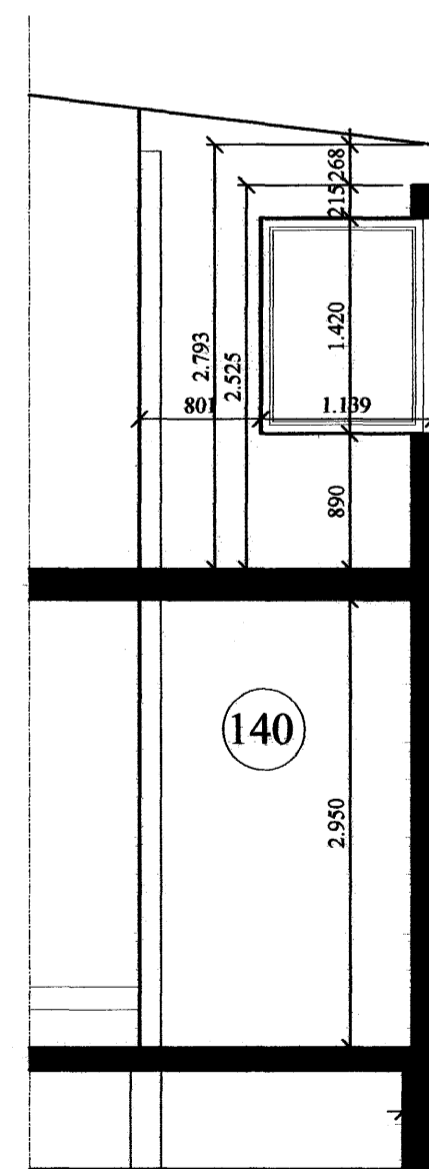

Veggur 3

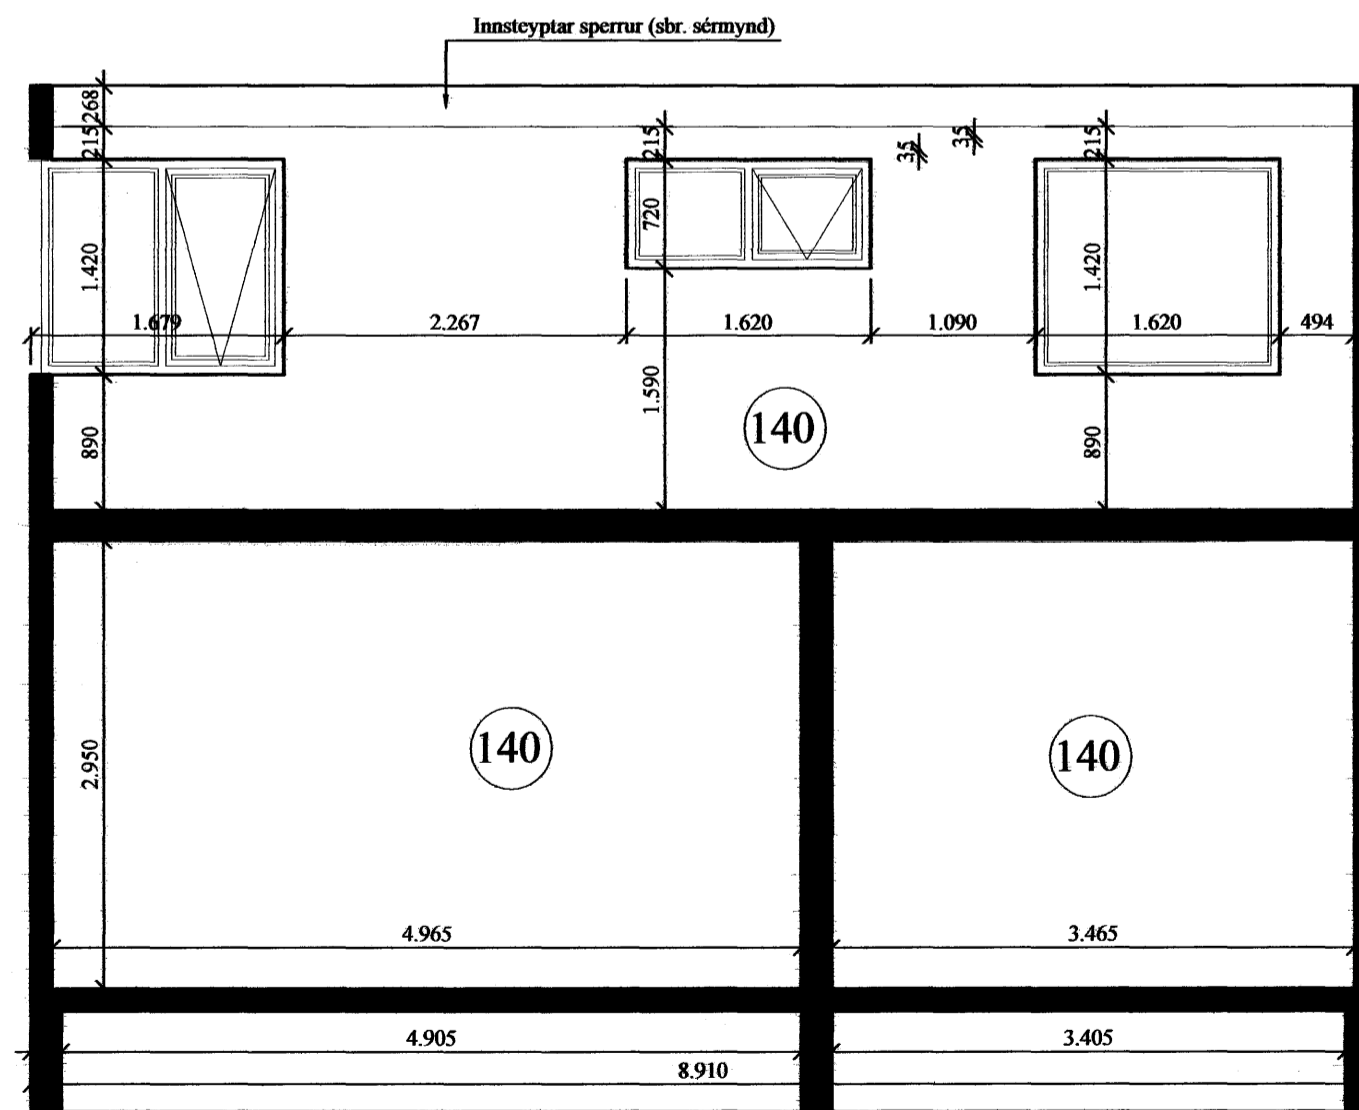

Veggur 4




Samþykkt þann

20 FEB. 2007

Byggingafultrúinn í Hafnarfirði
F.h. Sigurbjartur Halldórsson

B			
A			
Br:	Hverju breytt:	Dags:	Kvittun:
Furuás 34		Teikn nr:	
220 Hafnafjörður		202	
Sérteikningar		Frumstígrd:	
Steypumálsteikningar veggir		A2	
Dags:	24.01.2007	Mkv:	1:50
Samt:		Hann:	ÖRE/AI
	020162-3099	V.nr:	06 100
		Teikn:	AI

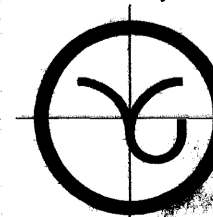

VGS
VERKFRÆÐISTOFA
GUÐJÓNS P. SIGFUSSONAR EHF.
AUSTURVEGI 42, 2. HÆÐ,
800 SELFOSSI
S: 482 2805, F: 482 3818