




Samþykkt þann
 06 DES. 2006
 Byggingafulltrúinn í Hafnarfirði
 F.h. Kristján Þórarinnsson

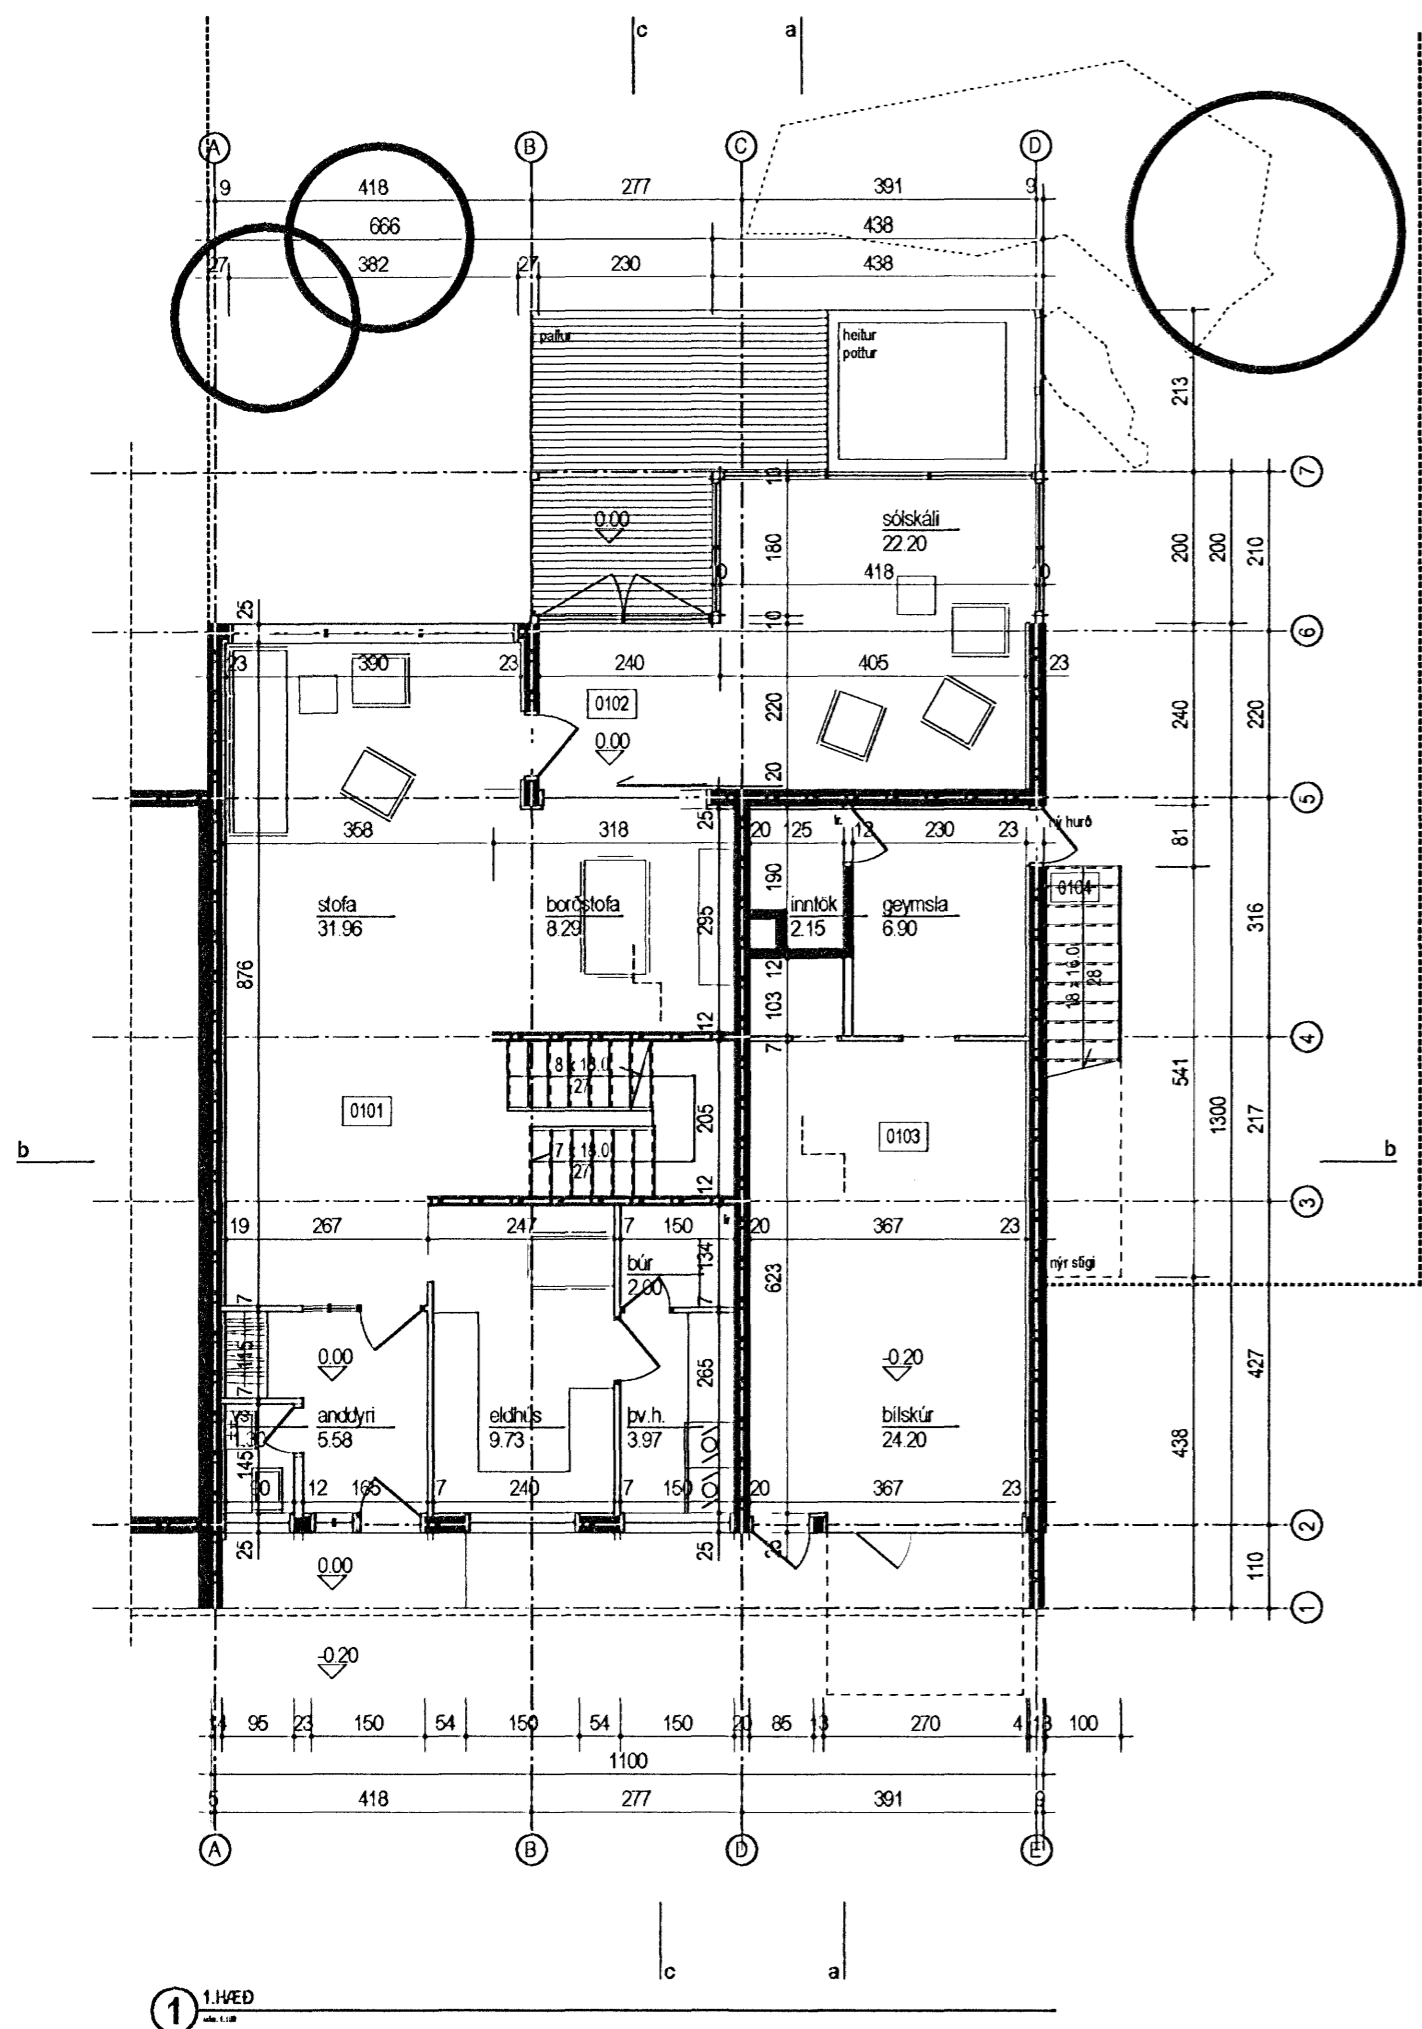


1. HJED

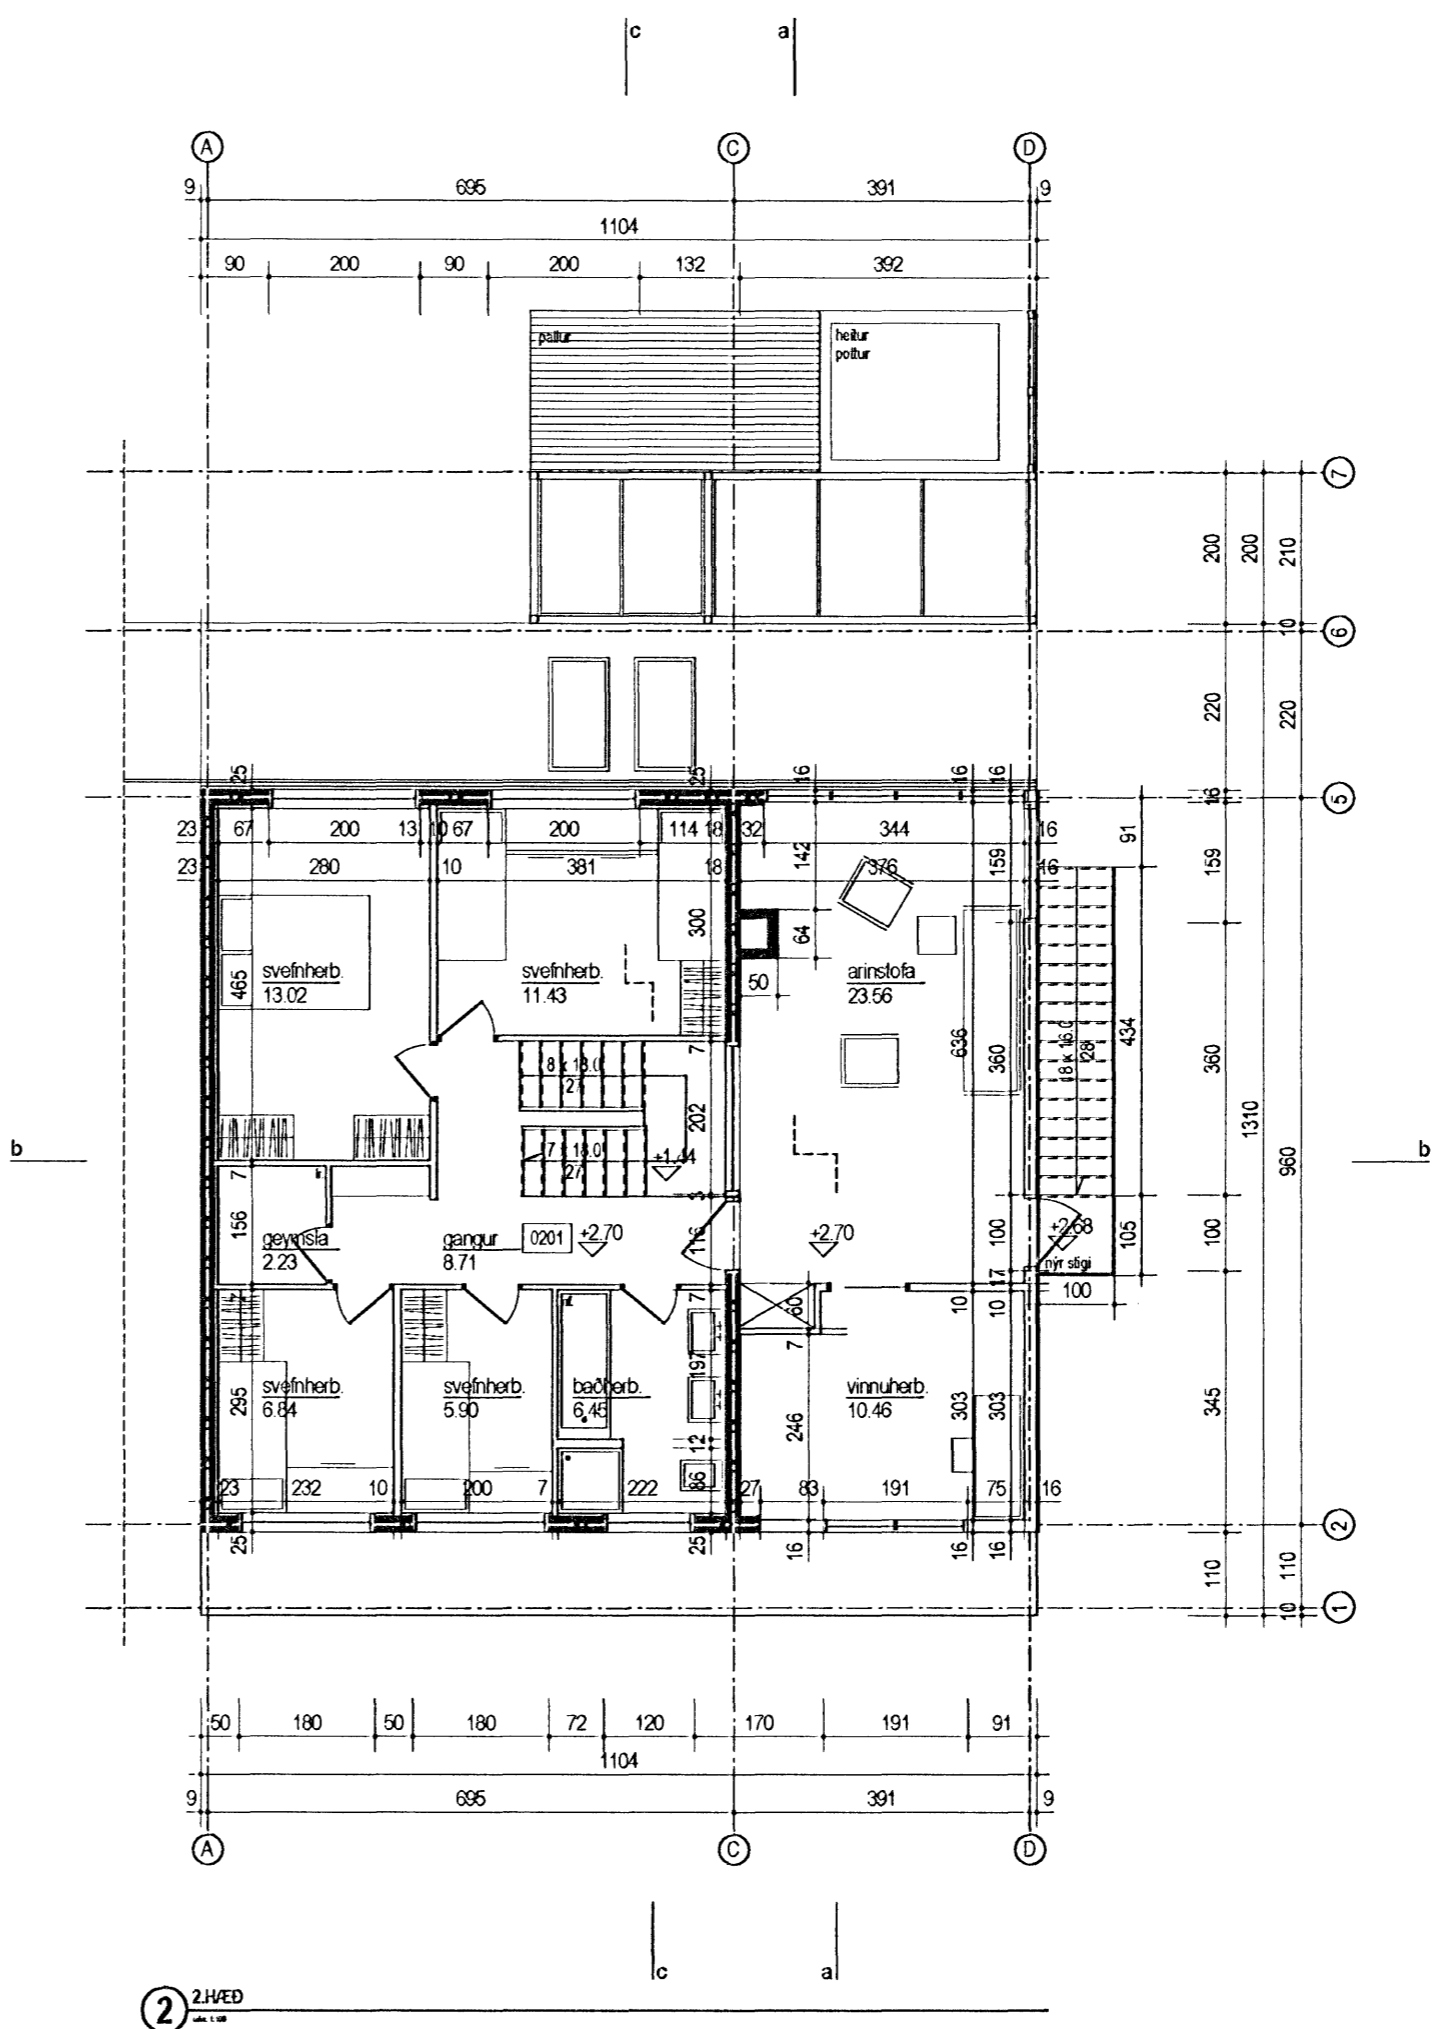

2. HJED

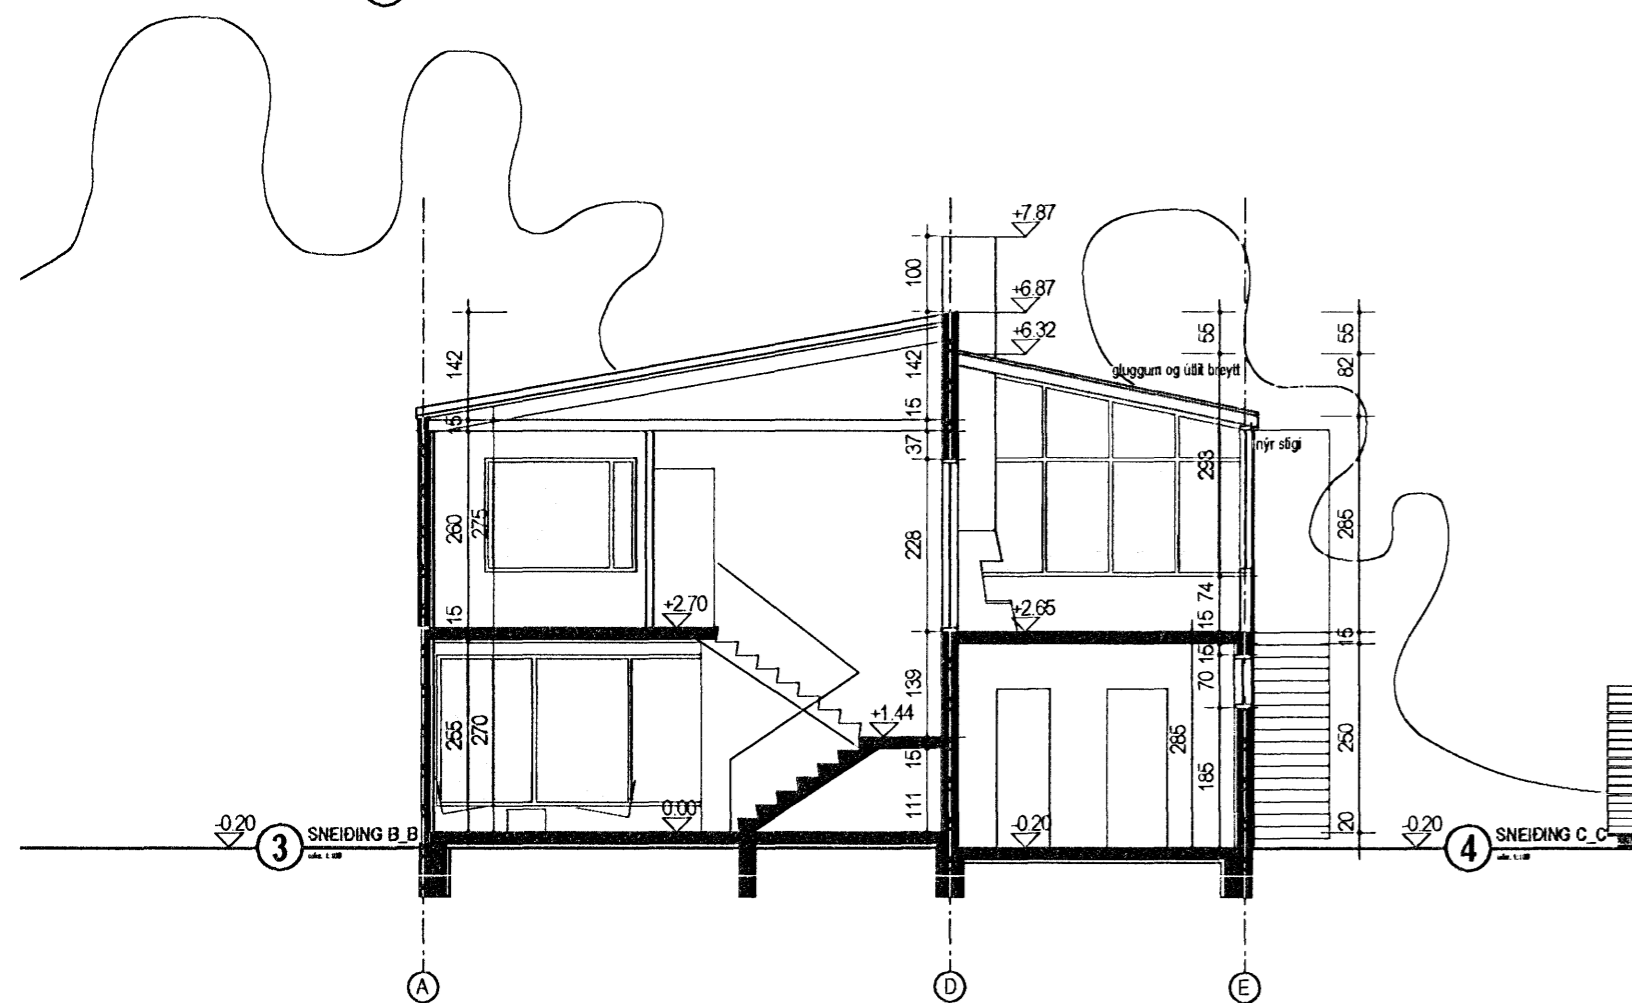

3. SNEIDING B-B

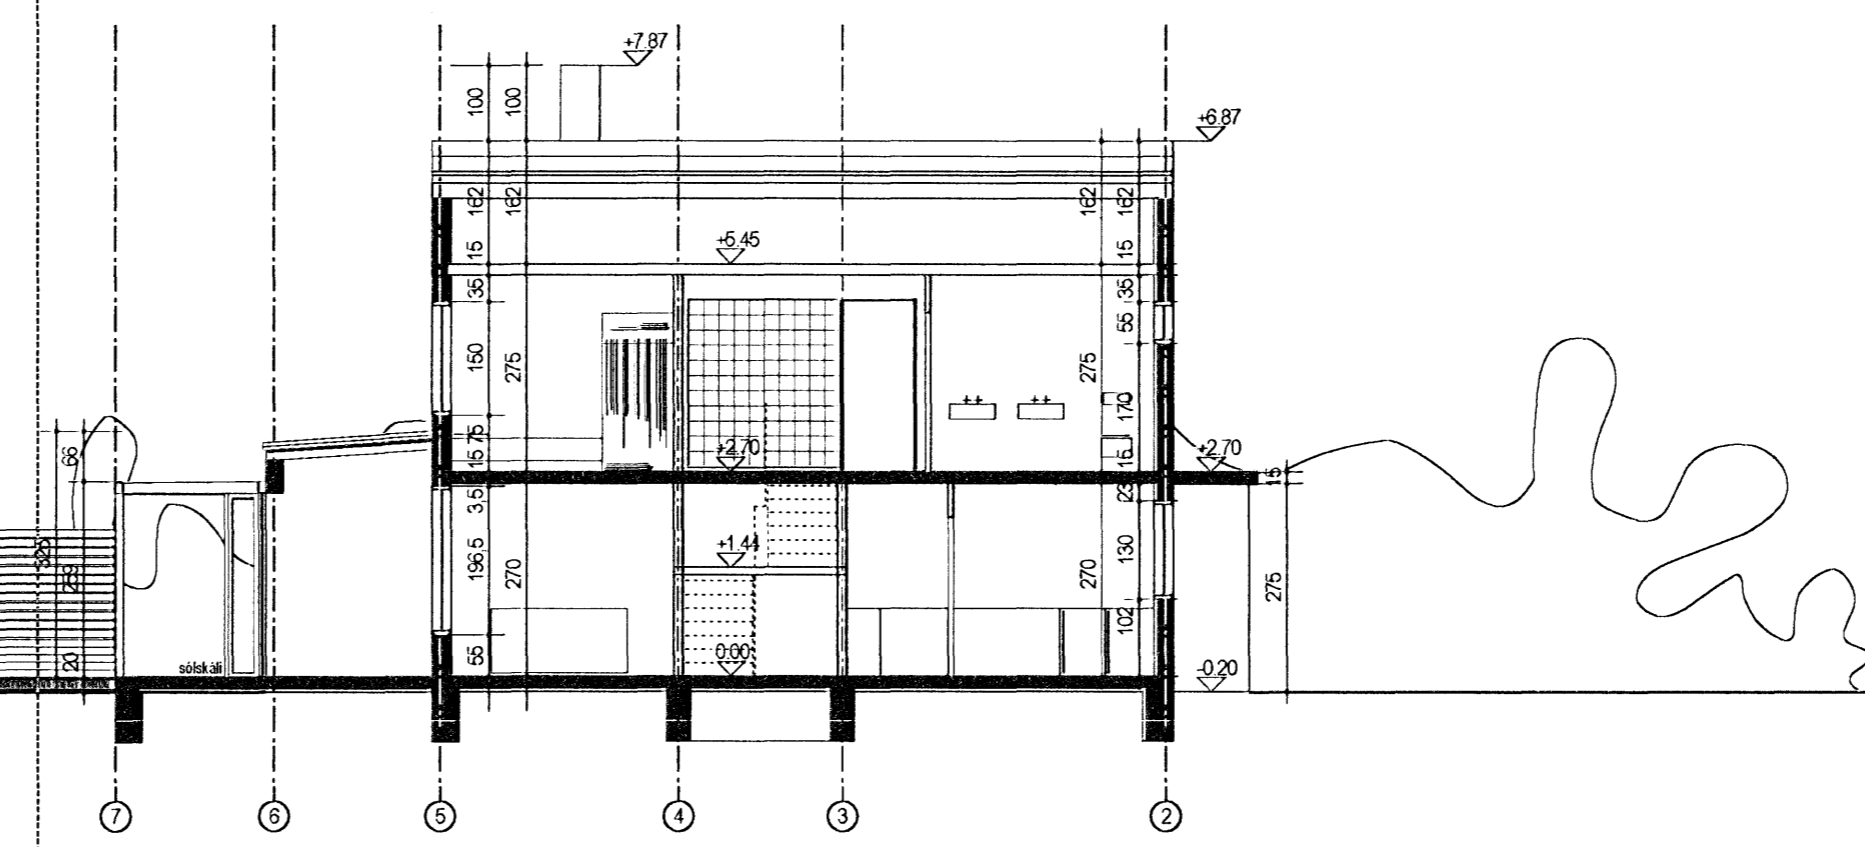

4. SNEIDING C-C

Breyting	Dagsetning	Skýring

MÍÐVANGUR 109
HAFNARFIRÐI
 REYNDARTEIKNINGAR / VIÐBYGGING / BREYTINGAR

GRUNNMYNDIR SNEIDINGAR	ÁDALUPPDRATTUR
Breyting: A1.03	Teikn.nr.: GLÁMA·KÍM
Útgáfudagur: 15.11.2006	Mkv.: 1:100
Verknúmer: 2060665	Teikn. Yfirf. AN SK

Arktitektar Laugavegi 164 ehf., 105 Reykjavík
 sí: 530-8100, f: 530-8101, kt: 500 496 2739
 glamakim@glamakim.is, www.glamakim.is

Sigbjörn Kjartansson arkitekt kt: 121258-2269
 Sigurður Halldórsson arkitekt FAI kt: 100857-2009