




Samþykkt þann
16 FEB. 2007
Byggingafrúnn í Hafnarfirði
F.h. Kristján Þórarinnsson

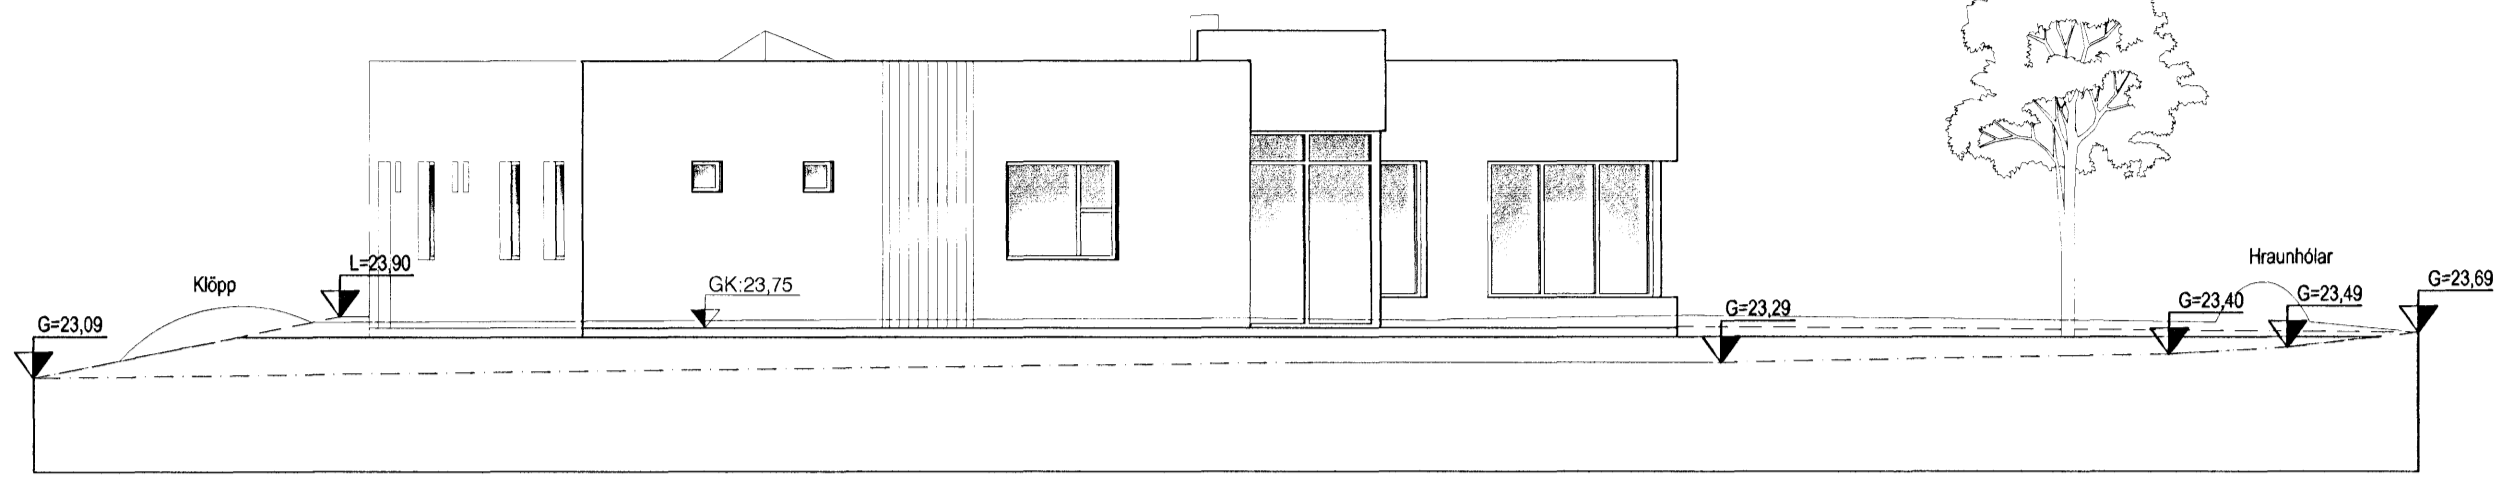


ÚTLIR VESTUR
1:100

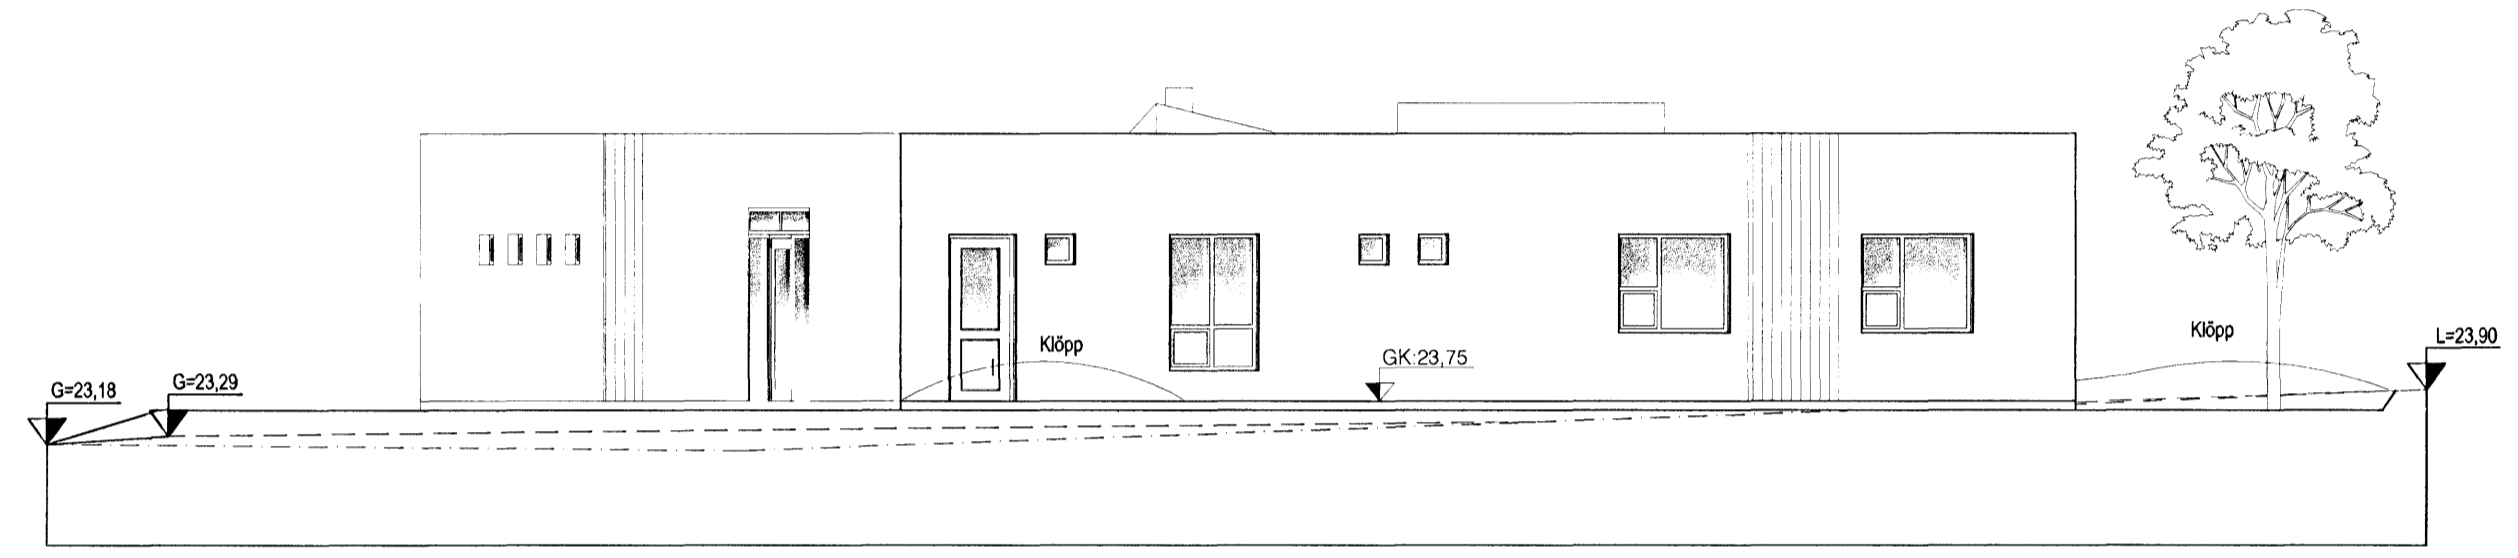

ÚTLIR NORÐUR
1:100

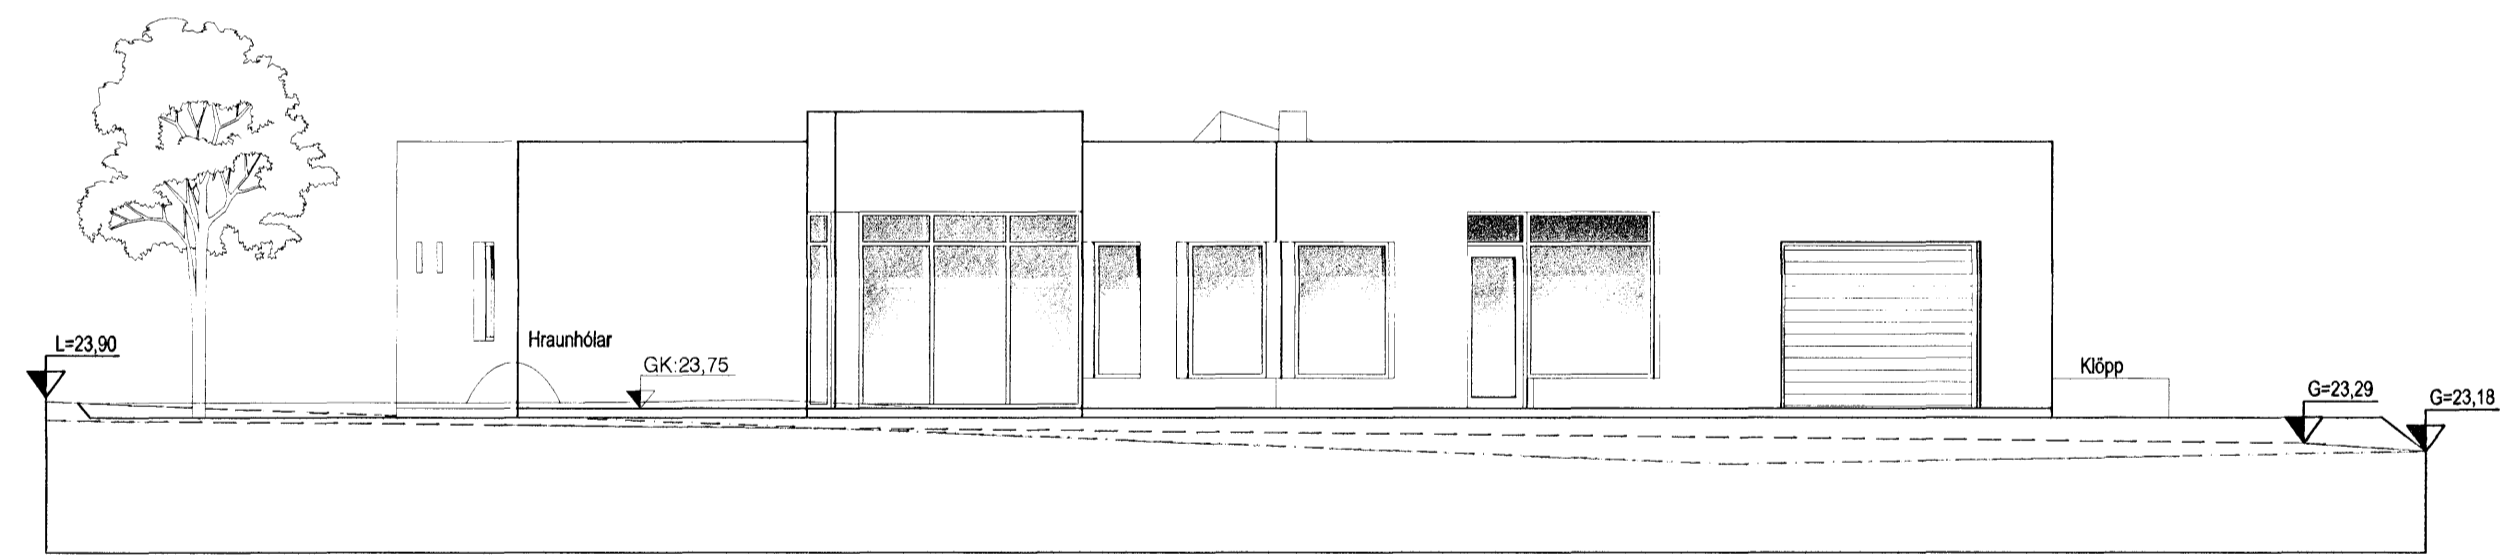

ÚTLIR SUÐUR
1:100

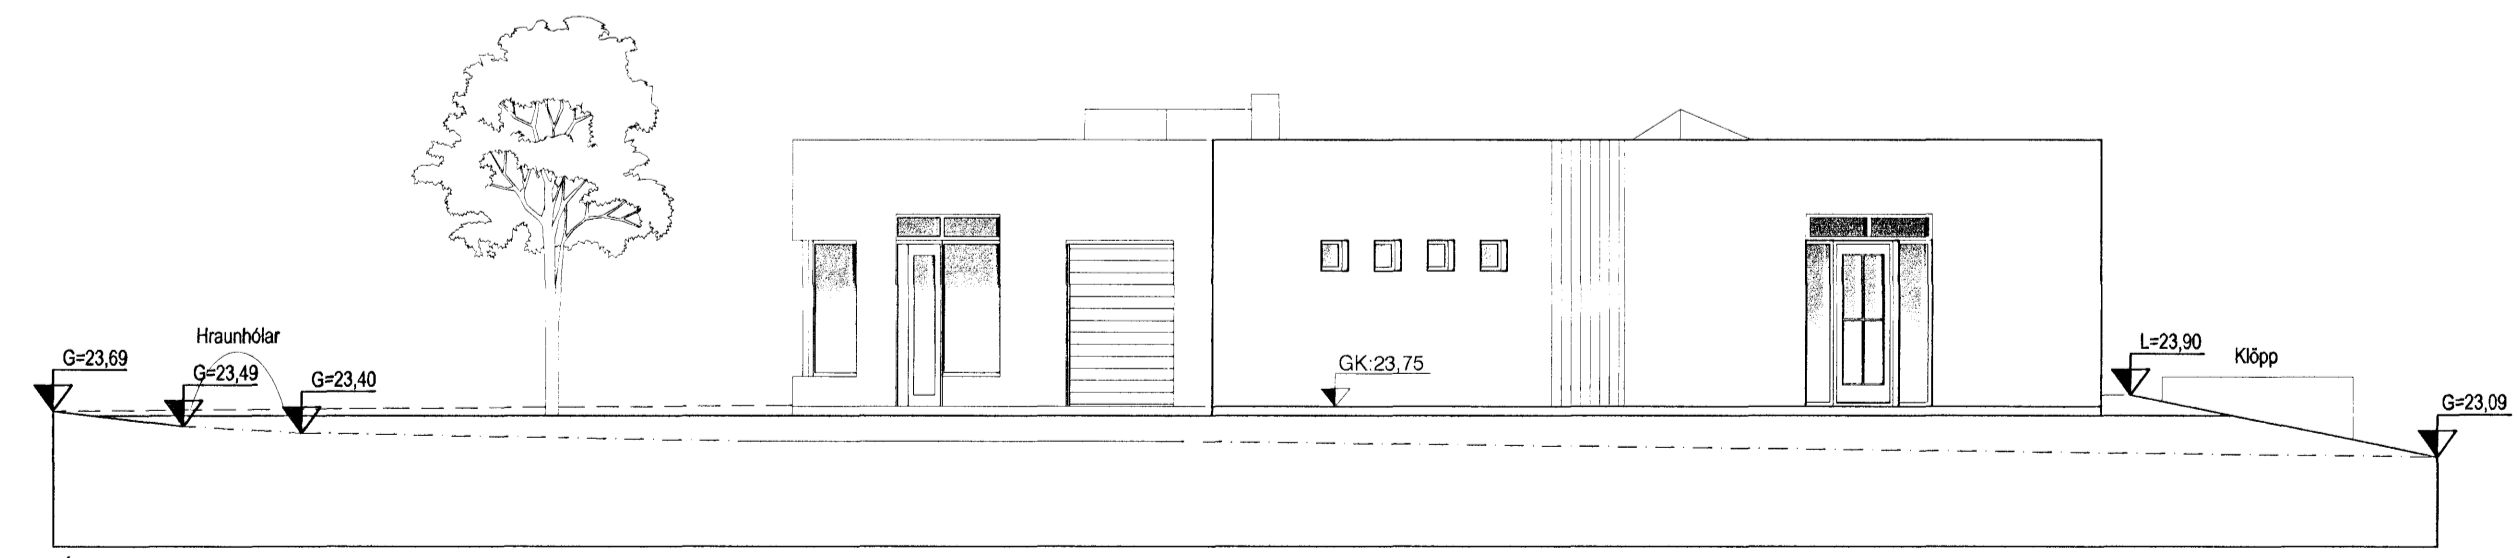

ÚTLIR AUSTUR
1:100

BR.06.02.07
HRAUNHÓLAR OG KLAPPIR SETTAR INNÁ TEIKNINGU

Góð hönnun er kjarni málsins

Margrét Cassaro
SÓLARK-ARKITEKTAR EHF


FLÉTTUVELLIR 36

SÓLARK
ARKITEKTAR
HUGVERKSHÚS

ÚTLITSMYNDIR
KVARDI: 1:100

DAGS. 20.06.05
BREYTINGAR. 19.07.05, 05.09.05
06.02.07

TEIKN. 03

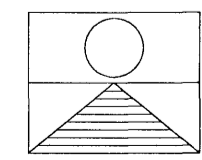

SIGRÚN ÓLADÓTTIR ARKITEKT FAÍ
MARGRÉT CASSARO BYGGINGAFRÆDINGUR
110753-4119 / 590704-2020

BÆJARHRAUN 2, 220 HAFNARFJÖRÐUR
Sími: 561 2707 - 861 2707 - 899-2707 FAX: 561-2707
nef.: arkitektar@solark.is www.solark.is