



Samþykkt þann

4 JUL 2007


Byggingáttultrúinn Hafnarfirði  
F.h. Jón Sigurðsson




AUSTURHLID, 1:100



VESTURHLID, 1:100

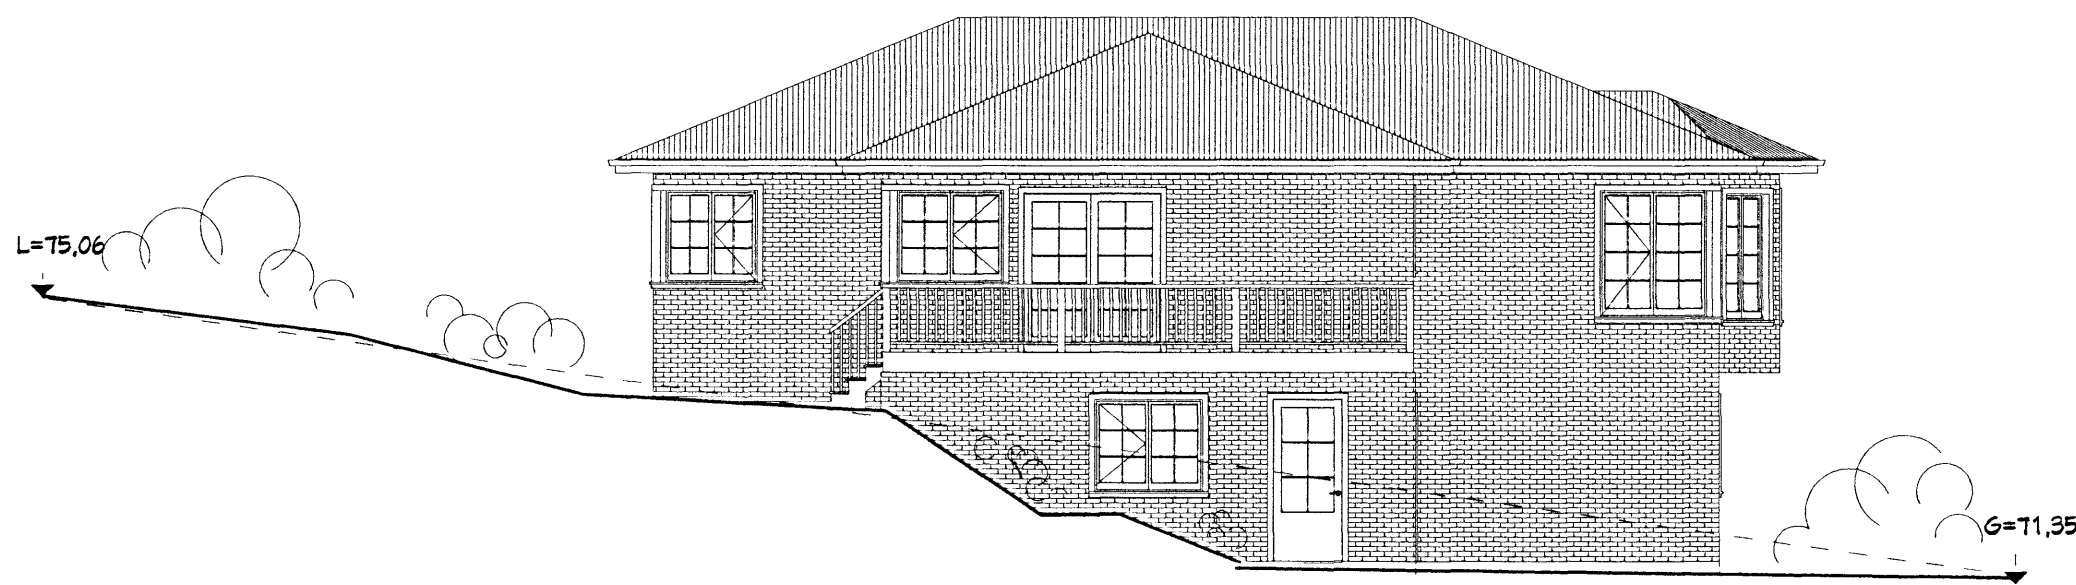

SUDURHLID, 1:100

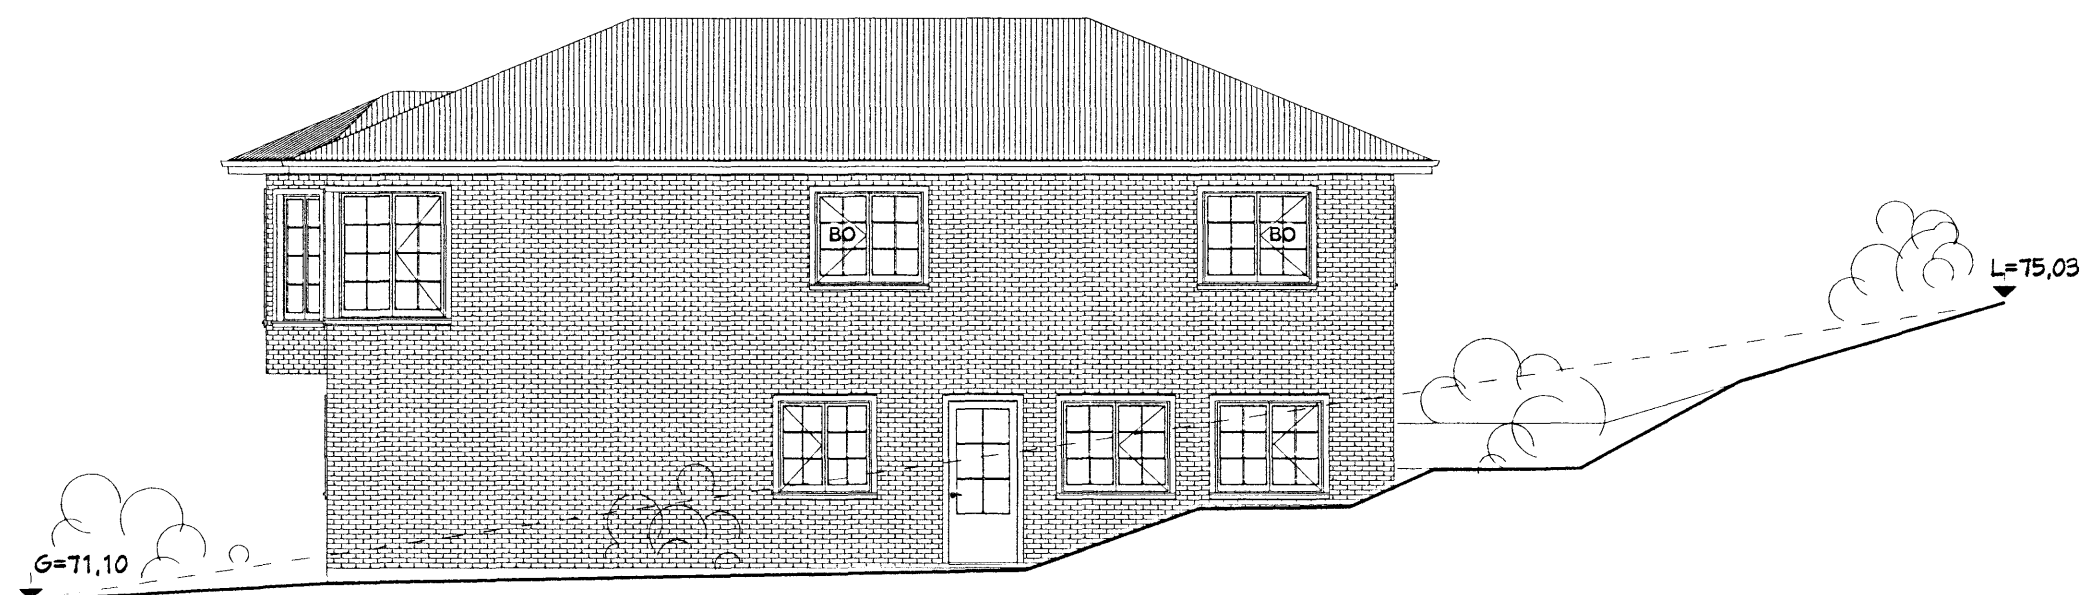

NORÐURHLID, 1:100

Breyting; A-21.06.2007-Múrsteinski á kjallara, -opnanl.fög innf- landlínur lagf.  
Breyting; B-04.07.2007-Landhalli lagfærður.

HUGVERK HÖNNUNARÞJÓNUSTA  
STEFÁN INGÓLFSSON ARKITEKT  
stefanlax2@simnet.is s:848-1316

Fjólúás 30, Hafnarfirði

Kópavogi 18.03.2007  
Verkefni nr. 0368  
Teikning nr. 0368-sing-0003-B