




NORÐUR ÚTLIT 1:100

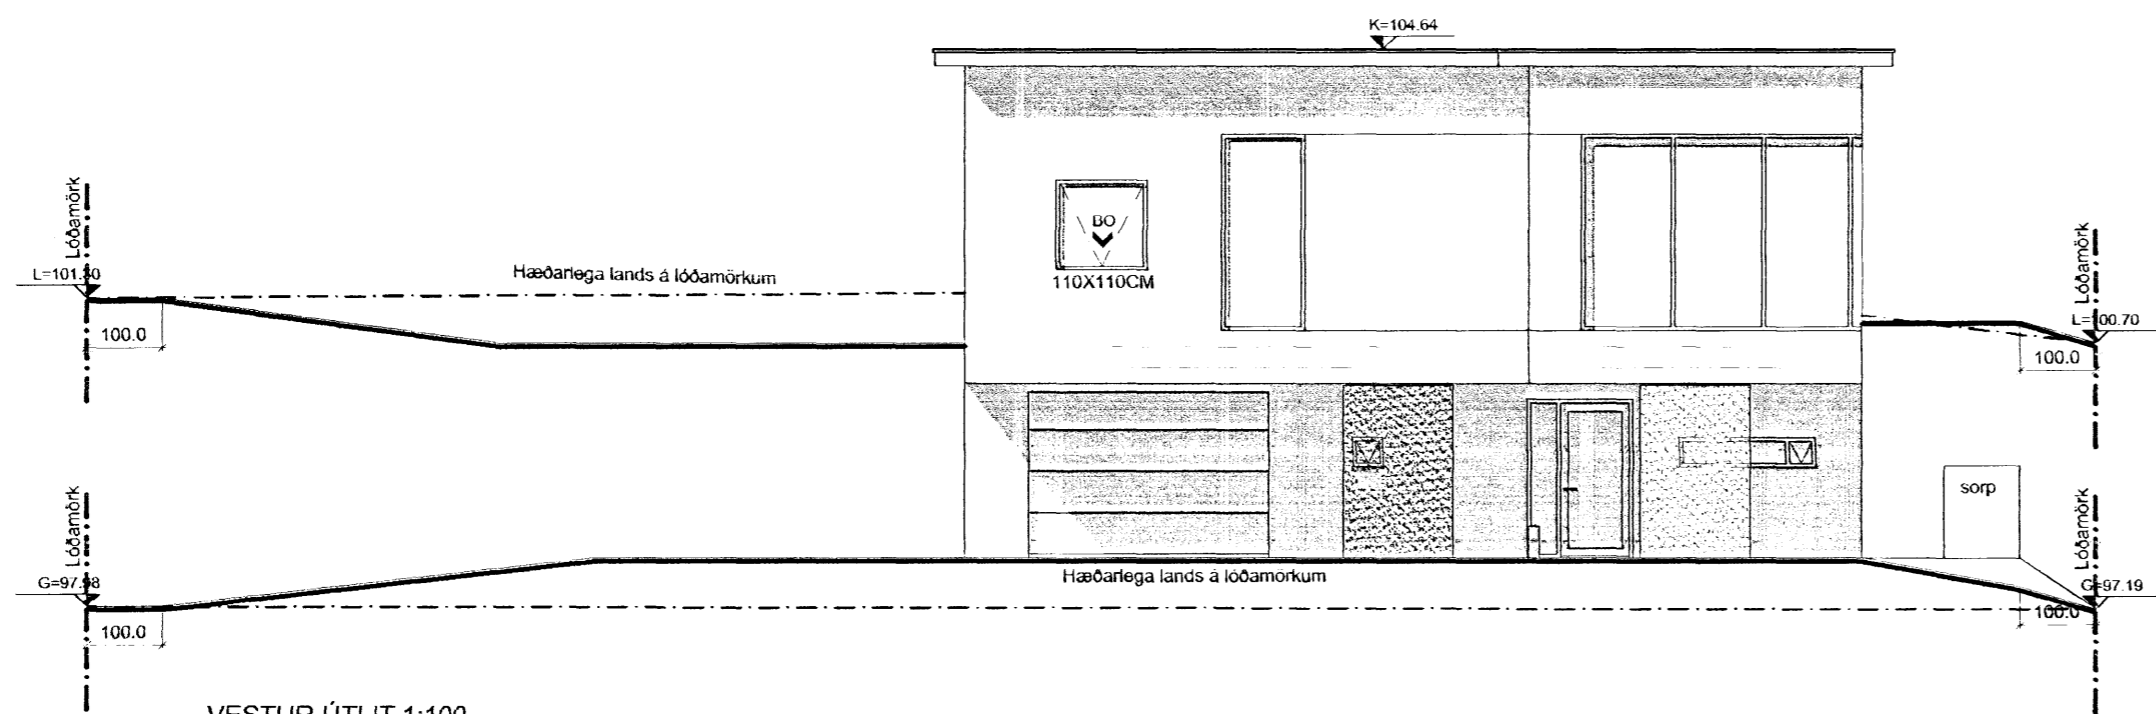

VESTUR ÚTLIT 1:100

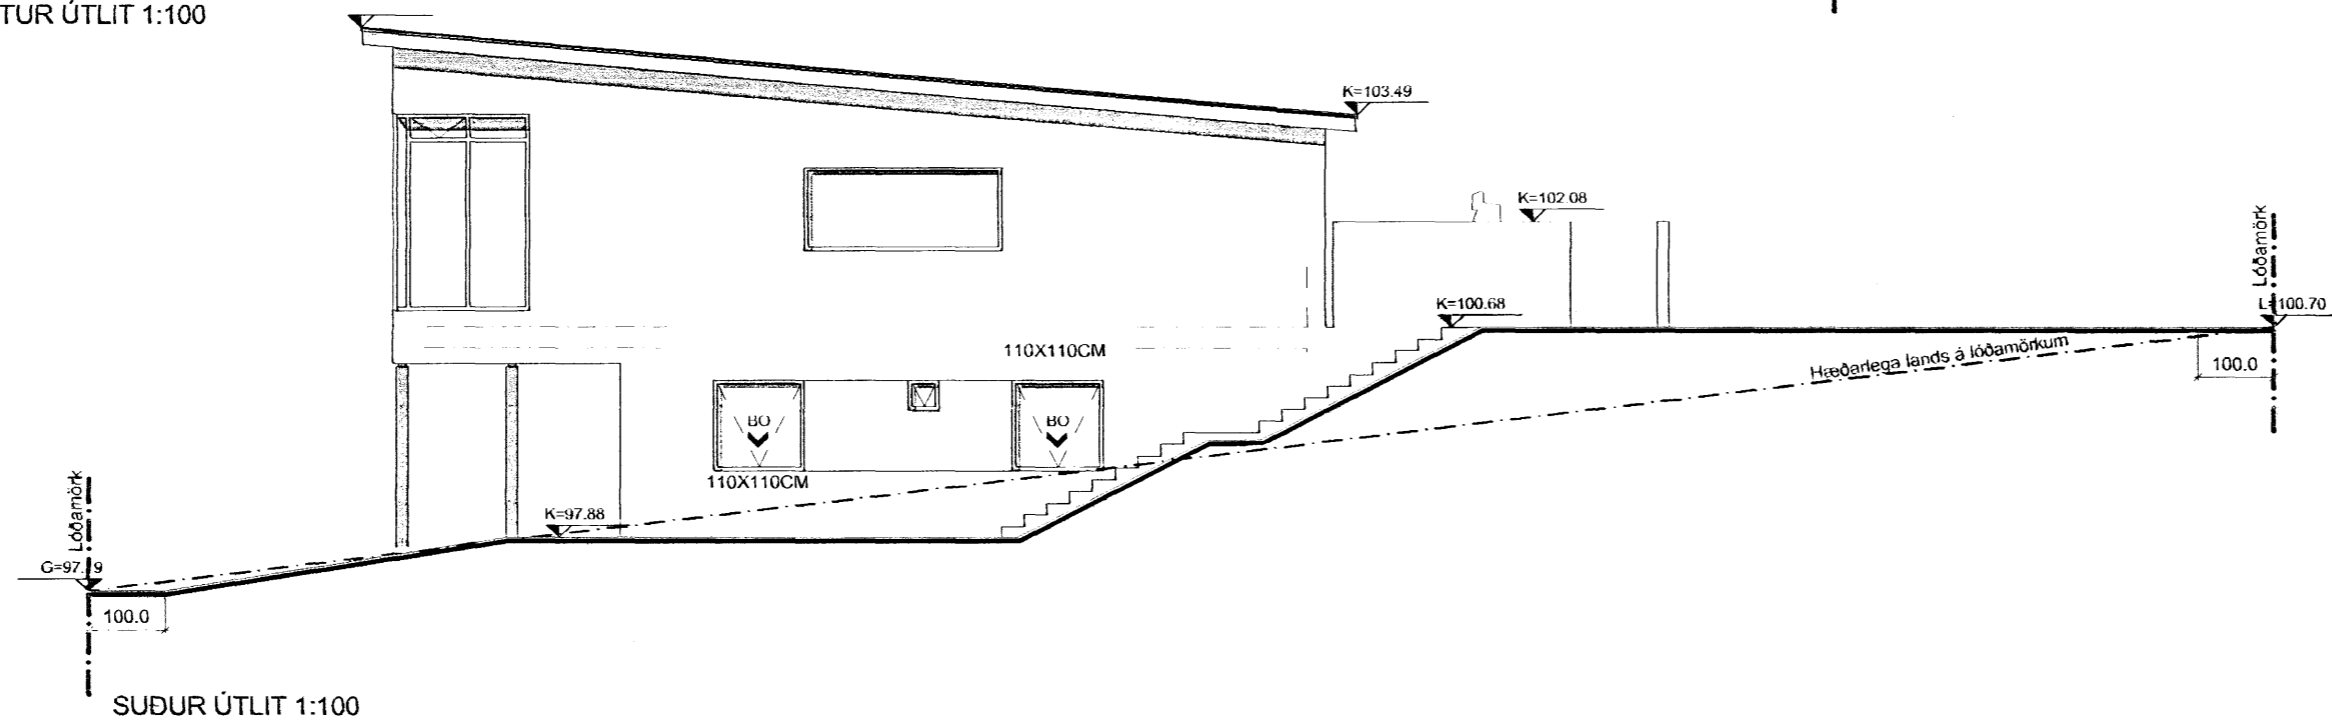

SUÐUR ÚTLIT 1:100

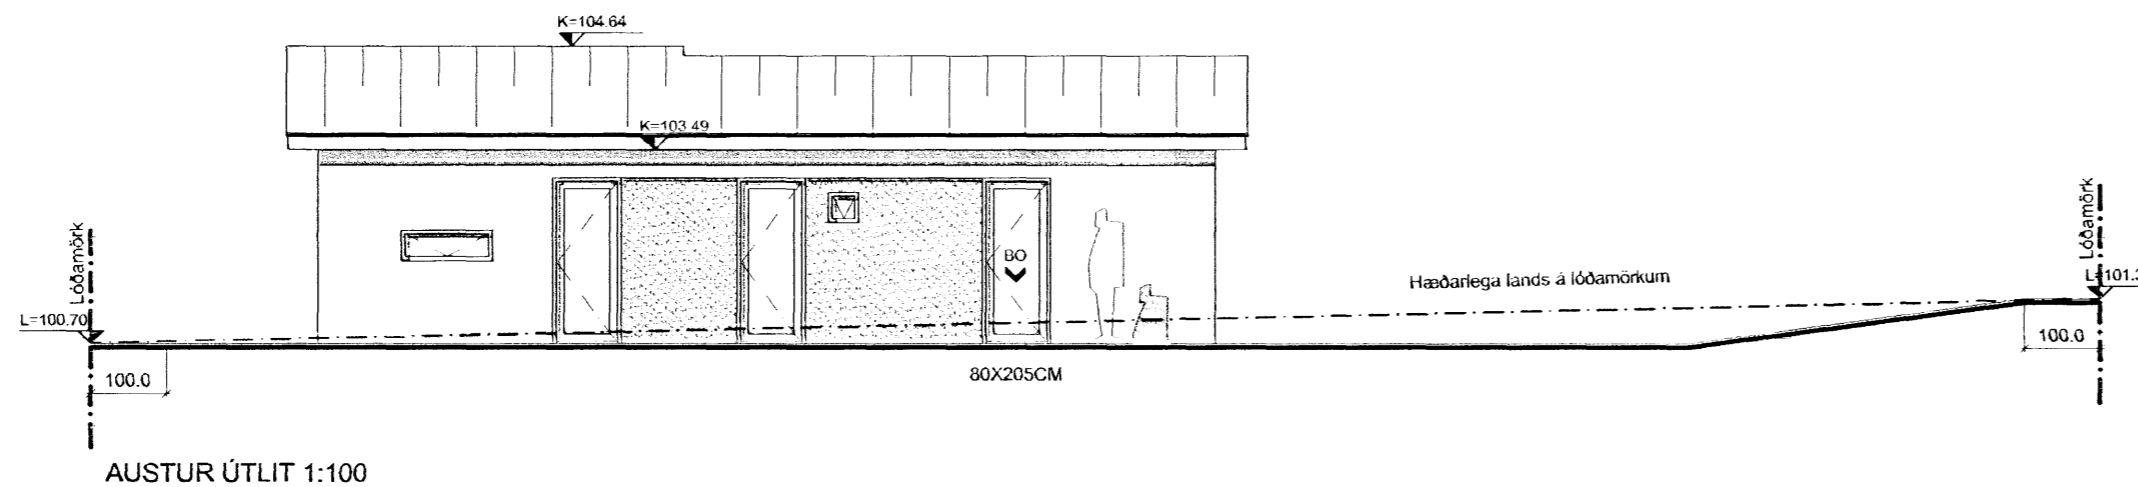

AUSTUR ÚTLIT 1:100


Samþykkt þann
22. AUG. 2007
Byggingafulltrúinn í Hafnarfirði
F.h. Kristján Þórarinnsson

Úr Gildi

C:
B:
A: Hækkun á grunnkóta húss 02.08.07
BREYTINGAR: 3 DAGS:

SKÓGARÁS 20, HAFNARFIRÐI

VERK:
ADALUPPDRATTUR KVARÐI: 1:100
DAGS: 04,04,07
ÚTLIT TEIKN: LME,IFG,ÁK,RH
SKRÁ:

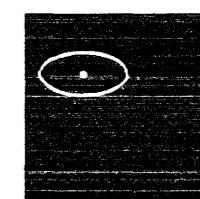

KOLLGÁTA
arkitektúr - hönnun
Kaupvangsstr. 29, 600 Akureyri
Símar: 462 7881 - 862 7881
Netfang: kollgata@kollgata.is

Logi Már Einarsson arkitekt faí kt. 210864 - 2969