
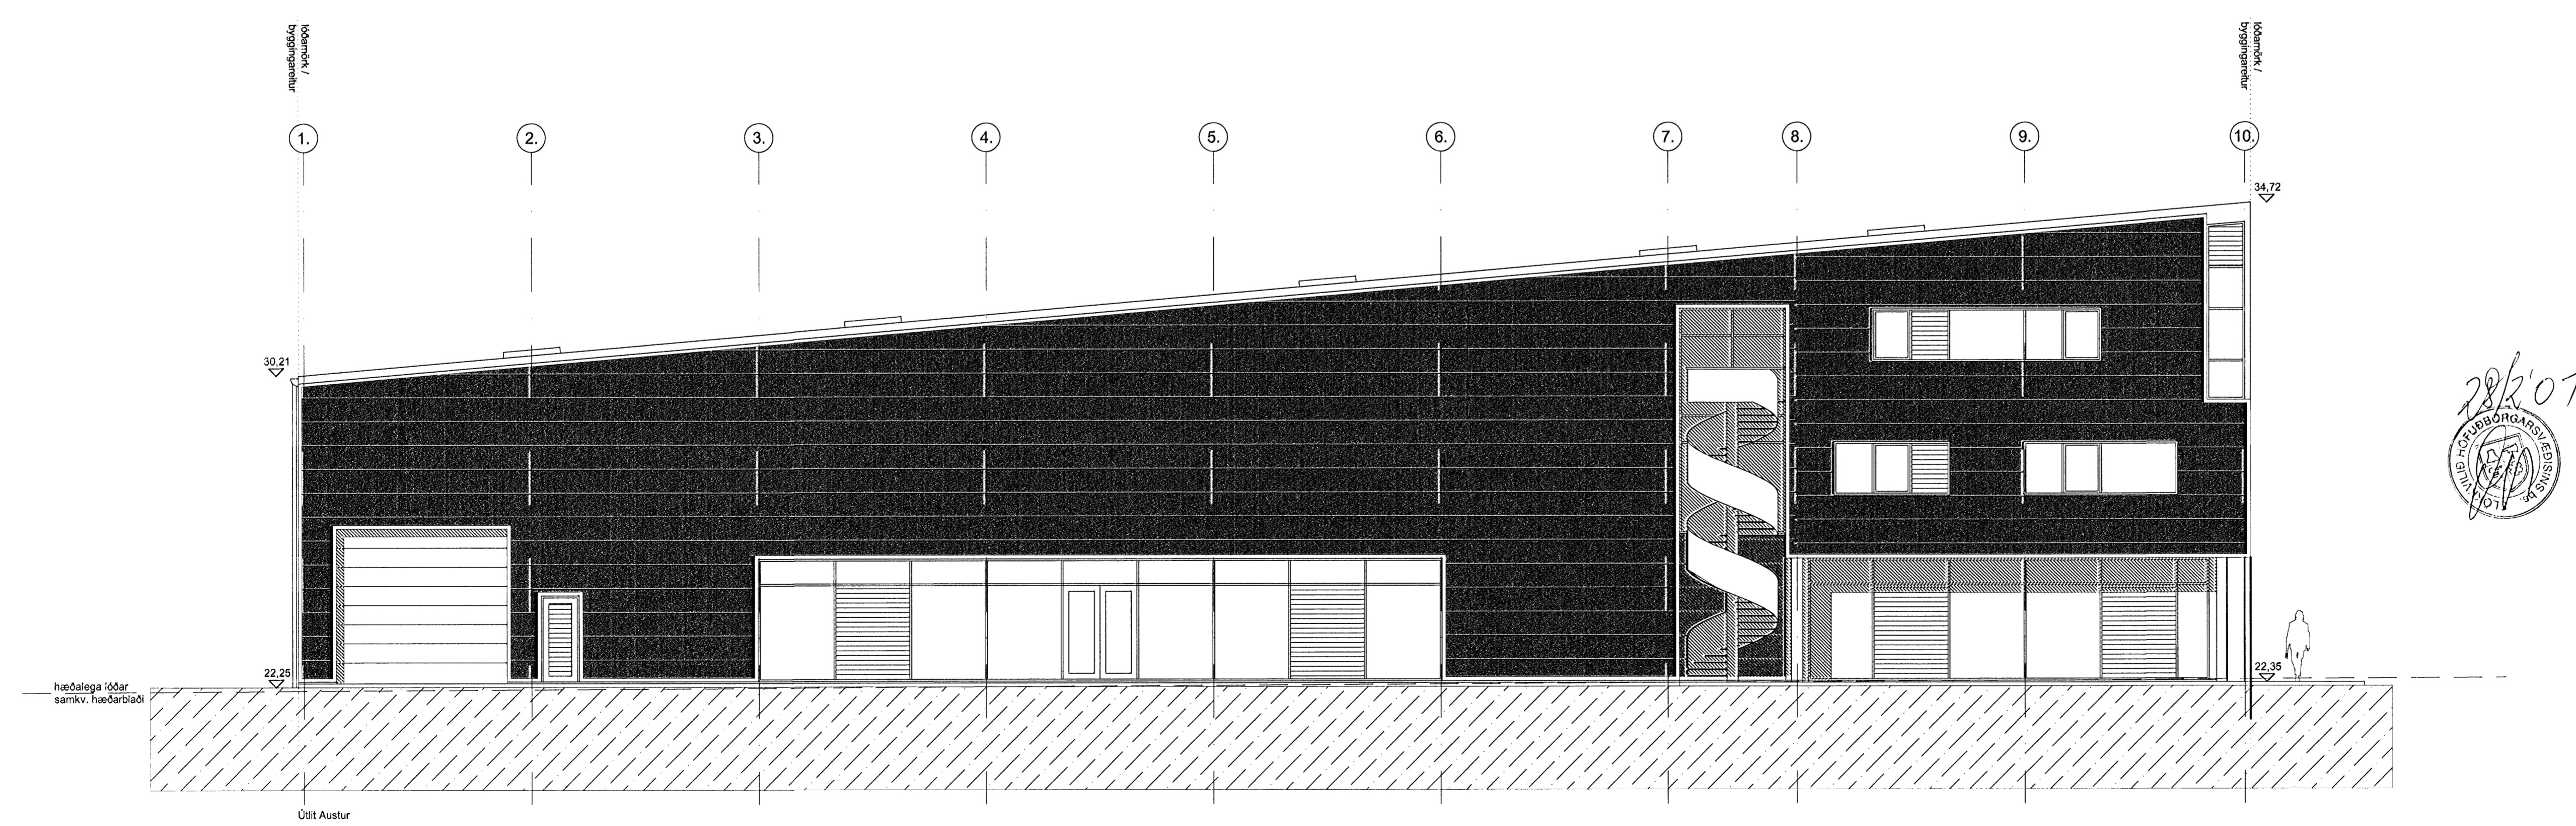


# Úr Gildi

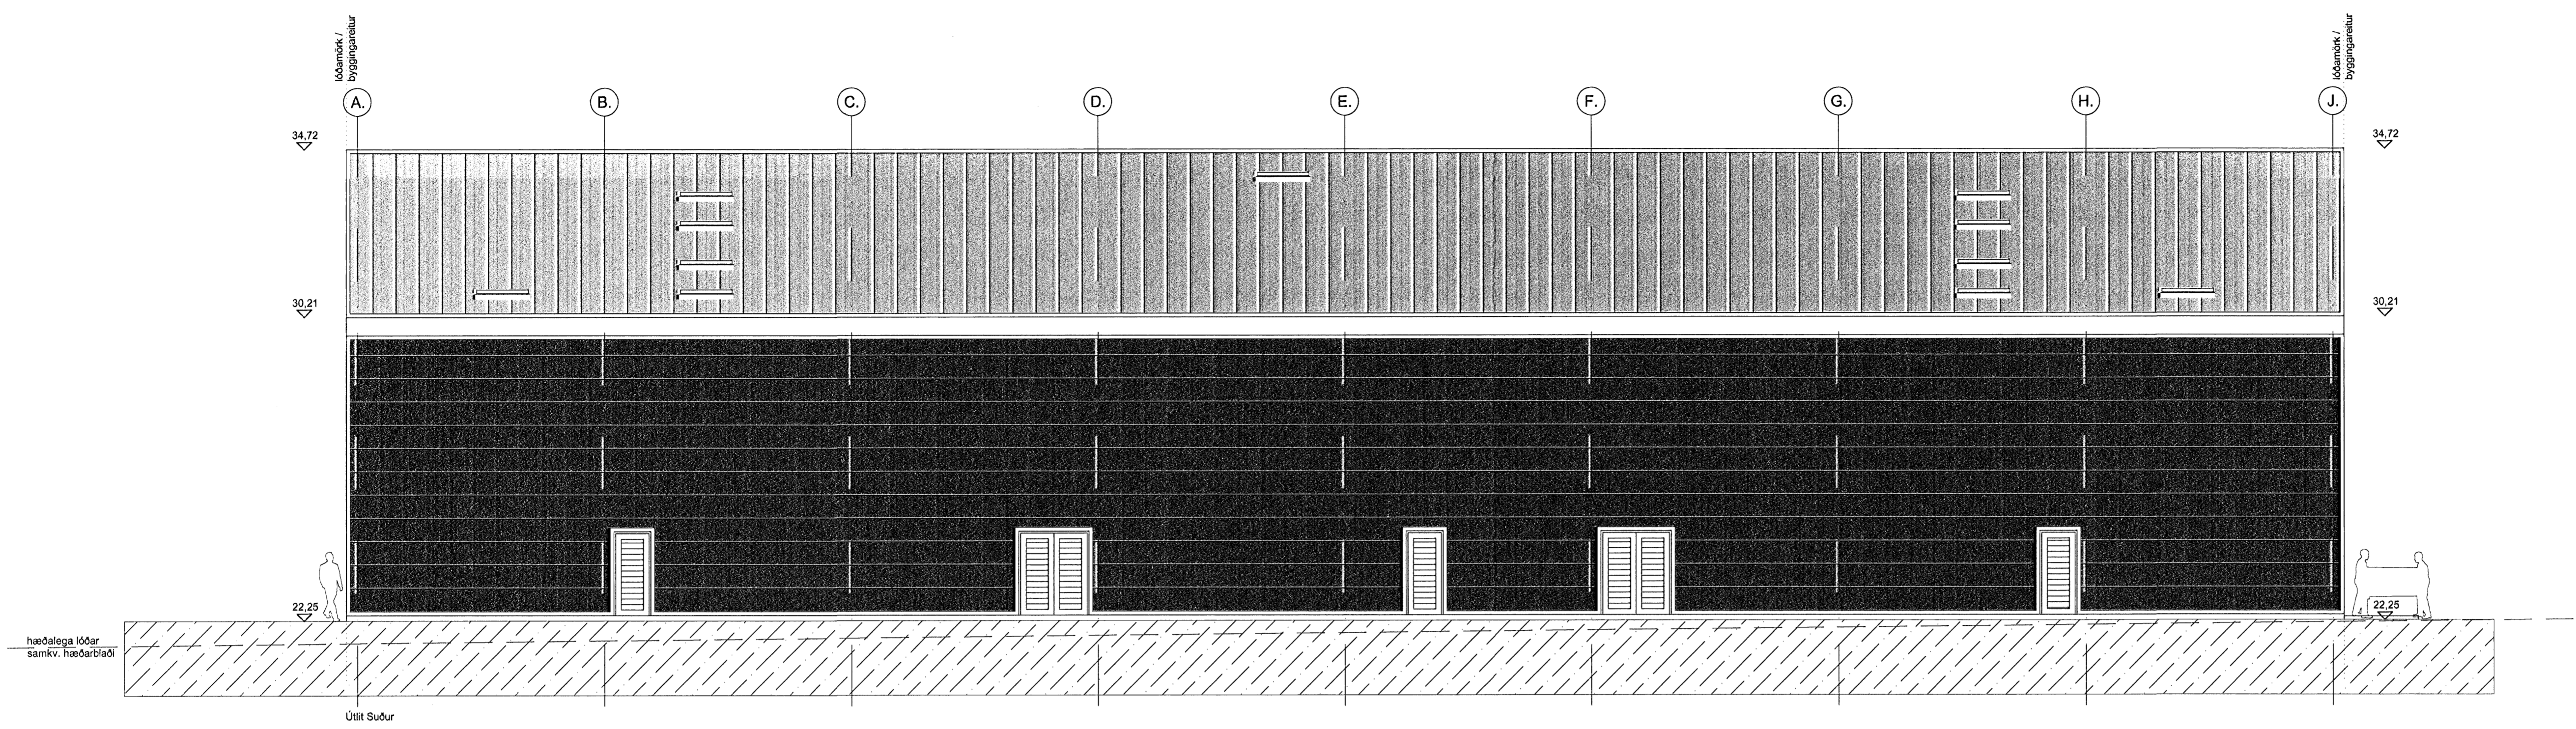

Verkheiti:	Tjarnarvellir 11, skrifstofu, verslunar og lagemúsnaði
Verklut:	Útlit Suður og Austur
Teiknúmer:	1.06
Mælikvæði:	1:100 / A1
Teiknað:	bb/HH
Yfirfarð:	
Samþykkt:	
Verknúmer:	06029
Útgáfudagur:	12.02.2007
Teiknisið:	
Útprintað:	

*Sig. Hallgrímsson*

**ARKÞING** BOLHOLT 8 - 105 REYKJAVÍK  
SÍMI: 570 5700 - FAX: 570 5701  
arkthing@arkthing.is - www.arkthing.is

SIGURÐUR HALLGRÍMSSON,	170753-3139	ARKITEKT
HJÓRTUR PÁLSSON,	080152-4429	BYGG.FR.
GUÐRÚN INGVARSDÓTTIR	291272-6069	ARKITEKT
ÞÓRÐUR ÞORVALDSSON	210463-4619	ARKITEKT