
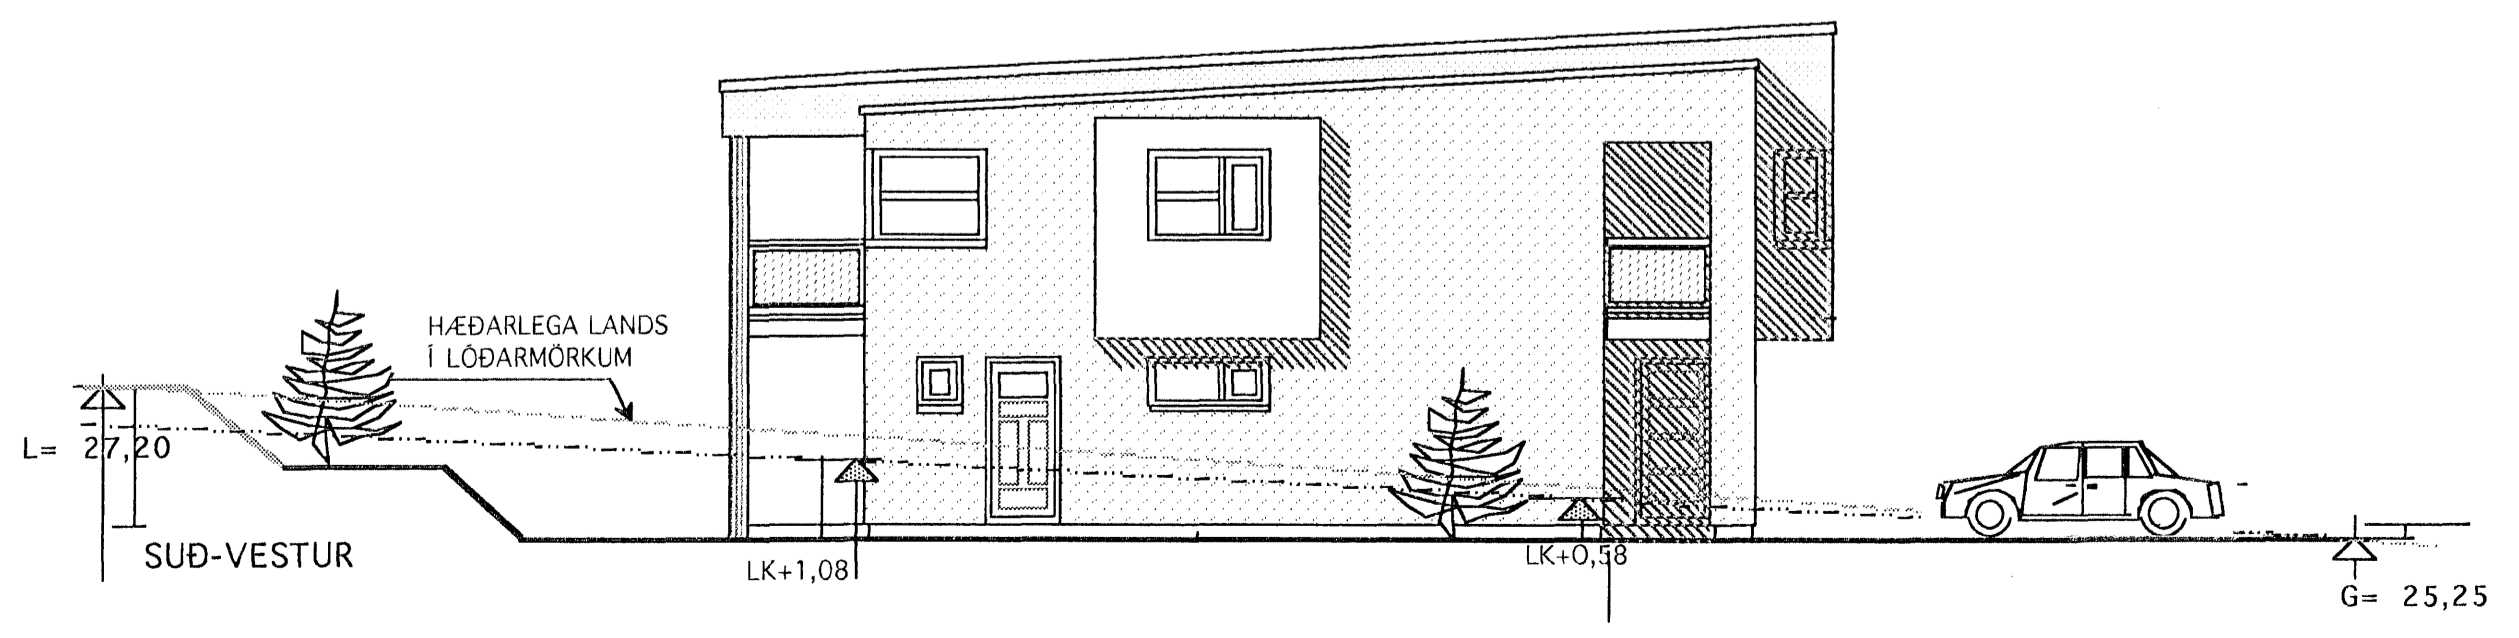
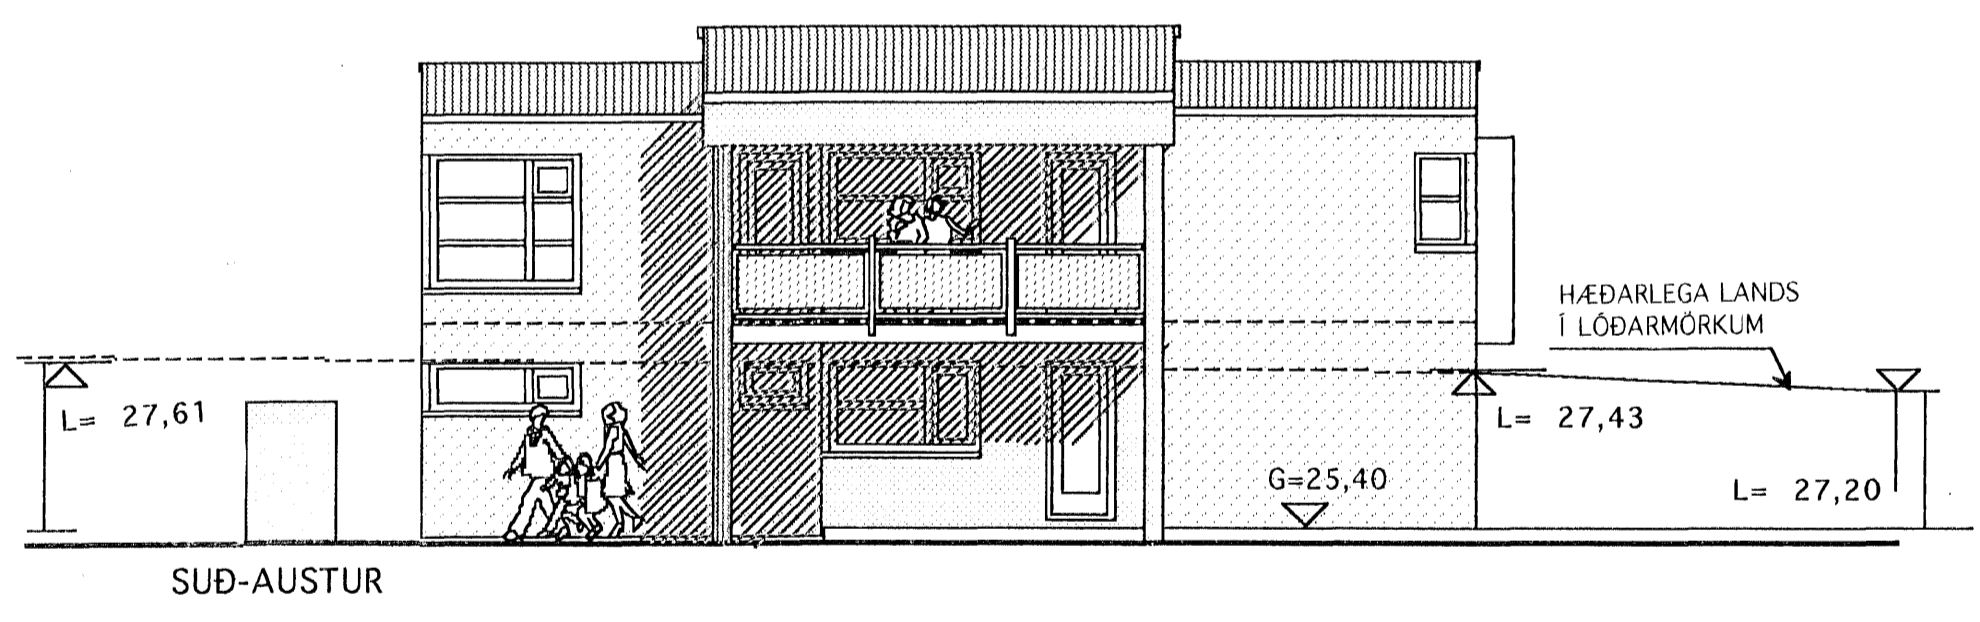


Samþykkt þann  
23 MAÍ 2007  
Byggingafulltrúinn í Hafnarfirði  
F.h. Kristján Þórarinnsson

Úr Gildi

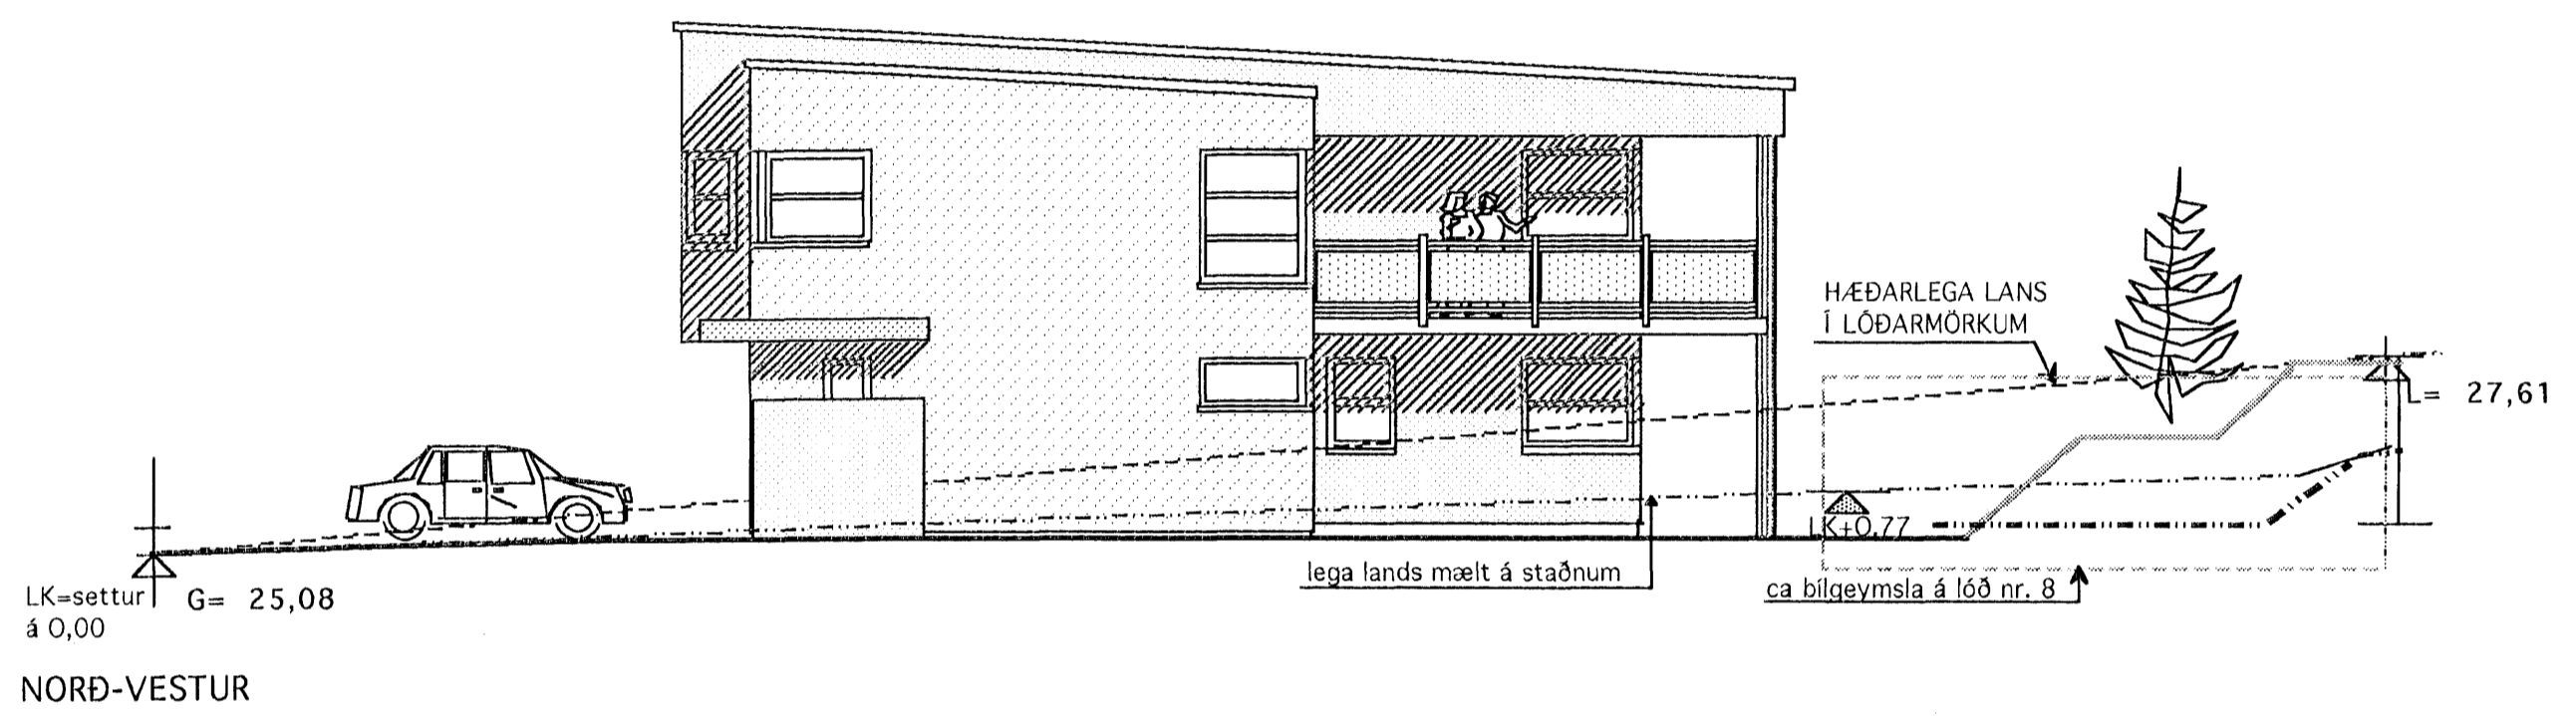

Breytt 17 apríl 2007  
Þvottahús og geymsla á 1 hæð skipt í 2. rými  
6 m<sup>2</sup>/80 m<sup>2</sup>= 0,75 x 59,4 m<sup>2</sup> = 4,45 m<sup>2</sup>

Verkefni  
LINDARHVAMMUR 10  
HAFNARFIRÐI

Heiti  
ÚTLITSMYNDIR

kvarði 1:100	verk.nr
dags. 10. nóv...2003	dags br.
hönnun S. Ó. - G. G.	teikn nr
teikn G.G.	<b>A-3</b>

Gísli G. Gunnarsson B.F.Í, kt. 020649-2409  
Hringbraut 17  
220 Hafnarfirði  
s. 555-2020 FAX 555-2021  
netfang: kvardj@vortex.is www kvardi.is

*Gísli Gunnarsson*