


ÚTLIT NORDURHLID

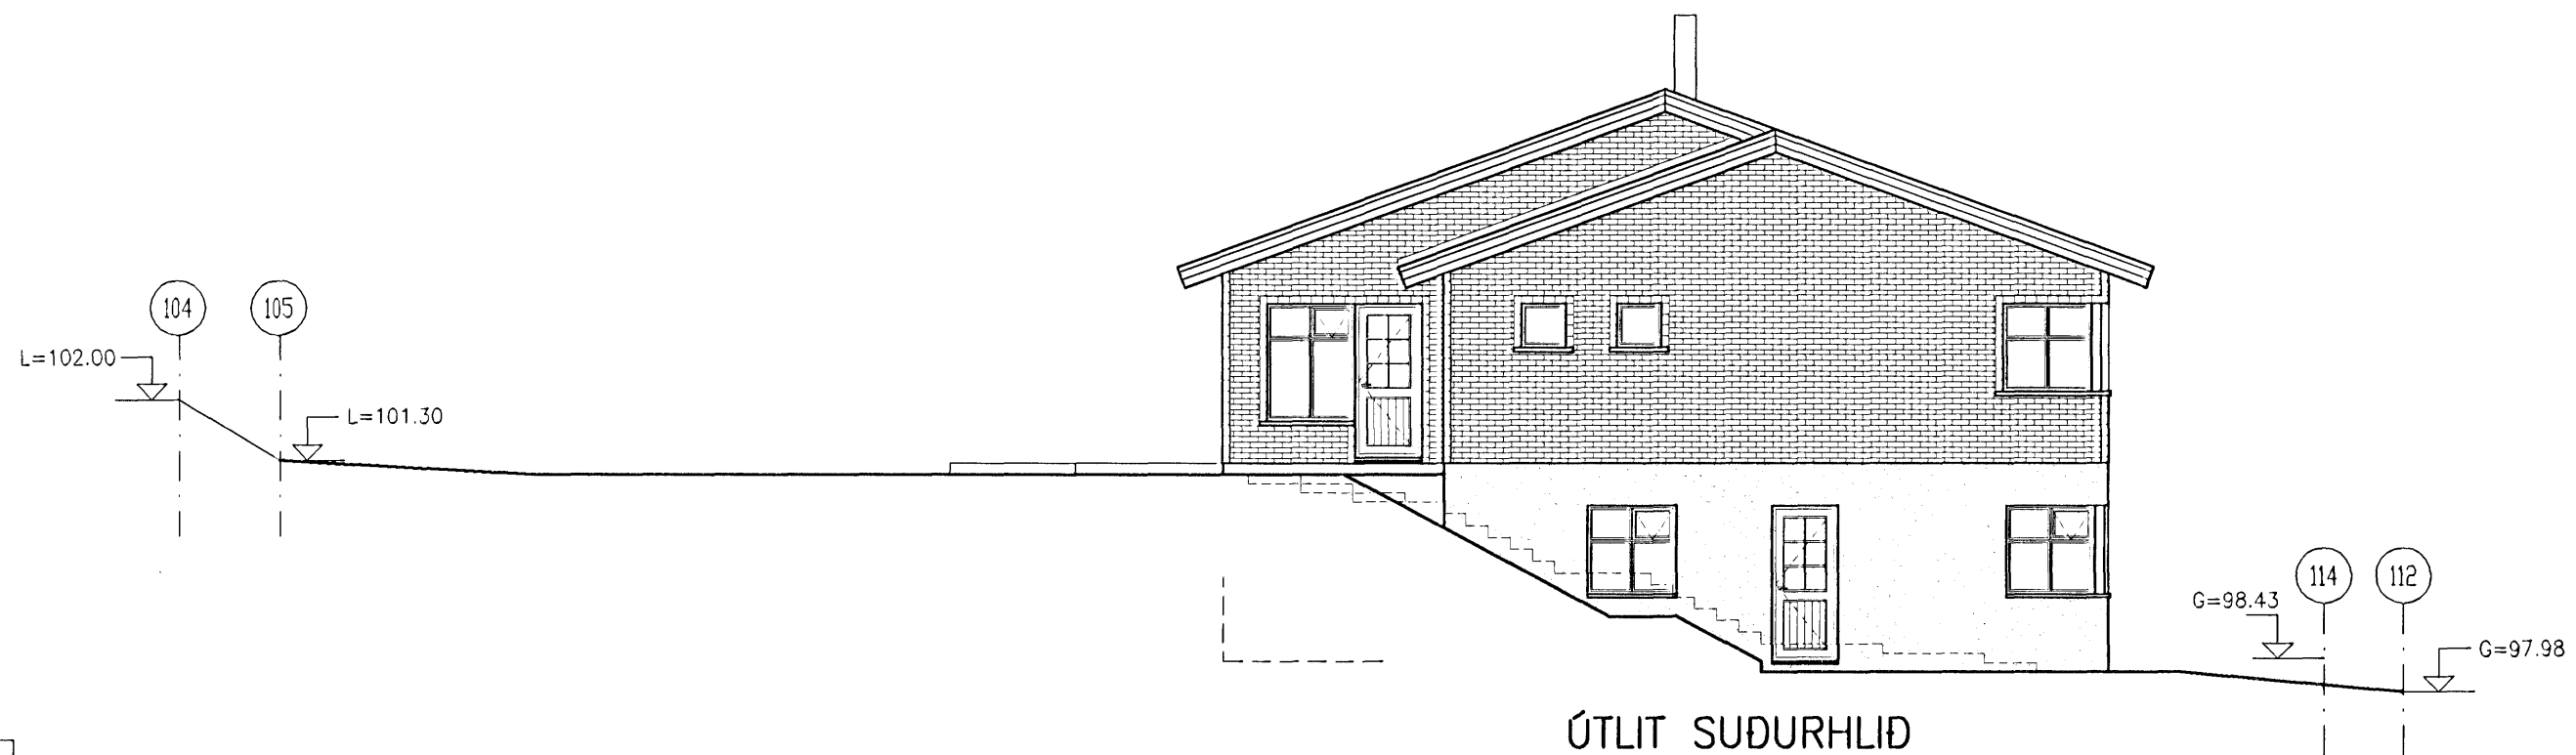

ÚTLIT SUDURHLID



ÚTLIT VESTURHLID



ÚTLIT AUSTURHLID

Sampykkt þann
23 MAI 2007
Byggingafulltrúinn í Hafnarfirði
F.h. Kristján Þórarinnsson

NR.	DAGS.	BREYTING
A	MAI 07	BETT INN ÚTTRÖPPUM

SKÝRINGAR

B/S'07
SEMUNDUR EIRIKSSON 261249-2949

SKÓGARÁS H
220 HAFNARFJÖRDUR



KLÖPP ARKITEKTAR-VERKFRÆDINGAR EHF
NETHYL 2E, PÓSTHÓLF 10050, 130 REYKJAVÍK
SÍMI 577 2277, 699 7747 - klopp@simnet.is

HEITI TEIKN.	ÚTLIT
MÆLIKVARDI	1:100
DAGS.	FEB 2007
TEIKNING	A 004
VERK	V 06-308
BREYTING	A
YFIRFARID	S.E.