
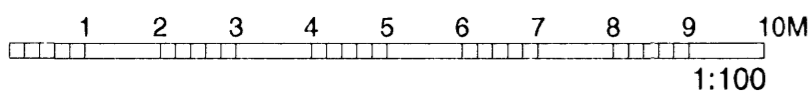
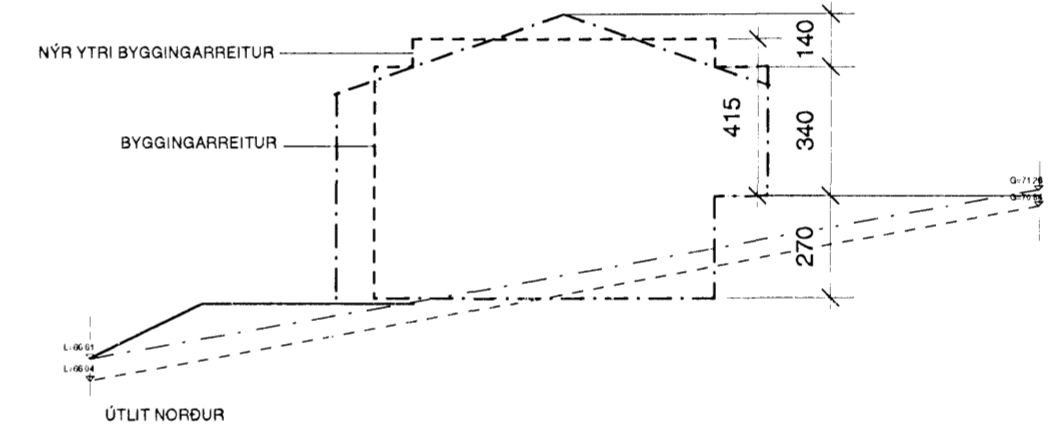


~~Samþykkt þann  
06 MAI 2007  
Byggingafulltrúinn í Hafnarfirði  
F.h. Kristján Þórarinnsson~~

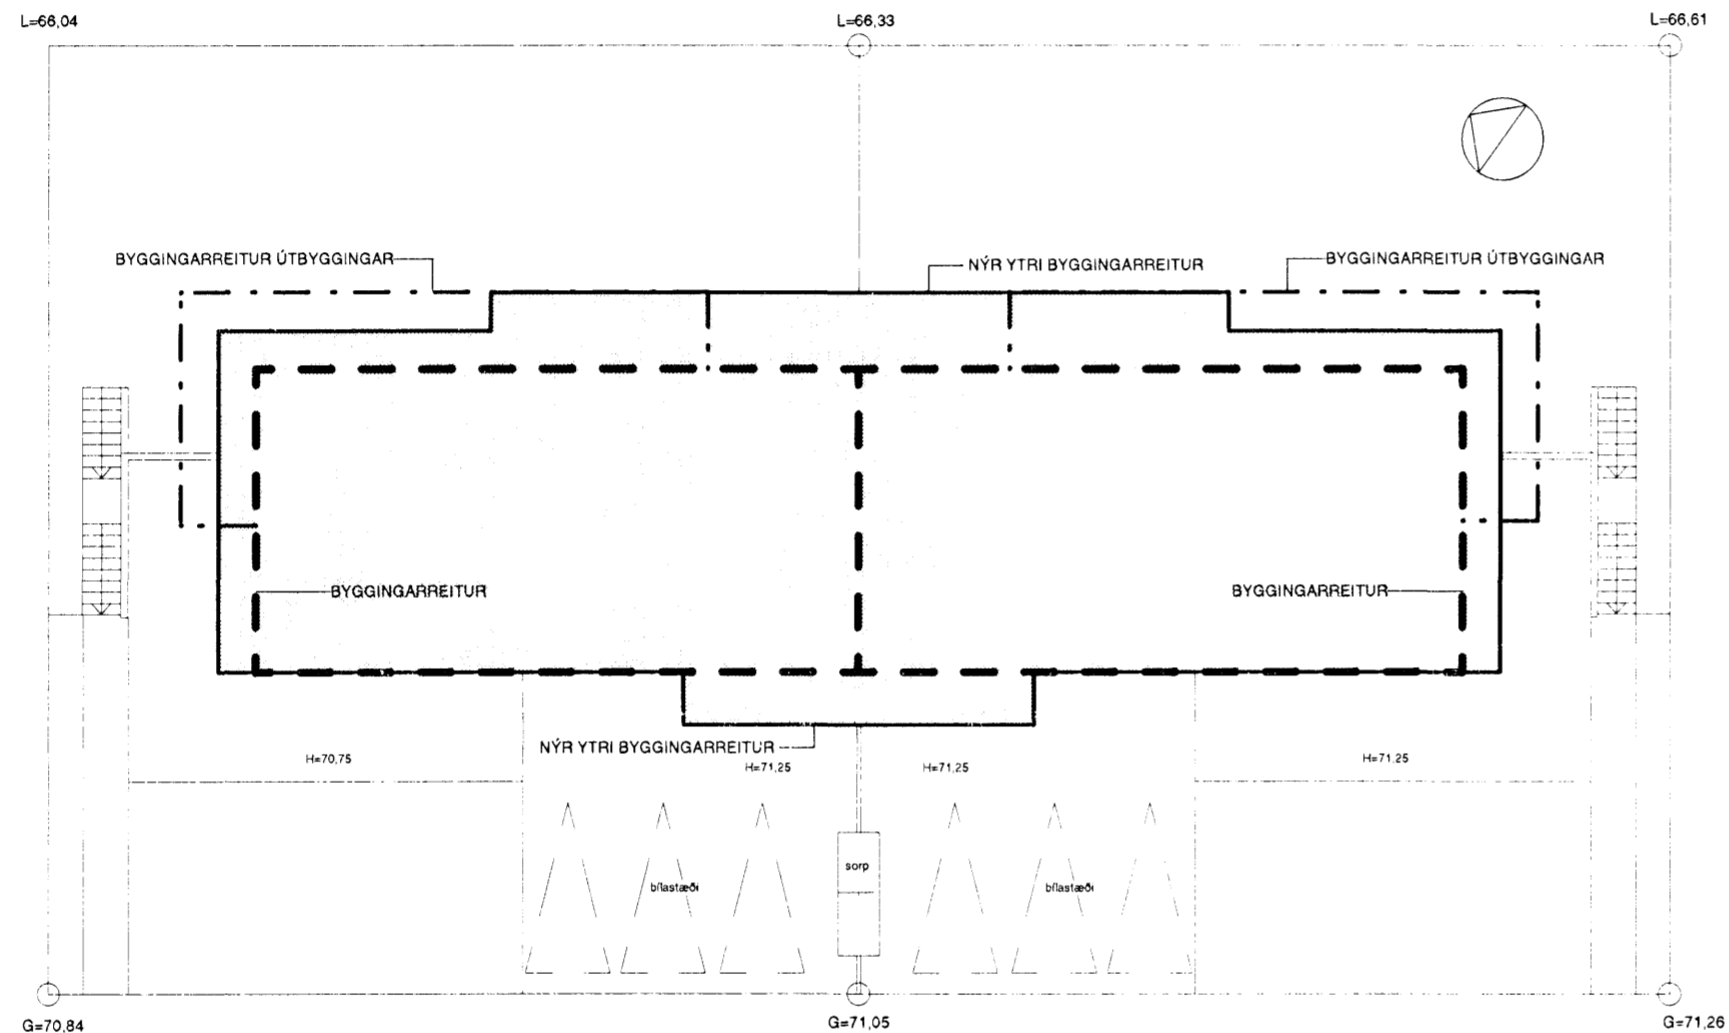

Dags.	Breyting	Teikn.	Útgáfa	 Geirsgötu 9, 101 Reykjavík Sími: 515 0300 Fax: 515 0319 www.ask.is	Verkhelti: <b>FJÓLUÁS 8-10, HAFNARFJÖRÐUR</b> <b>Skilmálateikning</b>	Verk. nr. <b>0698</b> Mkv. í A2 <b>1:200</b> Teikn. <b>VH</b> Dags. <b>27.3.2007</b>
					Aritun arkitekta: <i>Valdimar Harðarson</i> Valdimar Harðarson kt. 050151-2559	Teikn. nr. <b>A-05</b> Útgáfa