




norð-austur

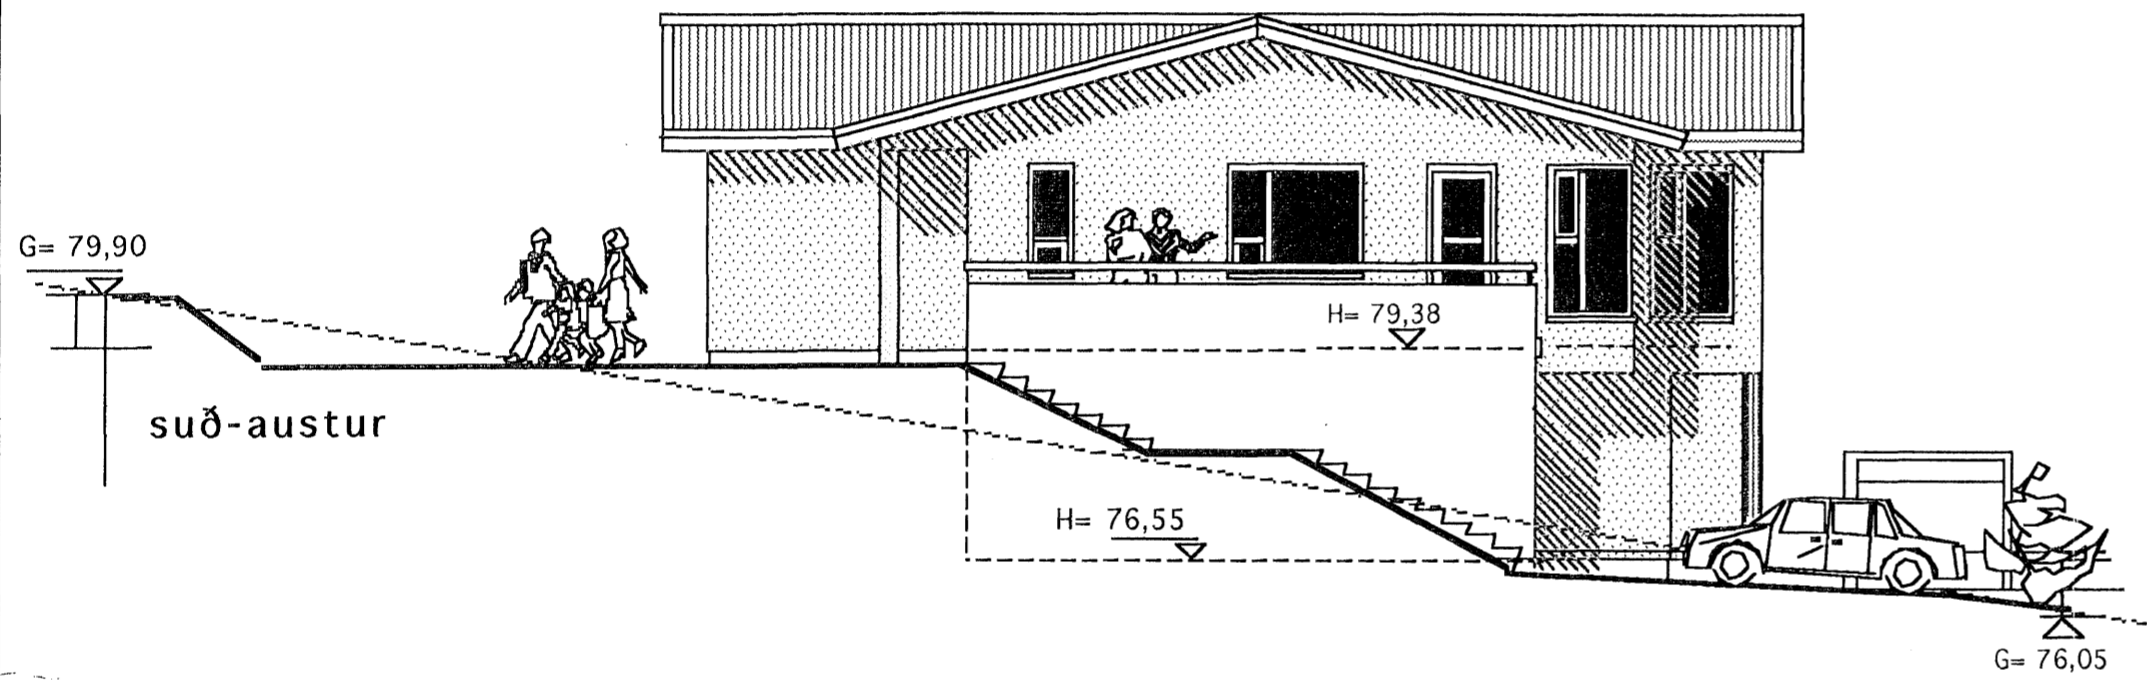



suð-austur

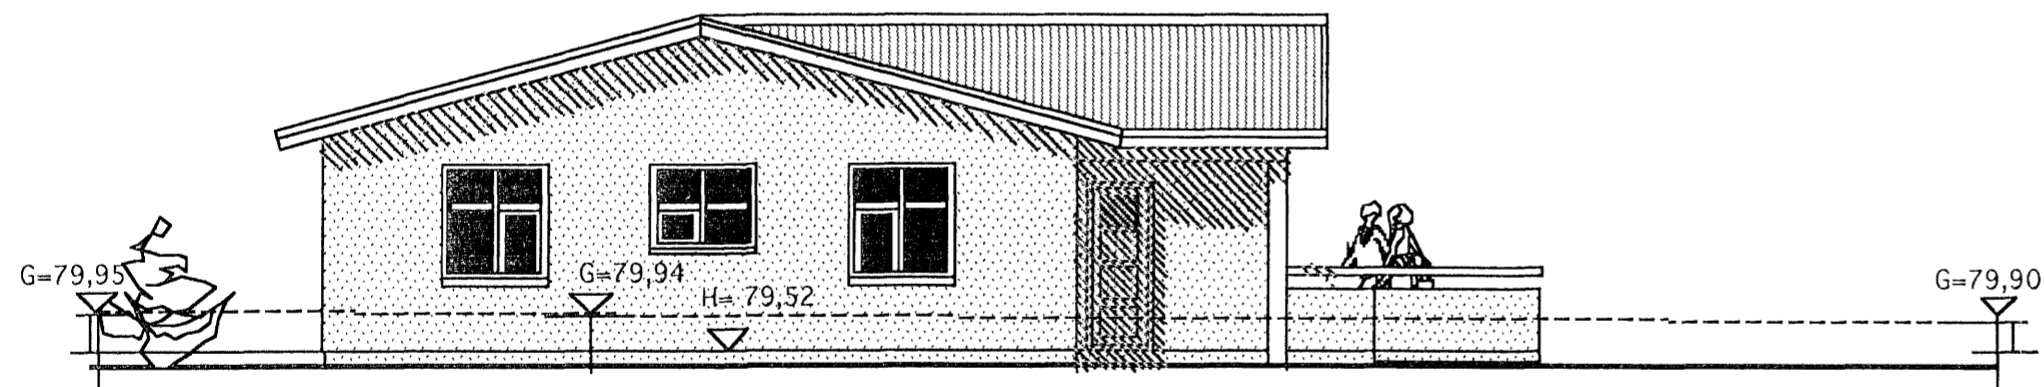

suð-vestur

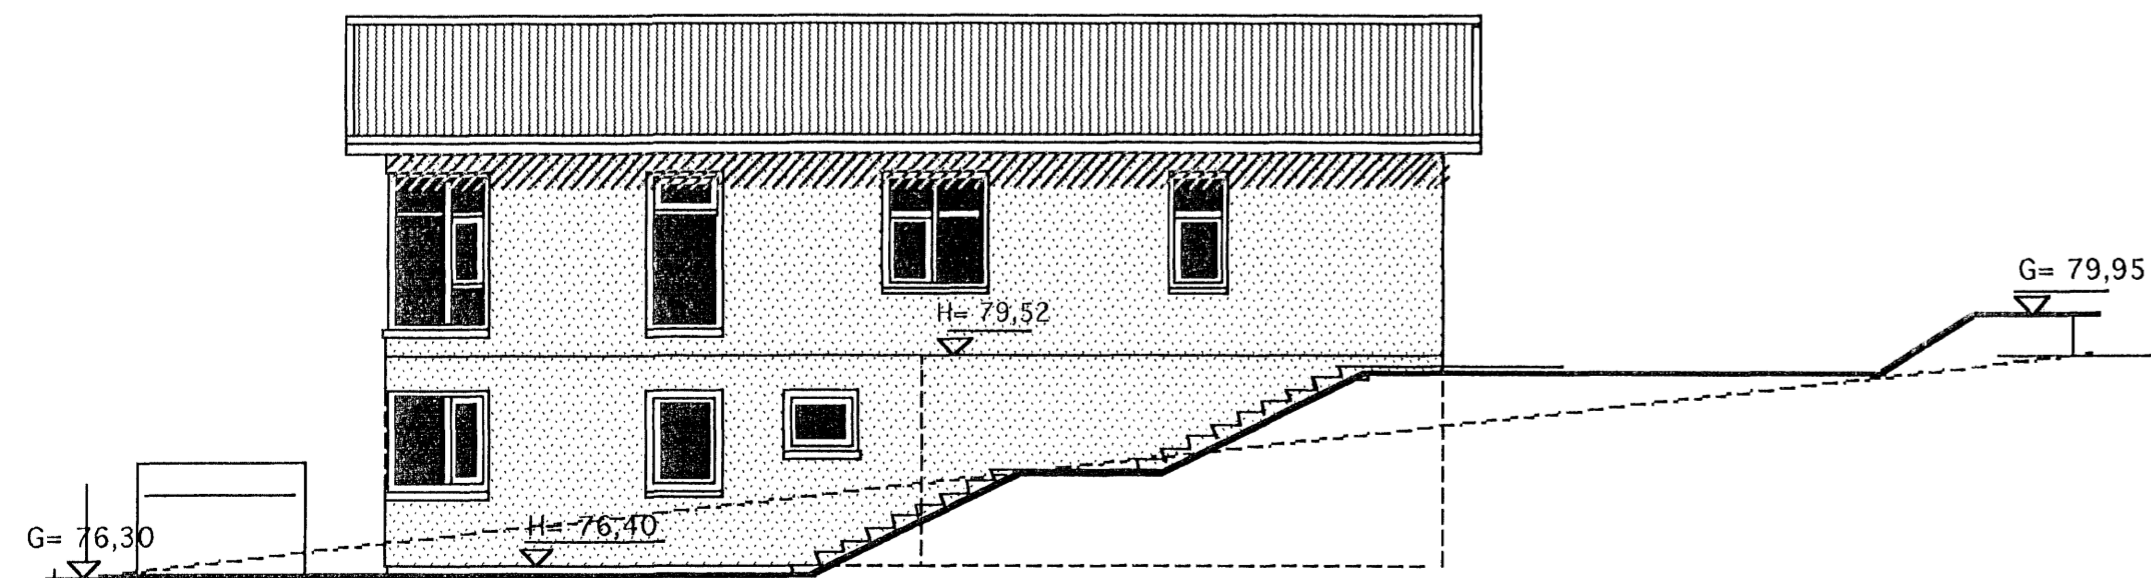

Norð-vestur

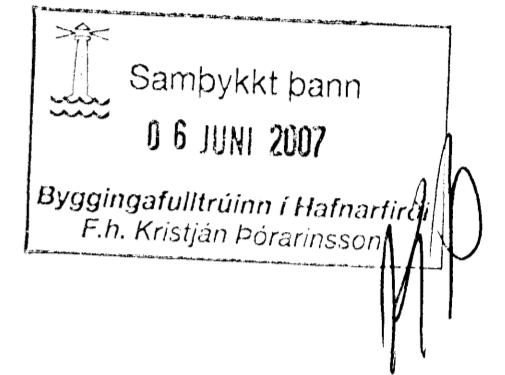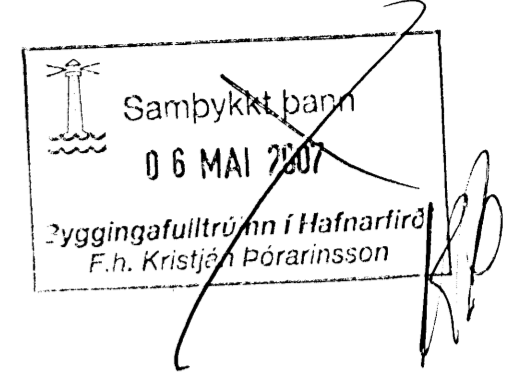

BREYTT 5. JÚNÍ .2007

Hjóla og sorpgeymsla suð-austan við bílgeymslu tekin út.  
Sorpgeymsla sett framan við hús.

	Verkefni FURUÁS 41 HAFNARFIRÐI
	Heiti ÚTLITSMYNDIR
kvarði 1:100	verk.nr
dags. 6. MAÍ.2007	dags b. 5. JÚNÍ .2007
hönnun G. G.	teikn nr
teikn G. G.	<b>A-3</b>

Hringbraut 17 220 Hafnarfirði  
s. 555-2020 FAX 555-2021  
Gísli G. Gunnarsson BFI kt. 020649-2409  
kvardi@vortex.is

