

GRUNNMYND 6. HÆÐ 1:100


b-b  
10-20

UTGAFA 1 TILBOÐ 1 SAMÞYKKT 1 DAGS

ASK Arkitektar  
Geisgötu 8  
101 Reykjavík  
Sími 515 0300  
Fax 515 0319  
www.ask.is



Artun aðalhönnuðar: *Þórunn*  
Páll Gunnlaugsson arkitekt FAI, kl. 210552-2199

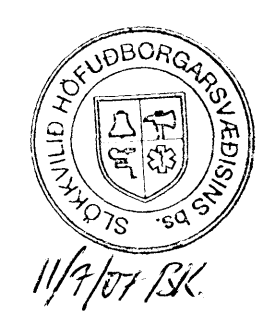

SKIPALÖN 10-14  
ADALTEIKNING

VERKFRÉTTI  
HEITI VERKFRÉTTINGAR  
Grunnmynd 6. hæð

0687 NÖMUR TEIKNINGAR 10-06

MKV 1 A1  
1:100  
TEIKNAD HP  
DAGS 10.07.2007  
UTGAFA