

UTGÁFA | TEIKNAD | SAMÞYKKT | DAGS
BYGGINGAR

ASK Arkitektar
Geingölu 9
101 Reykjavík
Sími 515 0300
Fak 515 0319
www.ask.is



Antun aðilhognuðar:
naunammul
Páll Gunnarsson arkitekt FAU/kl. 210552-2199


SKIPALÓN 10-14
ADALTEIKNING

VERKEFNI
HEITI TEIKNINGAR
Grunnmynd kjallari

11/7/07 BSK

0687 | NÖMUR TEIKNINGAR | 10-02

GRUNNMYND 1:100
kjallari

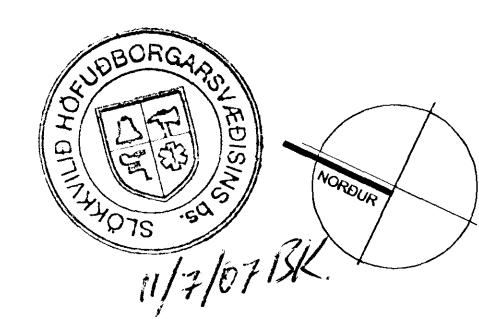

MKV. I. A1
1:100
TEIKNAD
HP
DAGS
10.07.2007
UTGÁFA