

8

7

6

5

4

3

2

1

Byggingafélagið Hafnarfjarðar
Móttæklu þann
10 MAR 2015

F

E

D

C

B

A

F

E

D

C

B

A

SORP.

SORP.

BYOTTAHUS

(01-07)

VELRÆN

LYFTA

TRÖÐUR/STIGAHAUS

(01-09)

(01-05)

(01-04)

(01-03)

(01-02)

(01-01)

STOFA/ELDHÚS

STOFA/ELDHÚS

STOFA/ELDHÚS

STOFA/ELDHÚS

STOFA/ELDHÚS

HJÓN






HJÓN

HJÓN

HJÓN

HJÓN

HJÓN

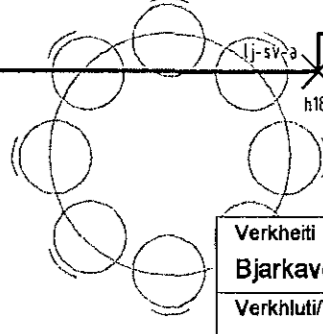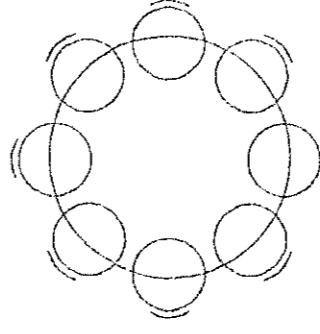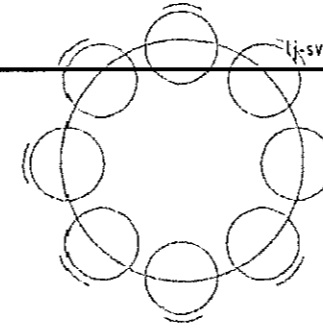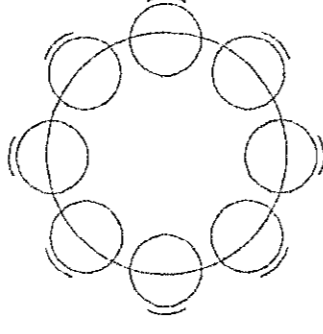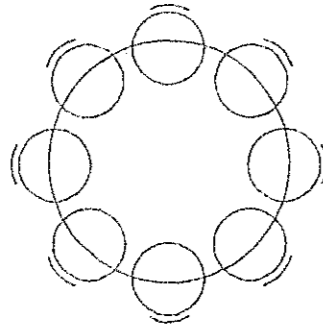

Bjarkavellir 1B, 221 Hafnarfjörður
Verkhúli/Verknúmer
Rafliagnir og smáspennu, 1. hæð
Bláa nr. 3/7 Dags. 26. maí 2008 Kvartí 1:50
Yfirfarir SHVHMK
Hönnuður
Samræmingar hönnuður

Breyting
29. apríl 2008 Lagartíðindur, tekið til brúkerferli og hreyfiskynjara í sameigin
29. ágúst 2012 Enflutnyð, smáspenna, og hvíllaverk.

Reykjavíkurvegi 60 220 Hafnarfjörður
Sími 565 1816, fax 565 0910 gsm 898 0970
http://www.munus.is, e-mak munus@munus.is
MUNUS Hönnuður Sigurjón Harðarson, kt. 060361-2719