



Samþykkt þann
23 MAI 2008
Byggingarfulltrúinn í Hafnarfirði
F.h. Hrólfur S. Gunnlaugsson

ÚTGÁFUERILL			
NÚMÉR:	DAGS:	SKÝRINGAR:	HAUNAD:
B1	25.10.2006	BYGGINGARTEIKNING	HÖÖ
B2	24.08.2007	MÁLSETT GÖT	





DAGS. UNDIRSKRIFTAR: NAFN OG KT. SAMRÆMINGARHÖNNUNAR:
UNDIRSKRIFT SAMRÆMINGARHÖNNUNAR: *Jlep*

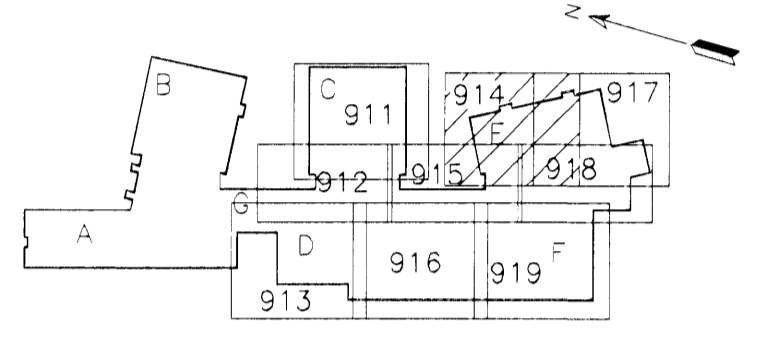


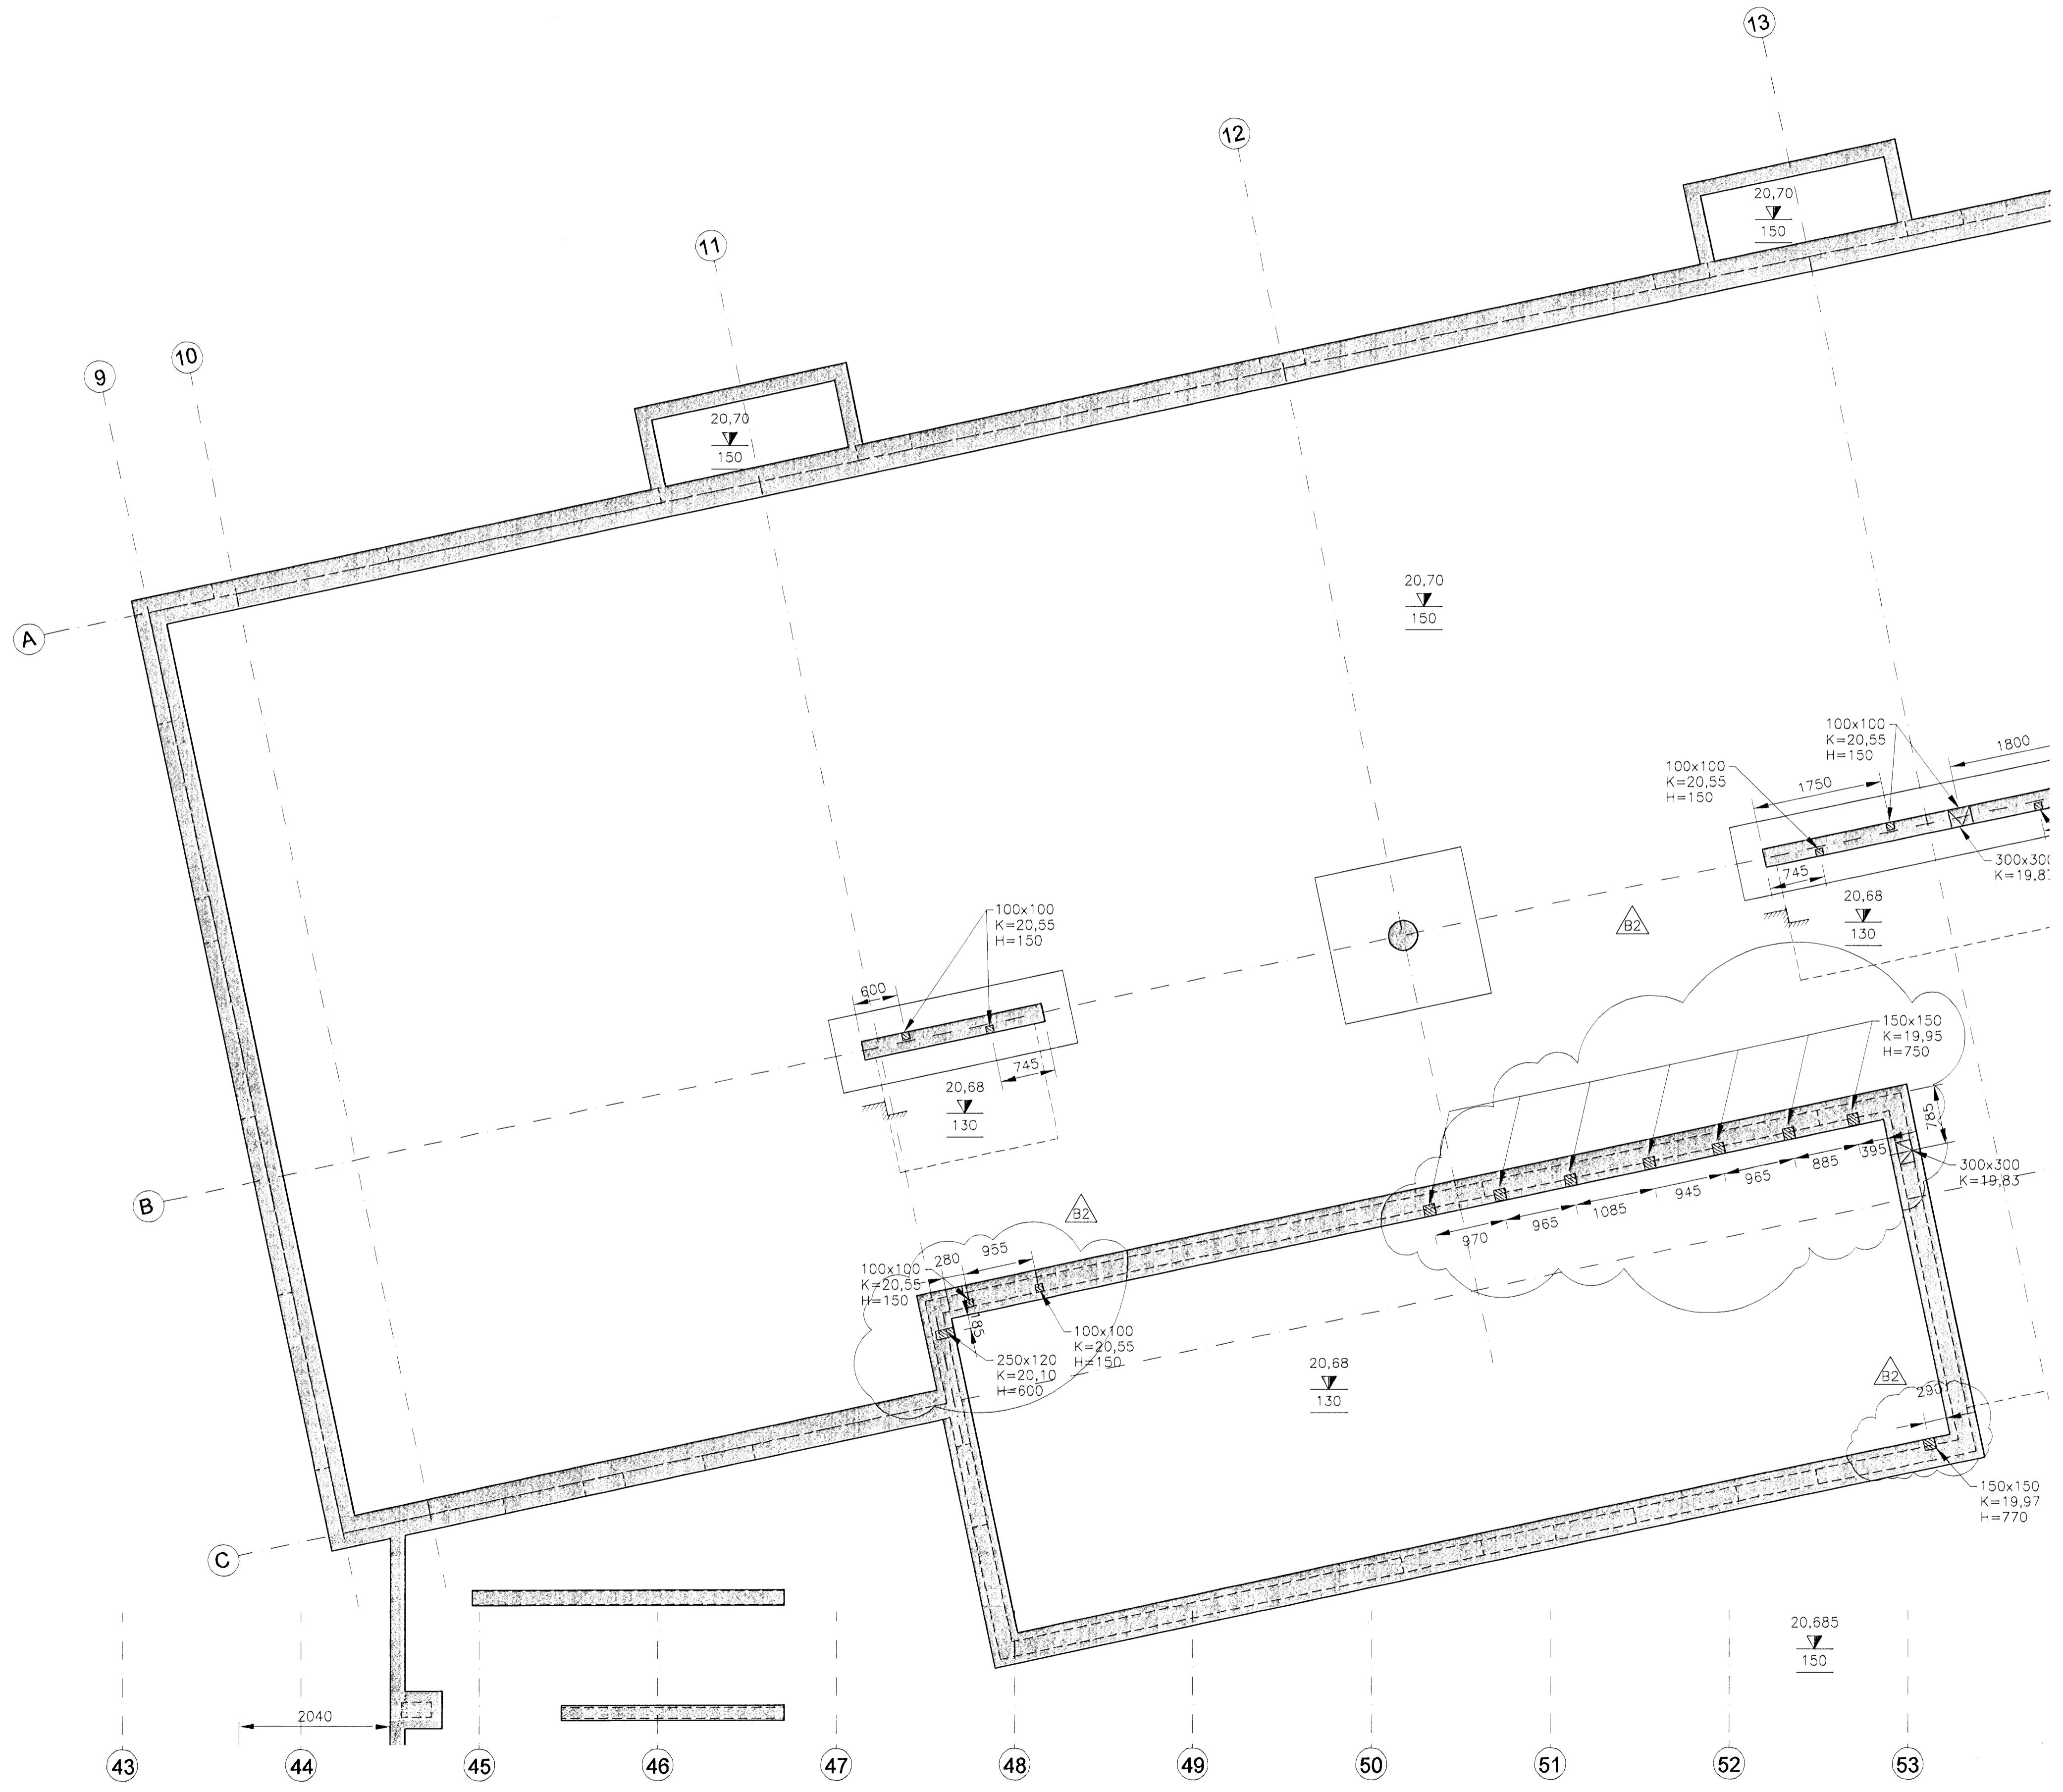LYKILMYND

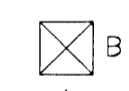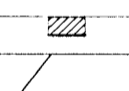

SKÝRINGAR:

- A x B  MERKIR GAT Í PLÖTU STÉRD Amm x Bmm
 -  RAUF Í SÖKKUL EDA VEGG Amm DJÚPA OG Bmm BREIDA NEDRI BRÚN Í KÓTA 10,00m OG HÆÐ 1000mm
 - A x B  GAT Í SÖKKUL EDA VEGG, Amm BREITT OG Bmm Á HÆÐ NEDRI BRÚN Í KÓTA 10,00m
 - VL  AD GAT SÉ FAST VIÐ LOFT
- ÖLL ÓNEFND MÁL ERU Í mm

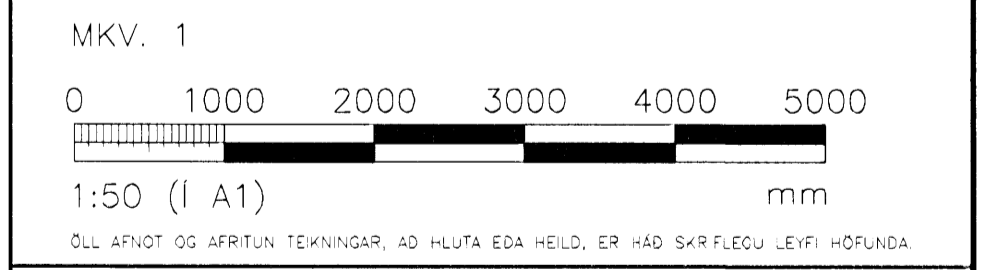

VGK HÖNNUN

GRÉNSÁSVEGI 1 · 108 REYKJAVÍK · Sími: 422 3000 · Fax: 422 3001
VEFFANG: www.vgkhonnun.is · NETFANG: vgkhonnun@vgkhonnun.is

HÉTI VERKS:
**HRAUNVALLASKÓLI 2. ÁF.
DREKAVELLIR 9, HAFNARFIRÐI**

HÉTI TEIKNINGAR:
GATAPLAN:
UNDIRSTÖÐUR
GRUNNMYND

MELT:	TEIKNAD:	DEYMSLUNUMER:	VNR:
	LS		3.151.218

HAUNAD:	YFIRFARID:	MKV:	NR TEIKNINGAR:
HÖÖ/BIO/PIB	JGG	1:50	

DAGS. UNDIRSKRIFTAR: NAFN OG KT. HÖNNUNAR: **B2-914**
VGK-HÖNNUN hf 430572-0169
UNDIRSKRIFT HÖNNUNAR: **LARUS ARSÆLSSON** 2008625119
GÖTAFAR: B2

GRUNNMYND
MKV. 1