

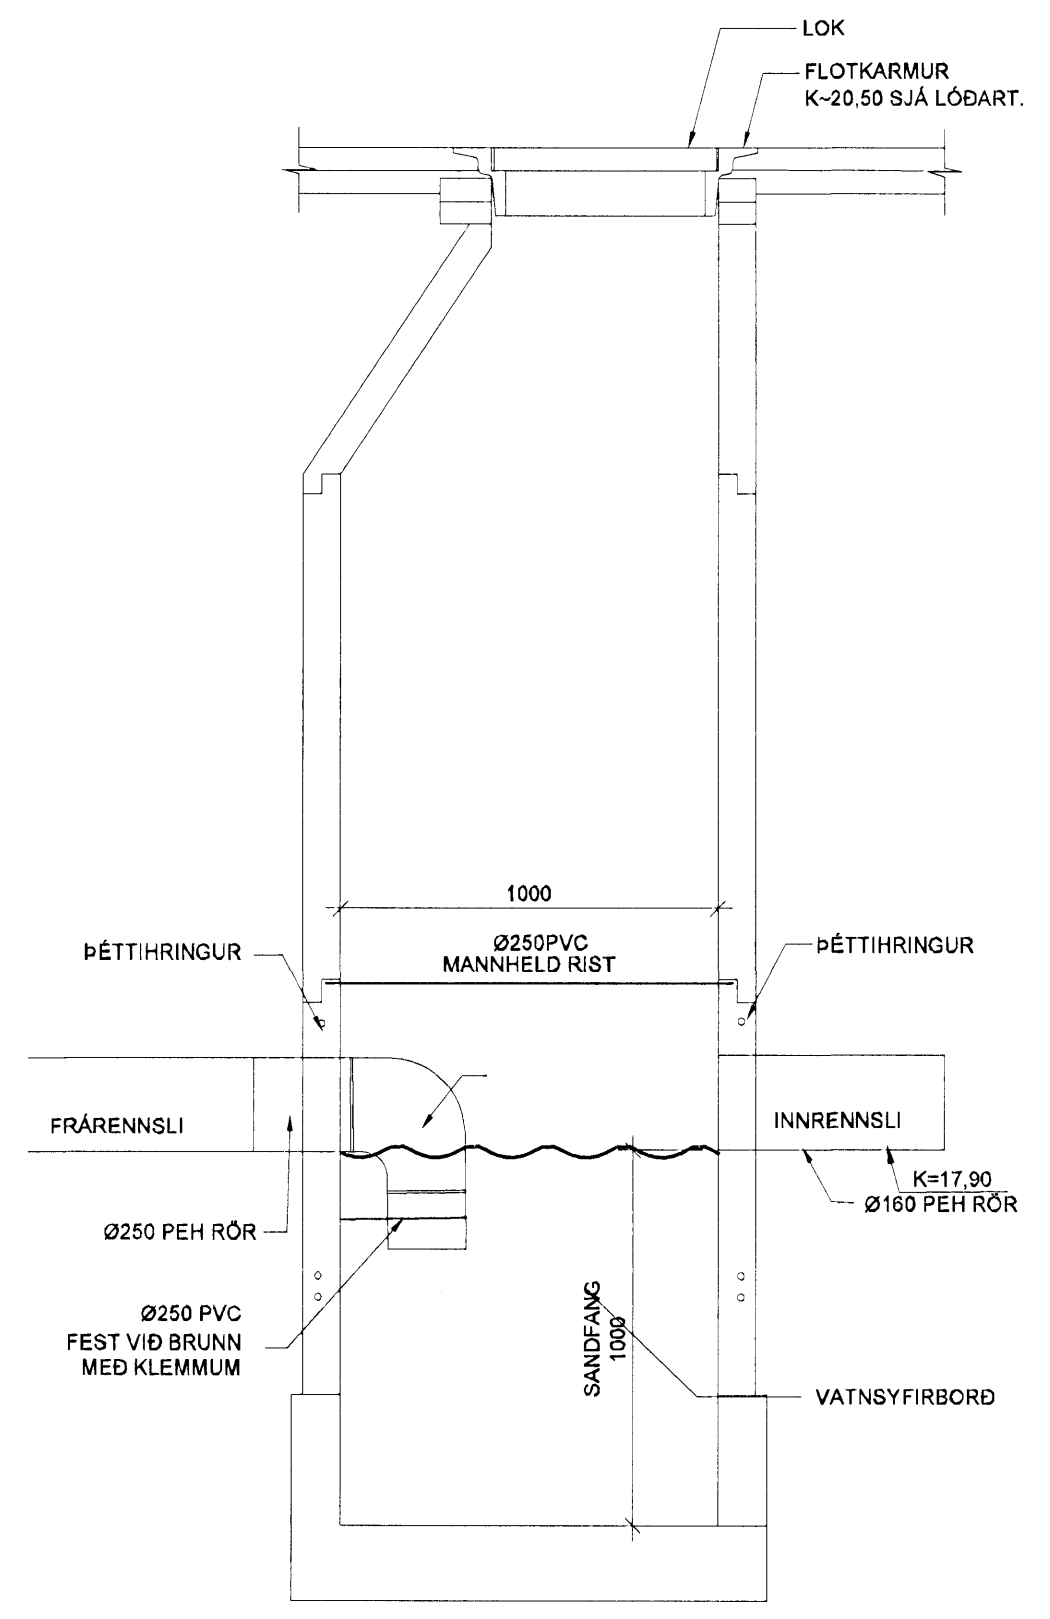
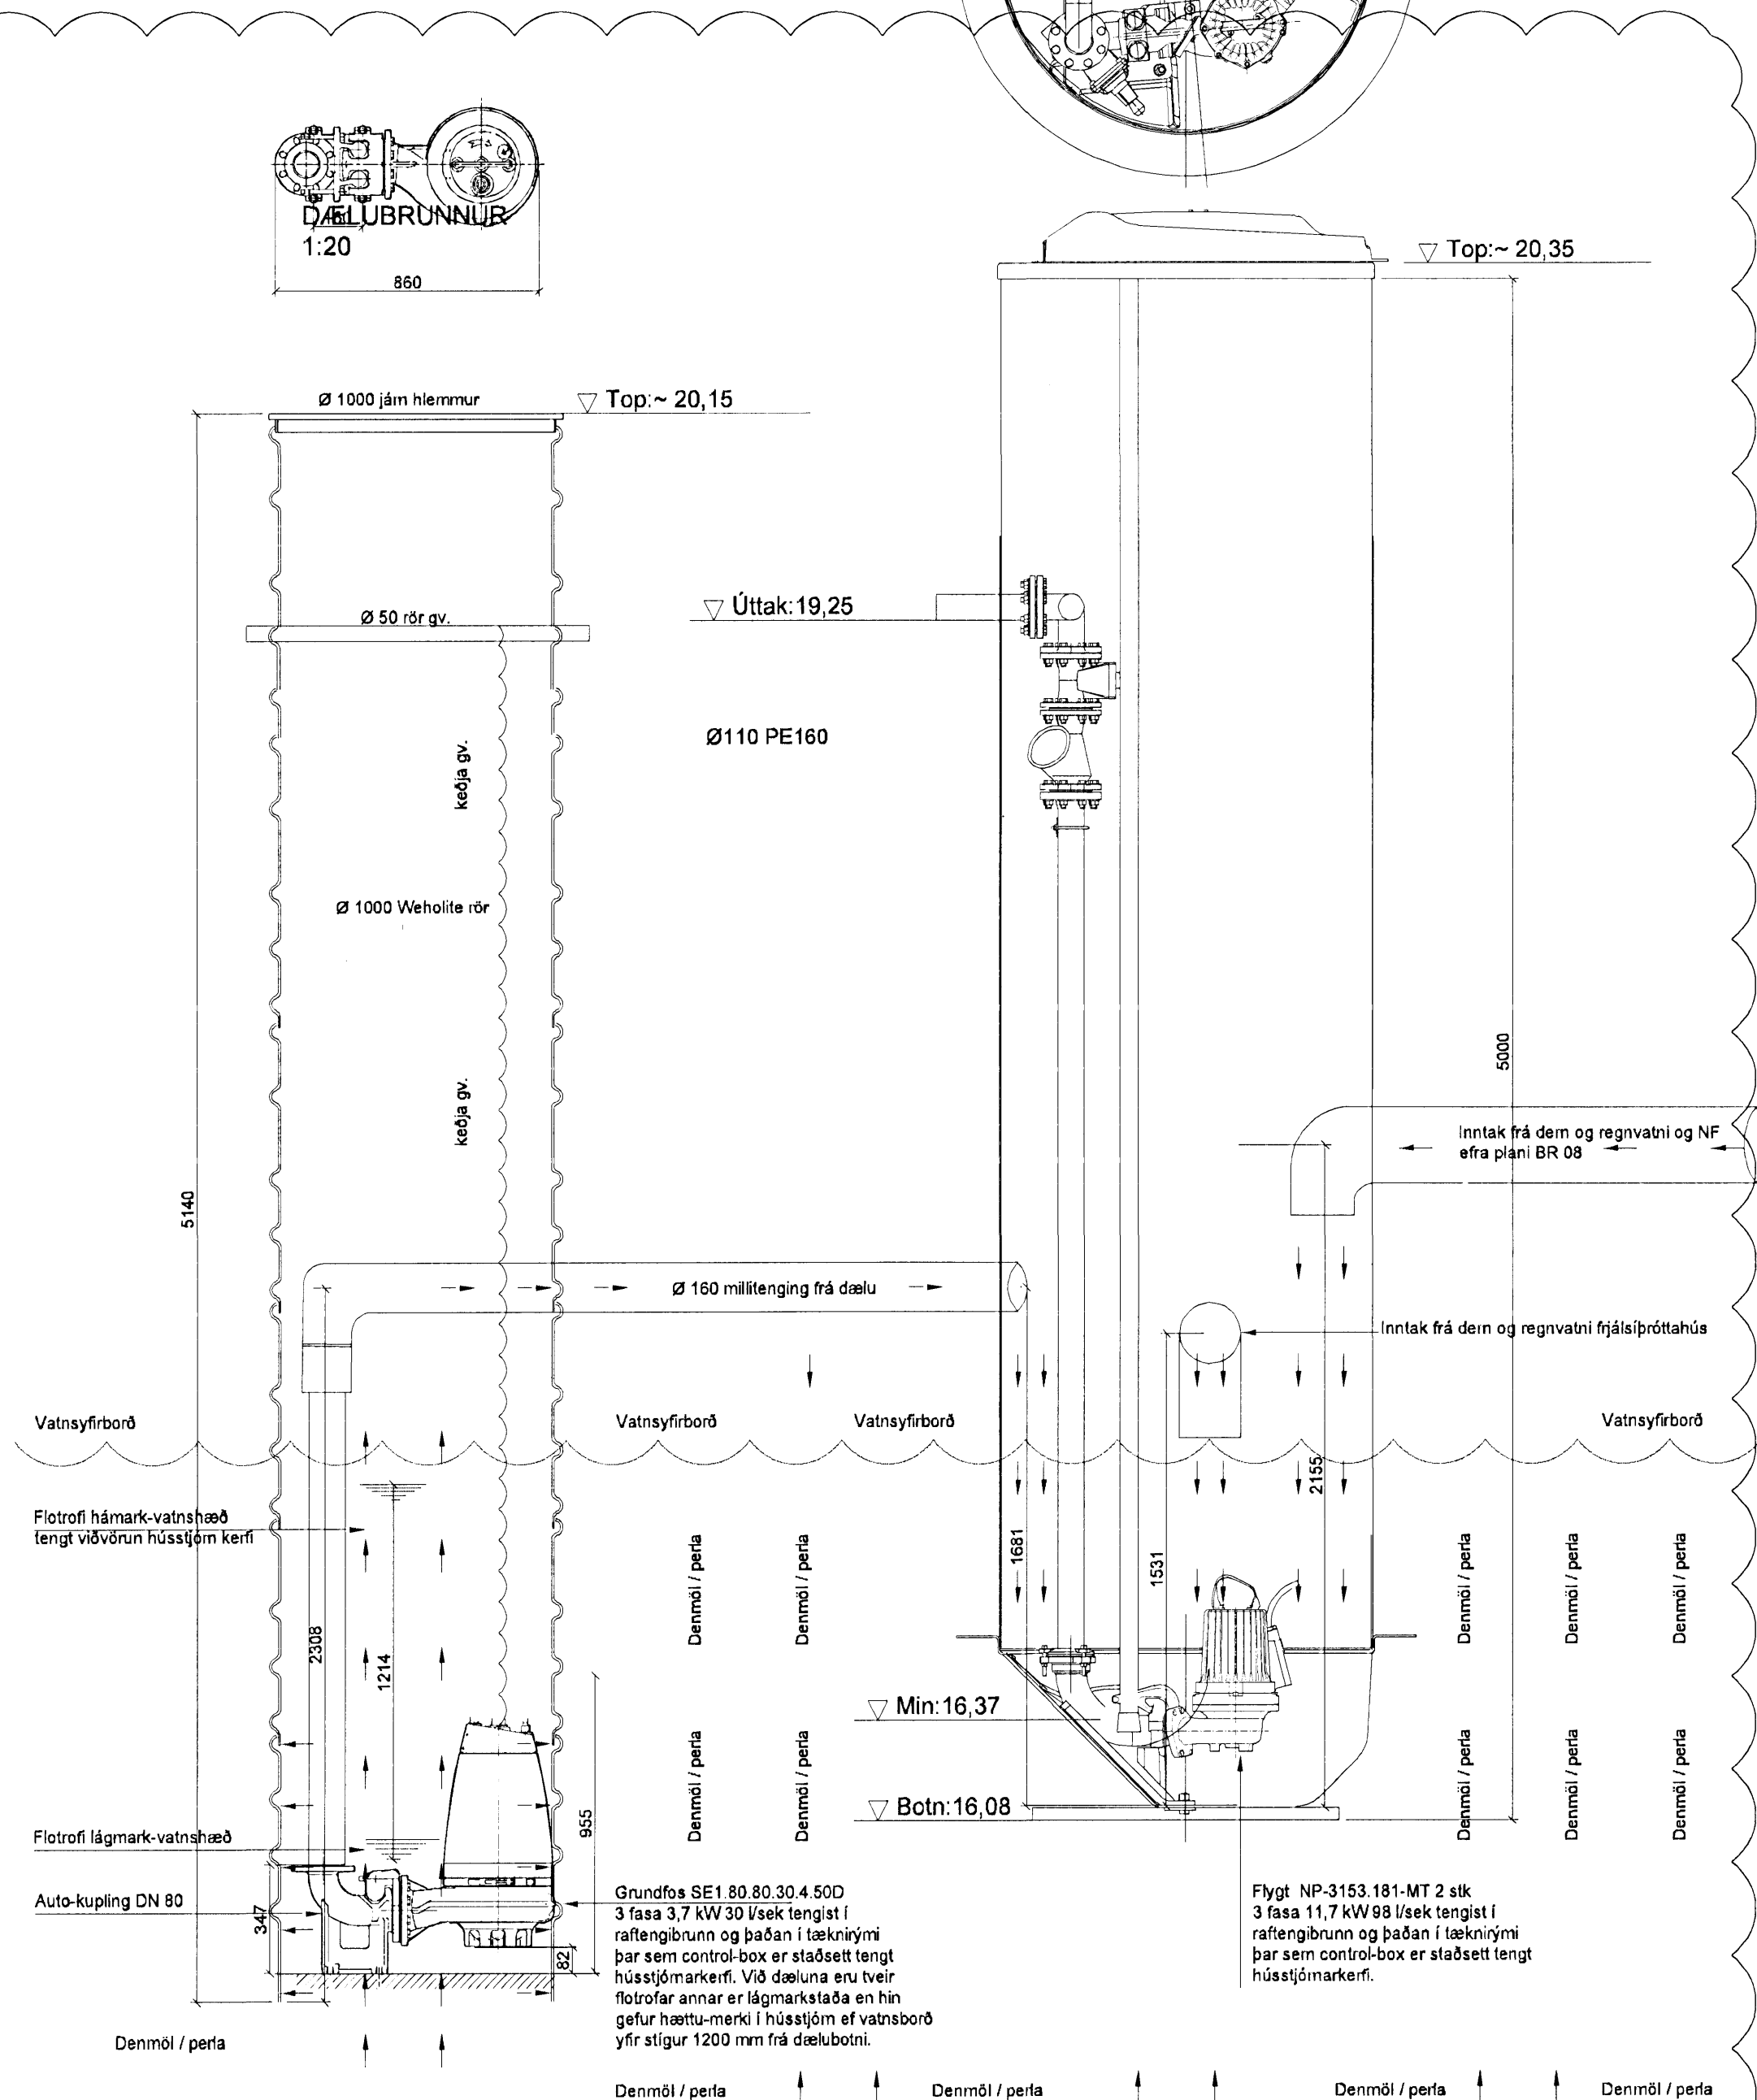



SANDFANGSBRUNNUR FRJÁLSÍP. MED VATNSLÁS

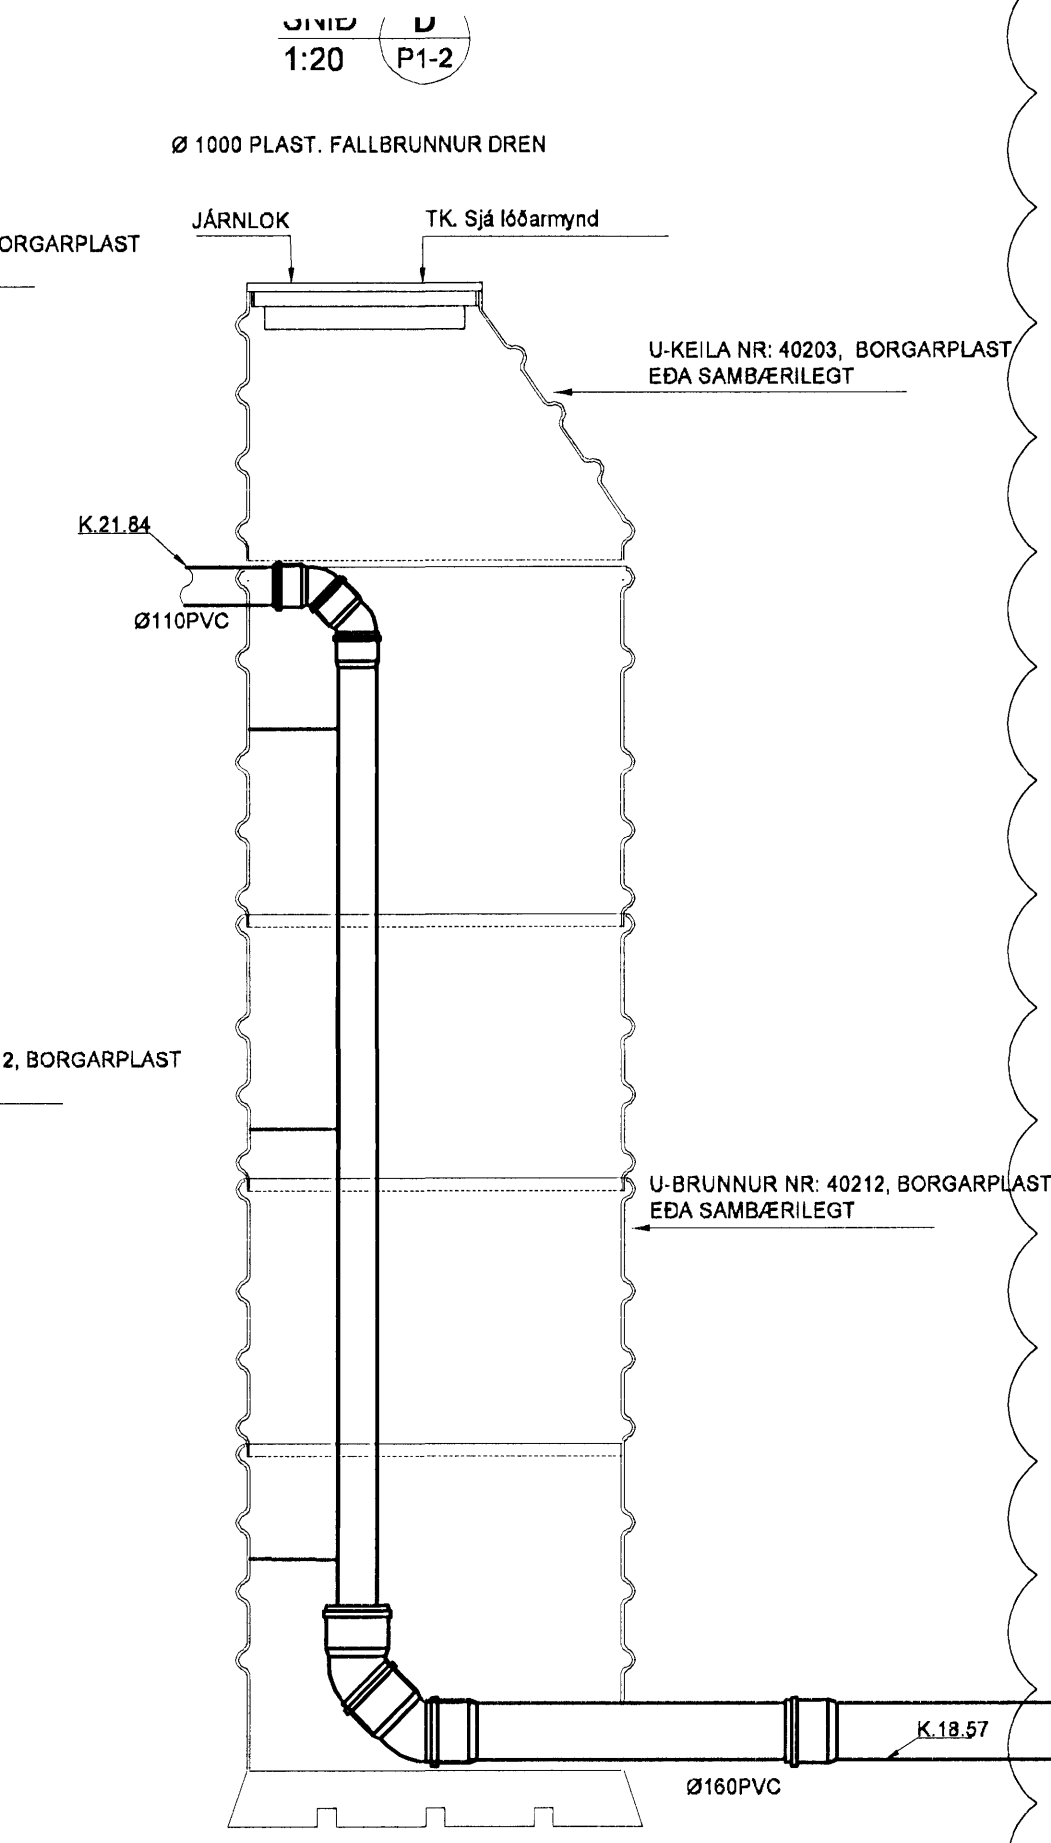

Byggingafrulltrúi Hafnarjörður
Algreitt þann
- 1. AUG 2008
Björg

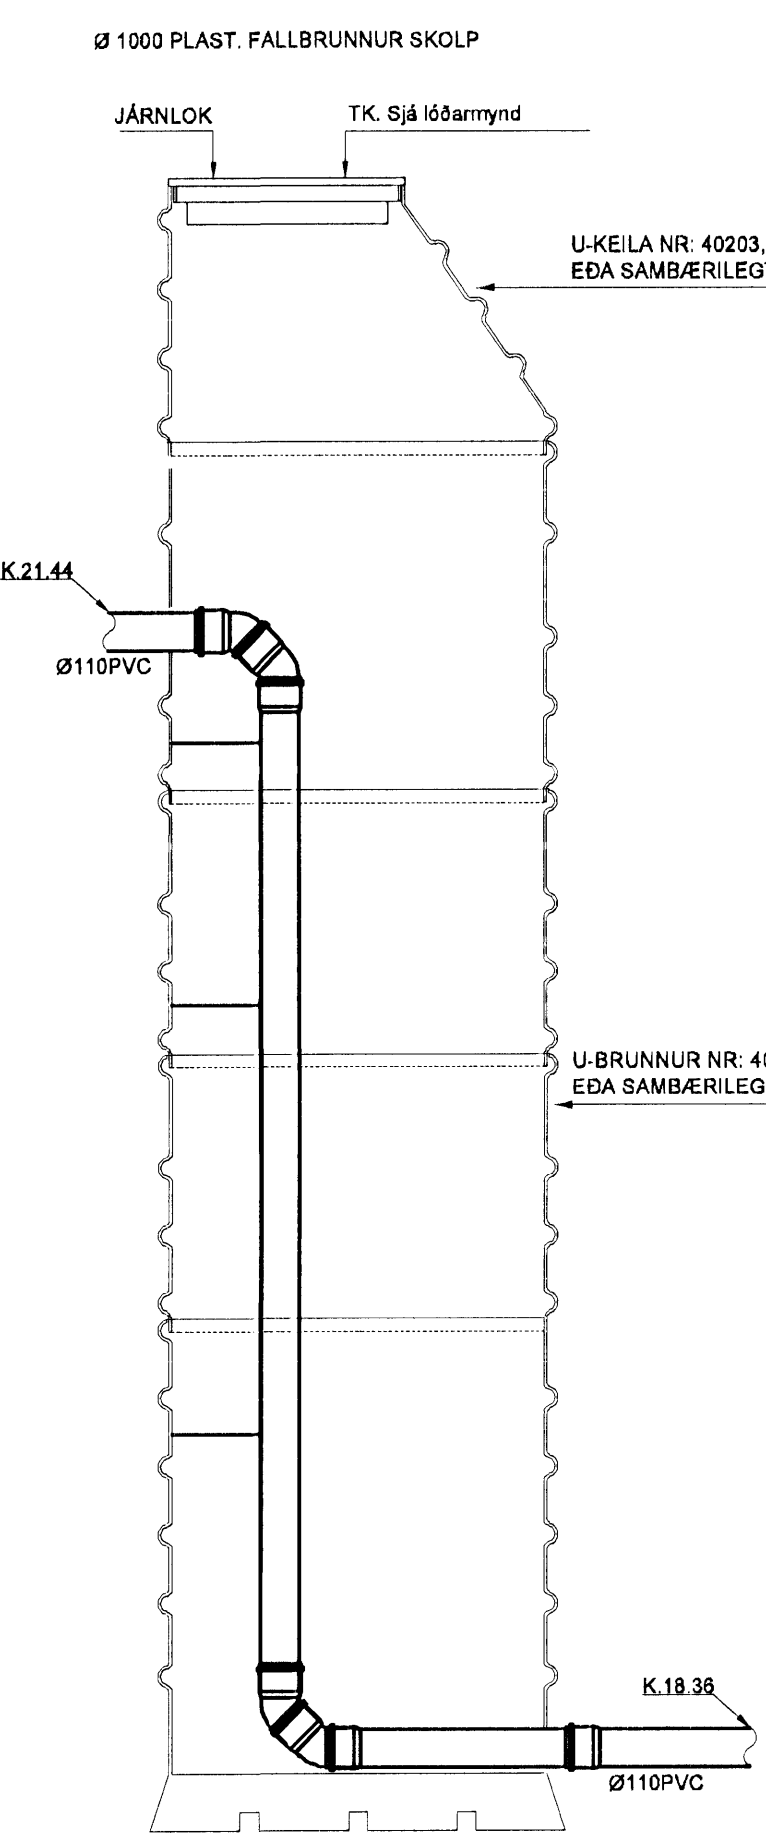


SANDFANGSBRUNNUR PLAN MED VATNSLÁS

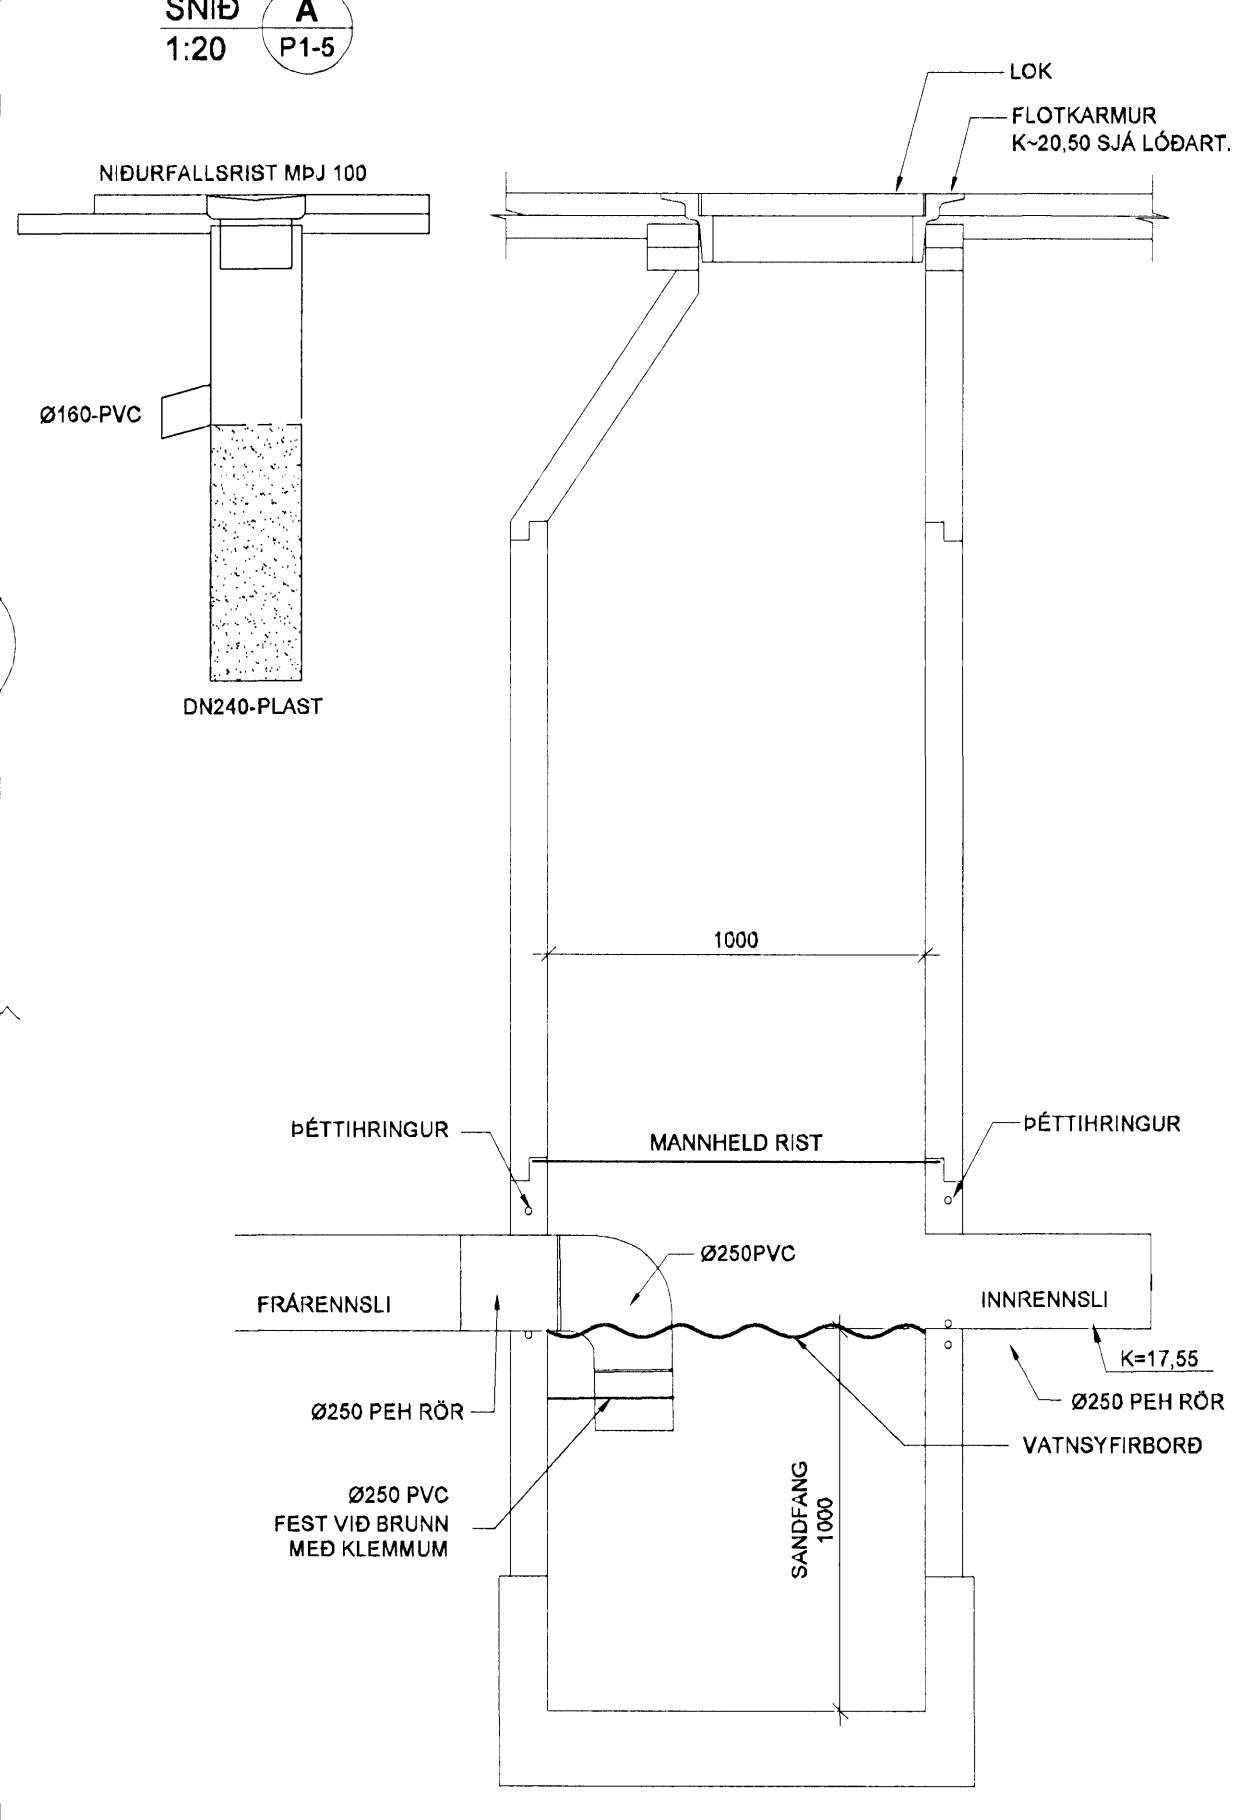

BATTERIID

0604
08-08-08

KAPLAKRIKI

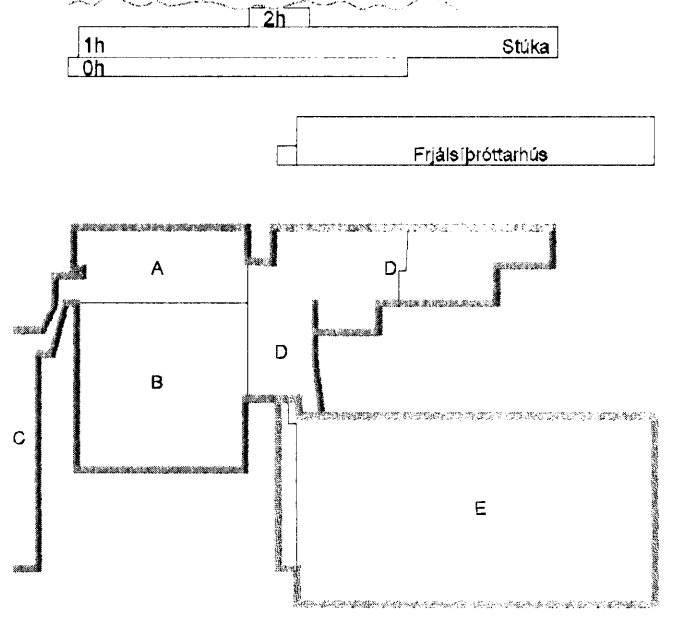

| | | | |
|------------|----------|---|----------------|
| E | 22.07.08 | Auka dælubrunnur | KMJSÁS |
| D | 14.12.07 | Breyting á sniði F → ný snið sett inn (sky) | KMJSÁS |
| C | 07.12.07 | Innsattur sandfangsbrunnur | KMJSÁS |
| B | 23.11.07 | Kötum breytt í dælugryfu | KMJSÁS |
| A | 12.11.07 | Breyting á dælugryfu | KMJSÁS |
| Útg. Dags. | | Skýring | Hanna Öryfarió |



VERKFRÆDISTOFA

BÆJARHRAUN 20 · 220 HAFNARJÖRÐUR · KENNIT. 710796-2899
vsb@vsb.is · Sími 585 8600 · Fax 585 8610 · www.vsb.is

Áritun sérhönnuðar
Sveinn Áki Sverrisson Kt. 230855 8600

KAPLAKRIKI
HAFNARFIRÐI

Verkefni:
Lagnir
Grunnlagnir
Snið og deili

| | | | | |
|-------|----------|----------|----------|--------|
| Hanna | Teiknað | Yfirfarð | Kvarð | Síða |
| KMJ | KMJ | SÁS | 1:20 | /A1 |
| Dags. | 14.08.07 | Verkefni | Teikning | Útgáfa |
| | | 0014 | 0014 | F |