

Samþykkt þann
07 MAI 2008
Byggingarfulltrúinn í Hafnarfirði
F.h. Hrölfur S. Gunnlaugsson

Dr. Einar
Kt. 110457-2789

Strendingurehfi
Strendingur ehf.
Flakdaga 13-15, 2nd fl. Hafnarfirði
Sími 565 5840 • strendingur@strendingur.is
www.strendingur.is

△	SUBMITTAL FOR RECORD	5/26/08
△	REVISED STARTING PLATFORM ANCHORS	10/2/07
△	REVISED FOR WALL FOOT LEDGE	8/8/07
NO.	DESCRIPTION	DATE
REVISIONS		

NATARE
CORPORATION
5905 W. 74th Street
Indianapolis, IN 46278-1788
(317)280-8828
Fax: (317)280-9988


These drawings and the design, concepts, illustrations, and written information represented hereby are the property of Natara Corporation and shall not be distributed, copied, reproduced, or stored in any manner except upon the expressed written consent of Natara Corporation. The recipient hereby acknowledges the confidential and proprietary nature of these drawings and acknowledges Natara's proprietary interest therein and agrees not to use these drawings or the data and concepts depicted herein except for the fabrication of the physical objects herein for and on the behalf of Natara Corporation.

© 2007 NATARE CORPORATION


PAGE TITLE:
BULKHEAD ELEVATIONS

DATE: 10/8/07
FILE: Movable Bulkhead.dwg
LAYOUT: Bulkhead Elevations
DRAWN BY: SAL
CHECKED BY: MTW
PROJECT NO.: SHEET NO.:
7.1

1. Do not scale drawings. Refer to or request specific dimensions.
2. Specific dimensions are assumed to be accurate. However, do not use for construction unless verified and certified.
3. Dimensions and details are subject to change without notice unless drawings are certified.
4. For clarity or reference, certain equipment or areas of construction may be shown. Do not assume all items or work illustrated on these drawings to be furnished by Natara Corporation. Refer to equipment schedule or scope of work for specific details.
5. When related work or equipment is shown, such as structure is for information or clarity only. Always refer to appropriate documents for specific details or instructions.

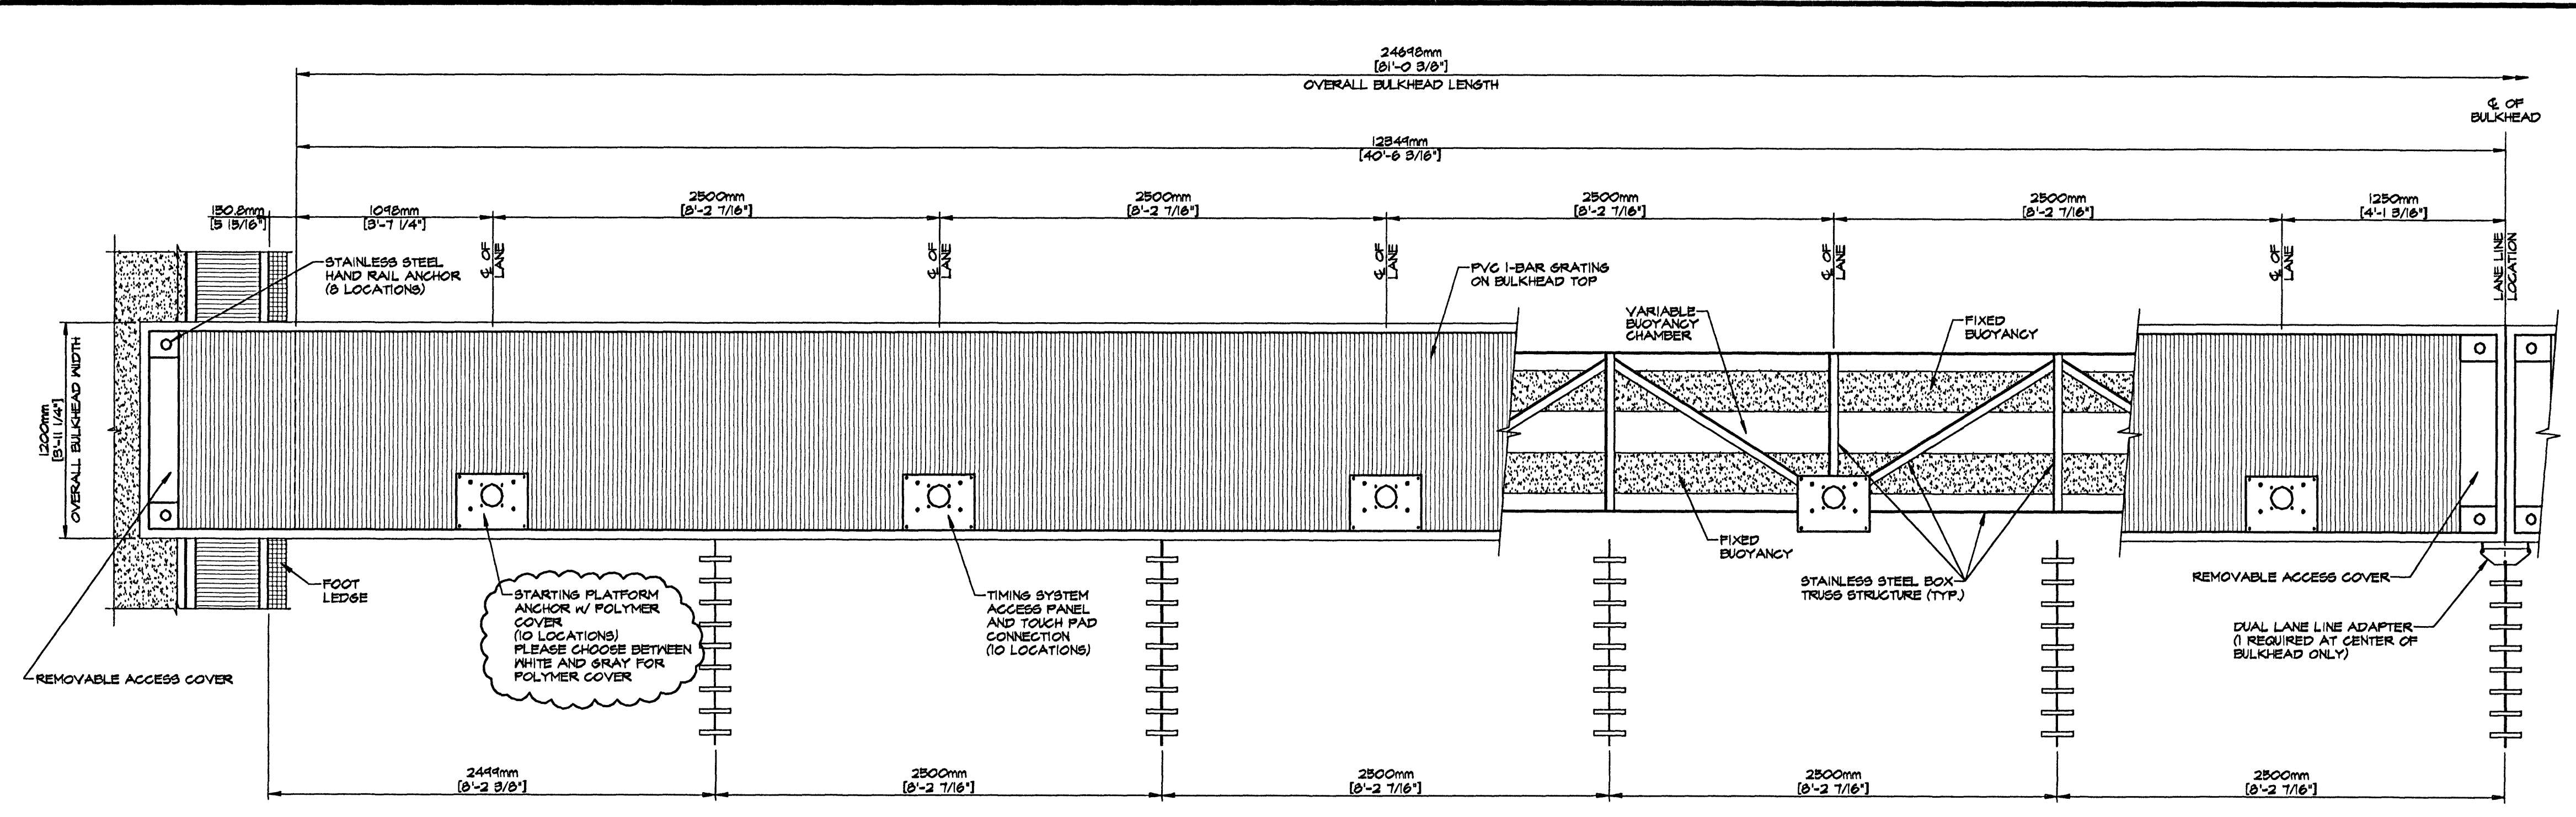

BULKHEAD PARTIAL PLAN VIEW

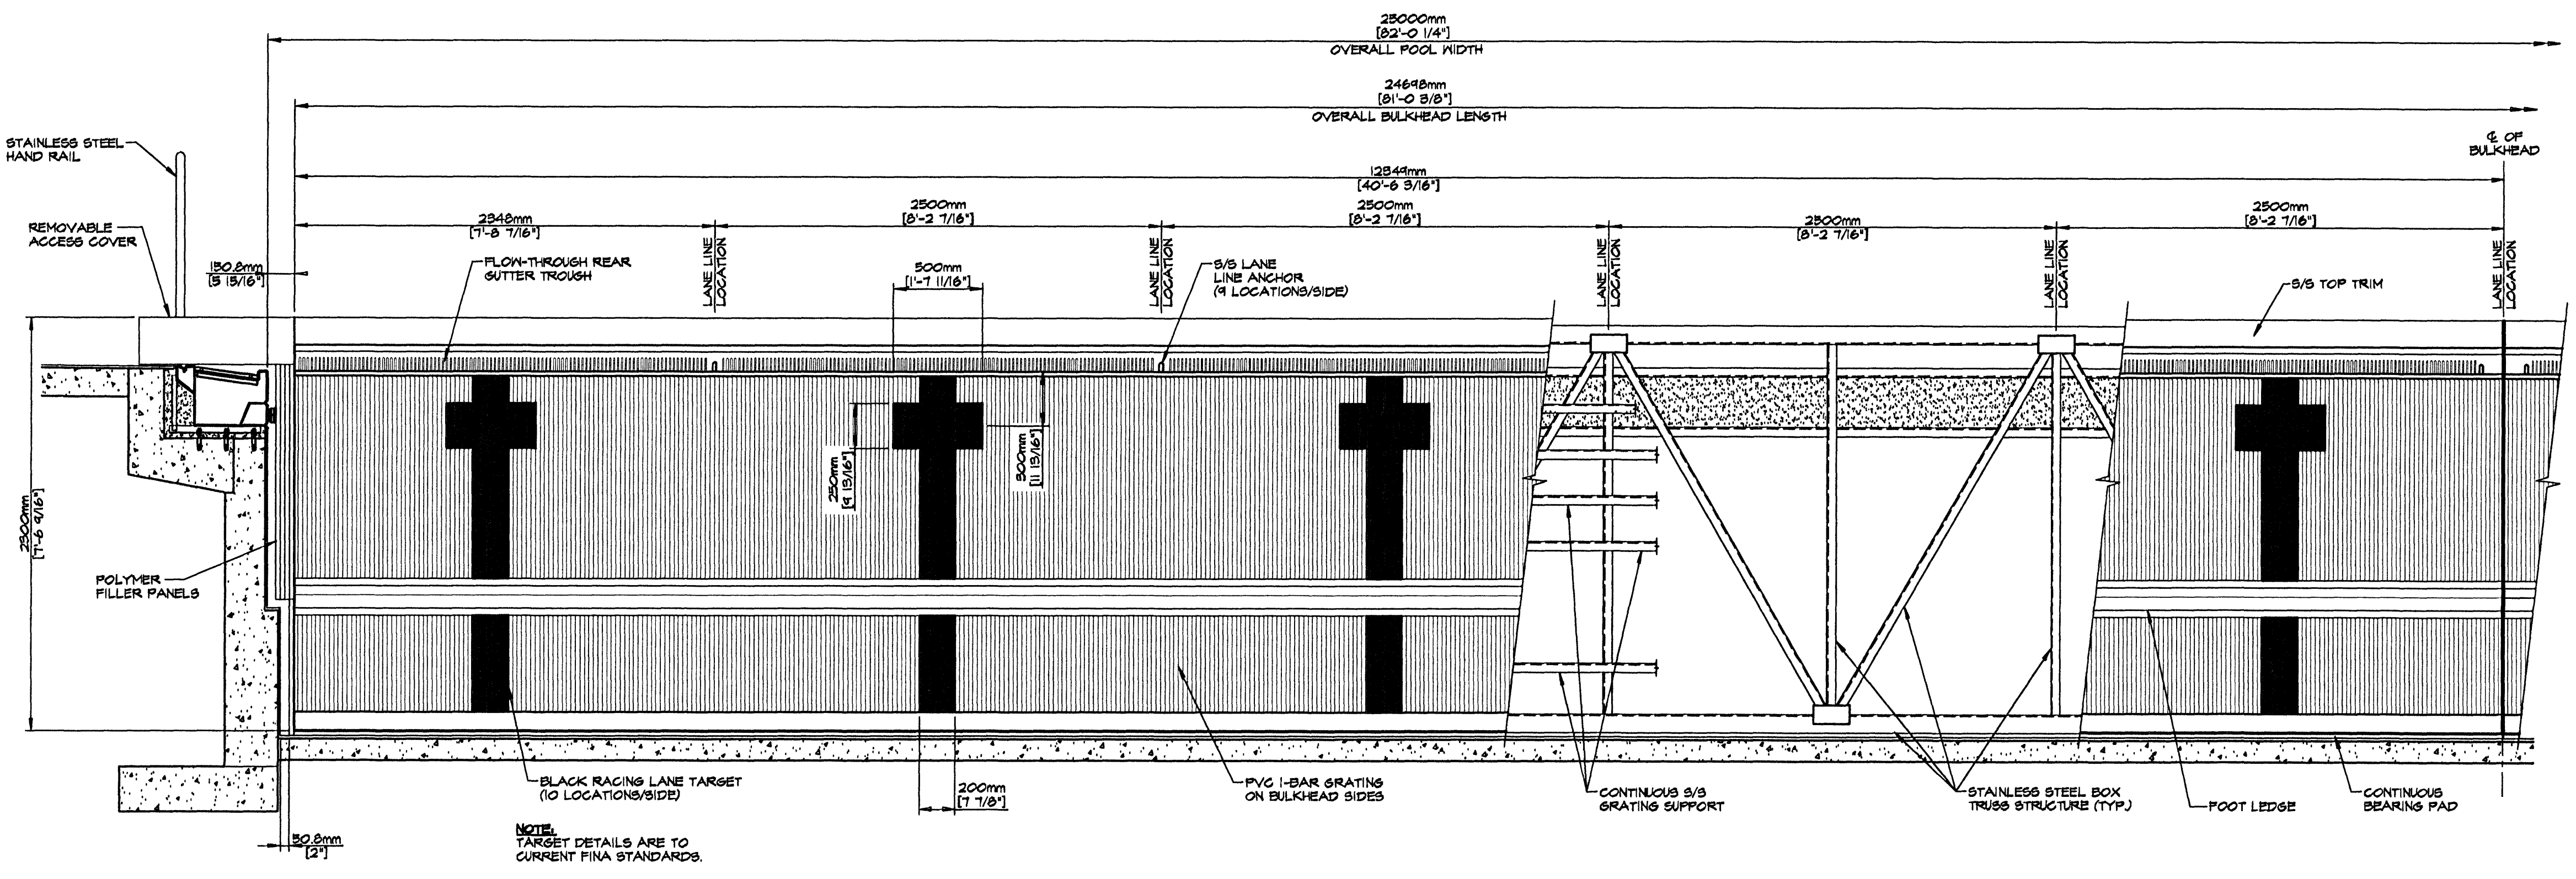

BULKHEAD PARTIAL SIDE VIEW