

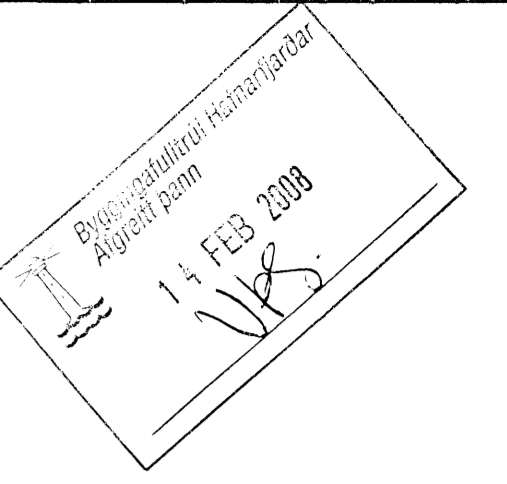


HÚS 9b - LAGNIR Í GRUNNI GRUNNMYND 1:50

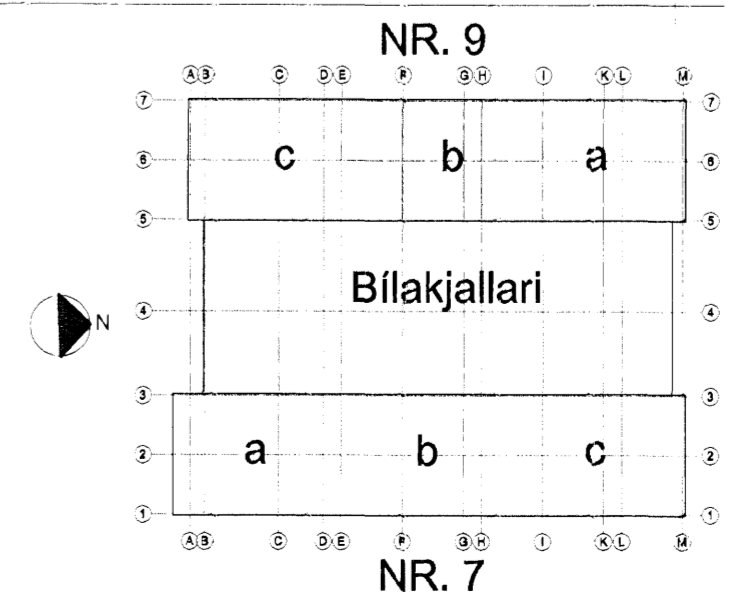

ARITJÓFNAÐSAMRÆMINGARHÖNDUÐAR *palmars*

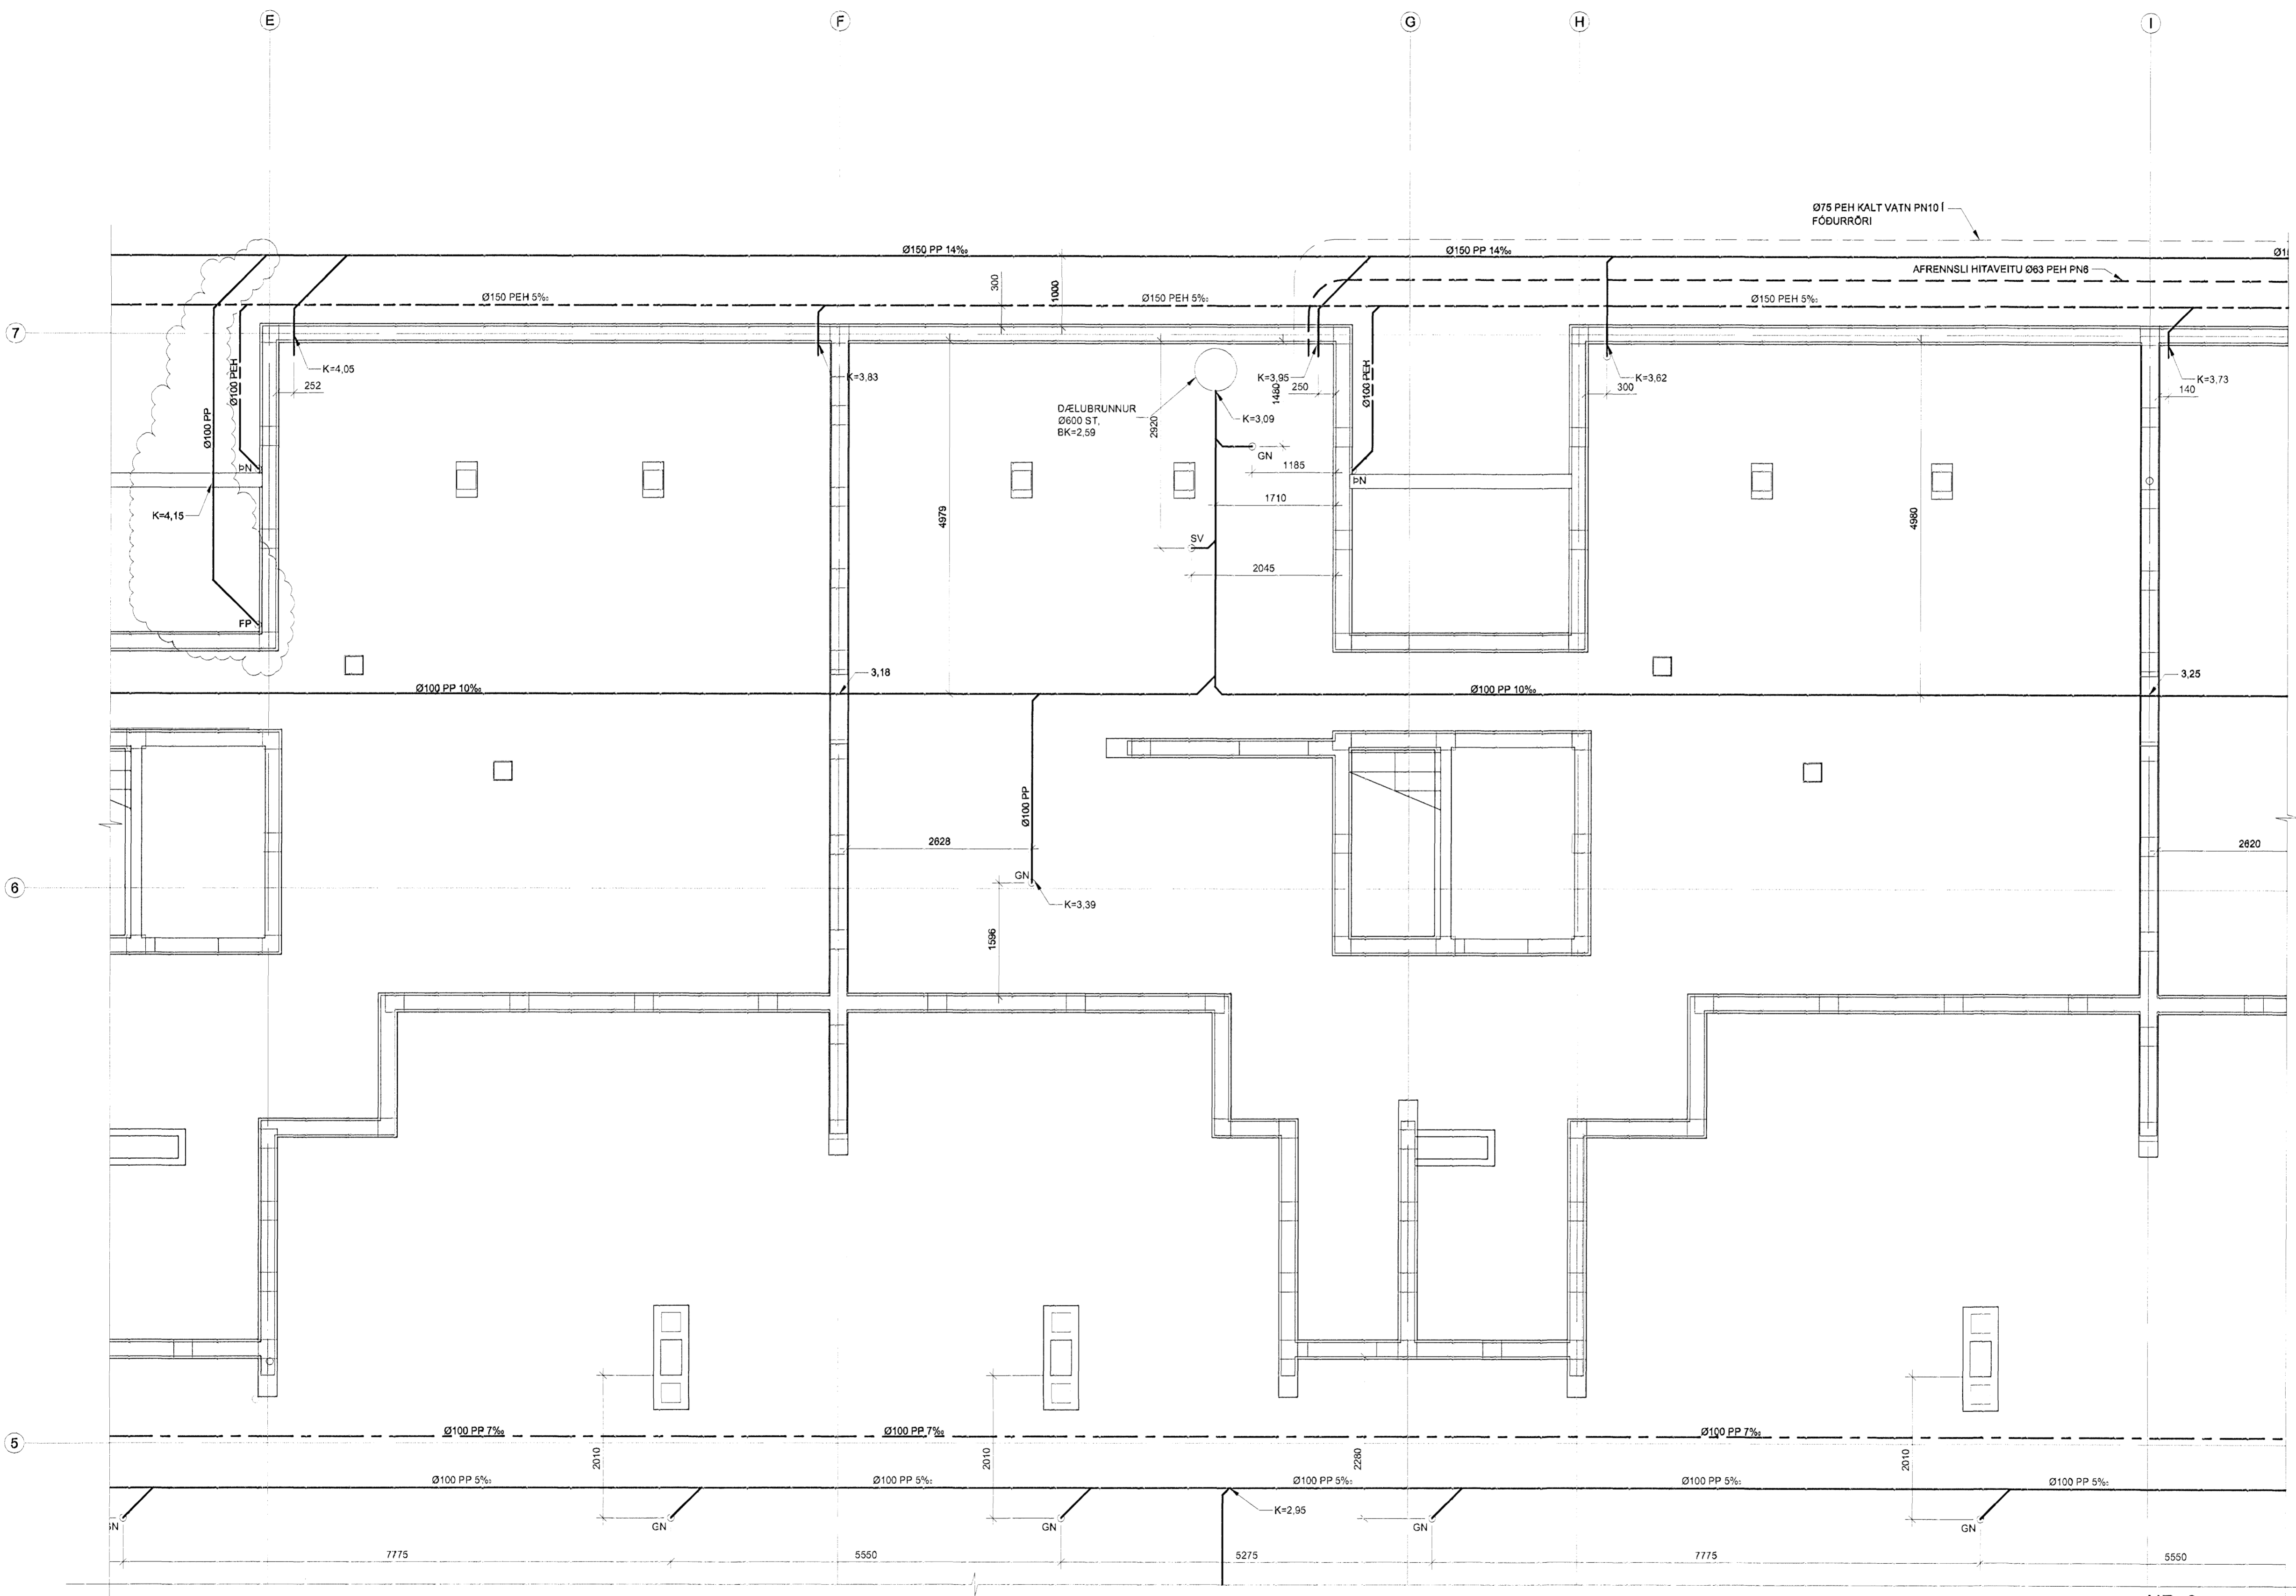

TILVÍSANIR:  
 ALMENNAR SKÝRINGAR . . . . . SJÁ BL. NR. L(7-9)\_001

NR. 9		GI	GG
PRIFA- OG HITAKERFI		REKN.	TEKN.
LAGNIR Í GRUNNI			
GRUNNMYND			
Mkv:		1:50	
DAGS:		14.01.2008	
HANNAD/TEKN:		GI/OG	
VERKNR:		05112	
YRIRFARID: <i>[Signature]</i> SAMRÆTT: <i>[Signature]</i> KENNITALA: 1305974439		Kennitala: 800105-1400 Húsmannlaug 11, 201 Kópavogur Sími: 571-0300 Veffang: www.conis.is	
TEKN. NR. L(9b)_302		BR. A	