


1 FEB 2007
 Ups

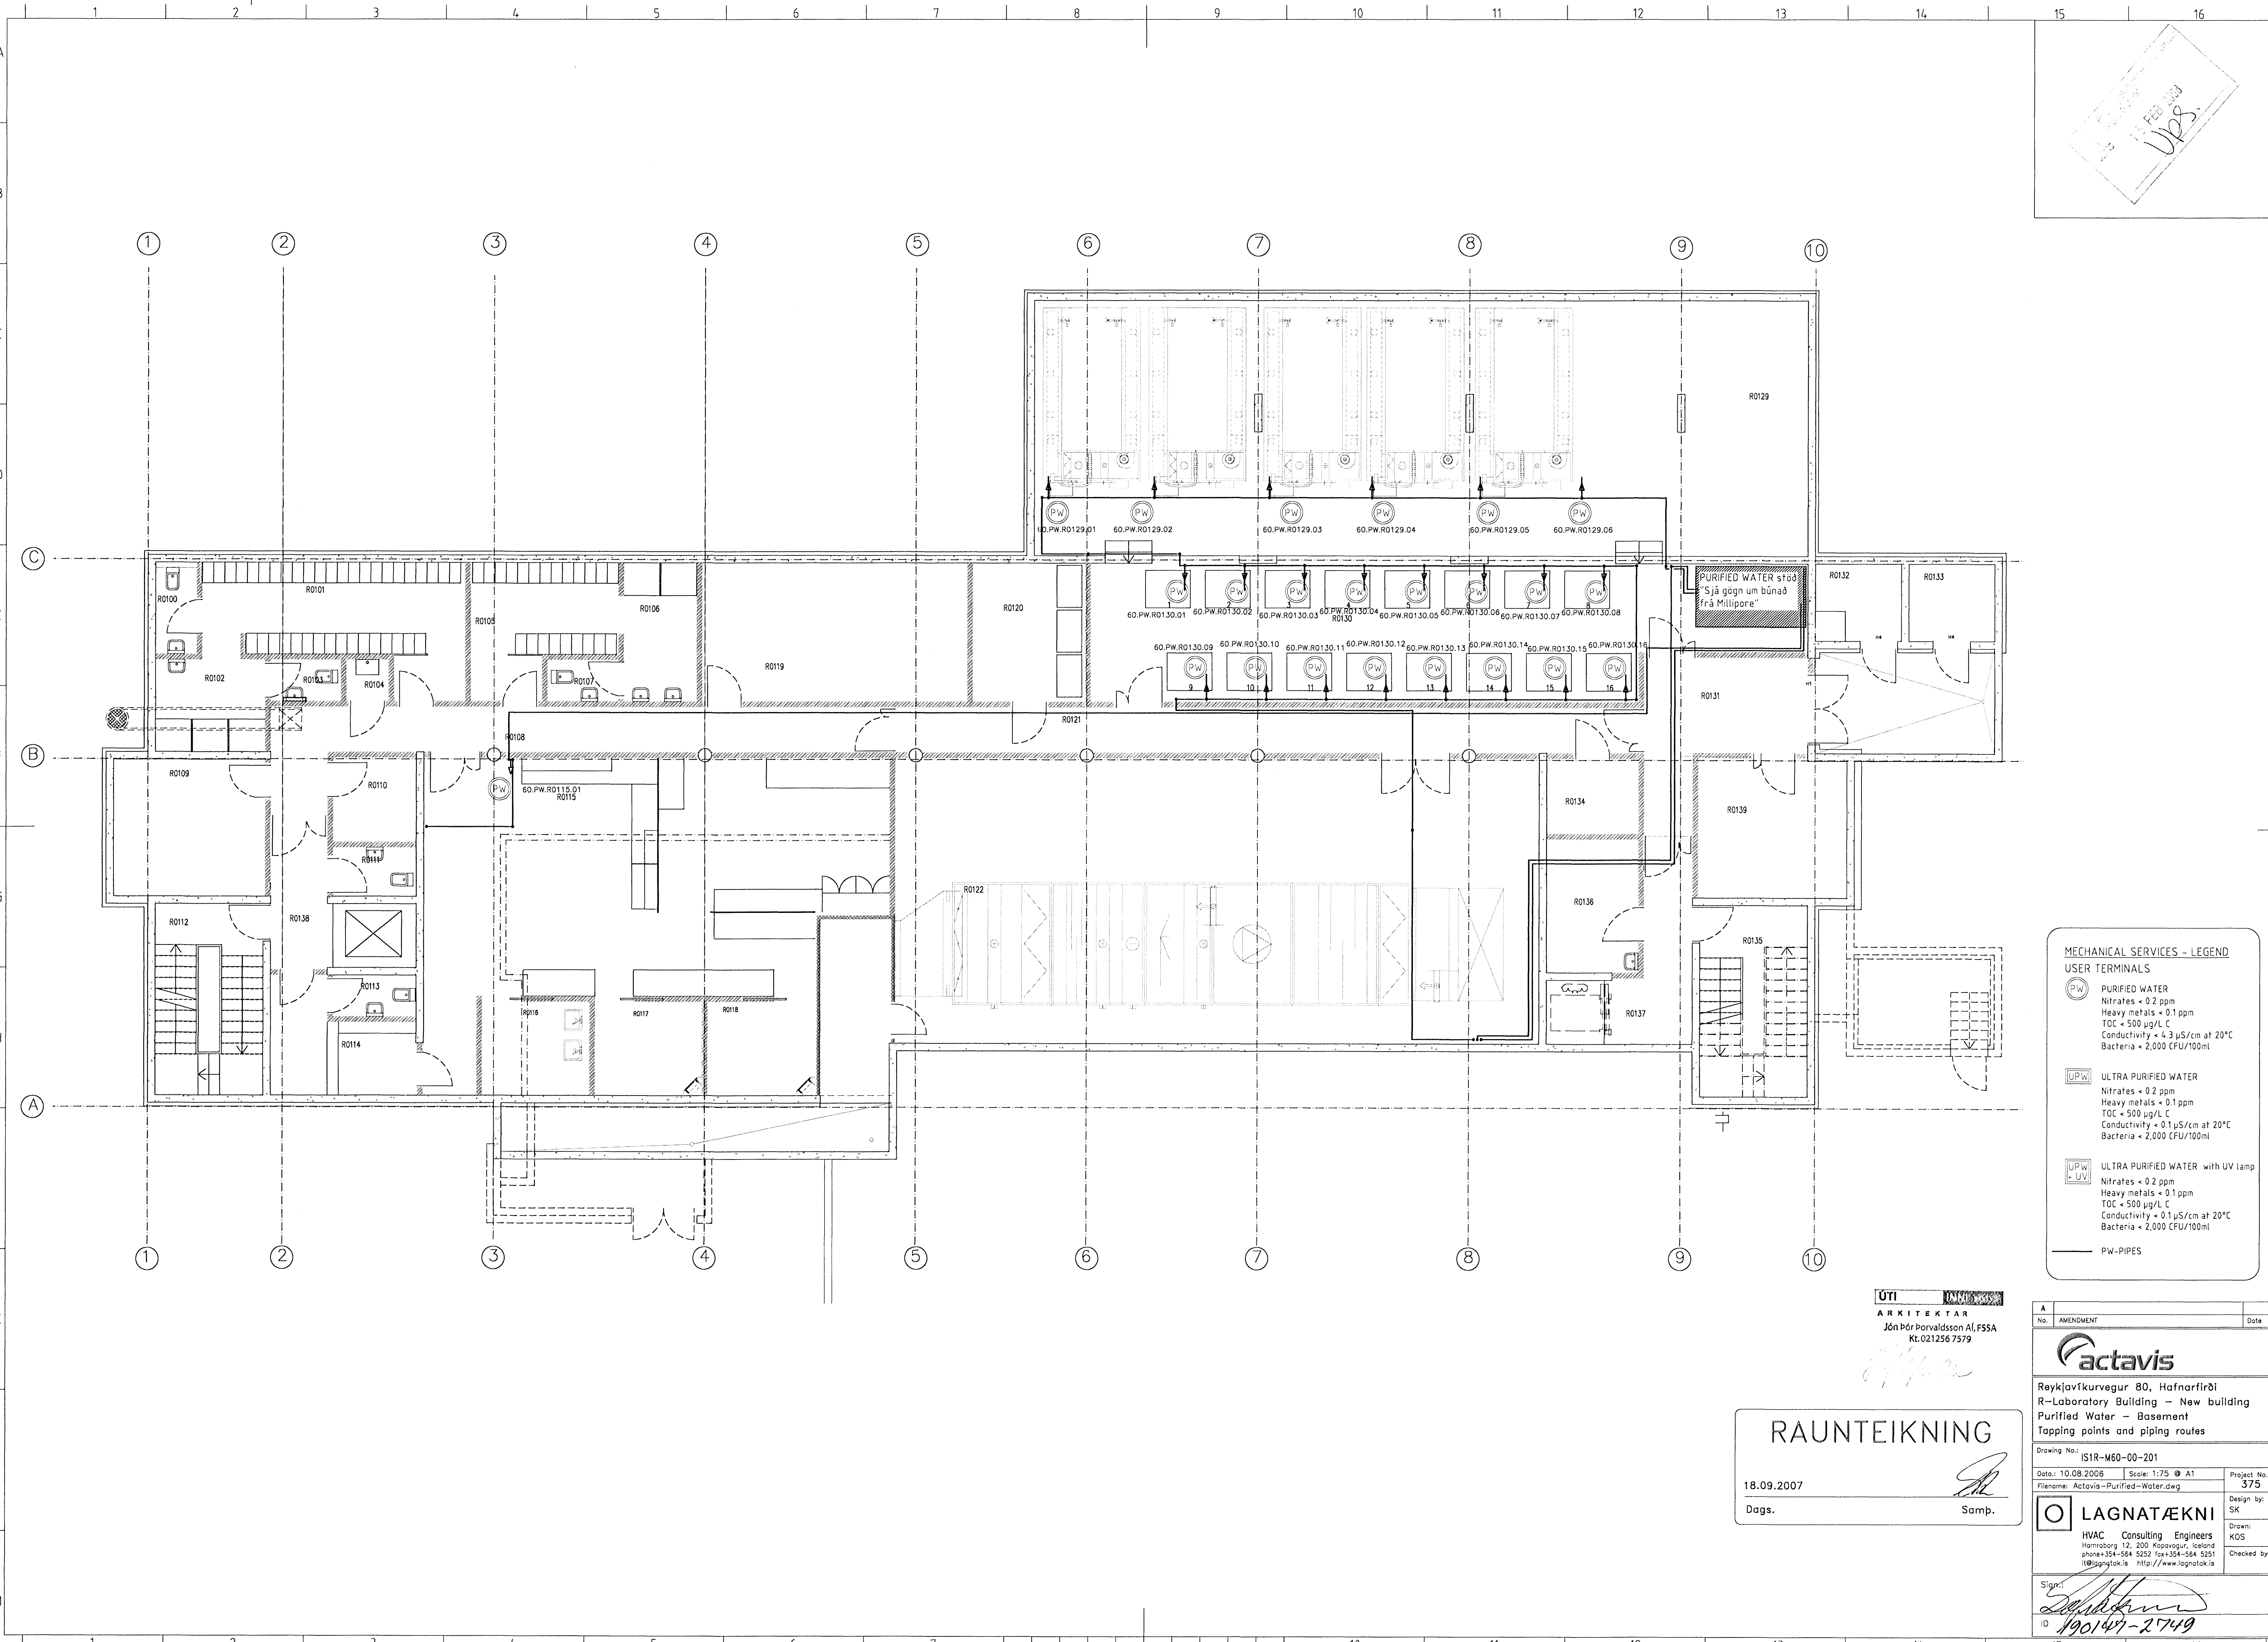

MECHANICAL SERVICES - LEGEND

USER TERMINALS

PW PURIFIED WATER
 Nitrates < 0.2 ppm
 Heavy metals < 0.1 ppm
 TOC < 500 µg/L C
 Conductivity < 4.3 µS/cm at 20°C
 Bacteria < 2,000 CFU/100ml

UPW ULTRA PURIFIED WATER
 Nitrates < 0.2 ppm
 Heavy metals < 0.1 ppm
 TOC < 500 µg/L C
 Conductivity < 0.1 µS/cm at 20°C
 Bacteria < 2,000 CFU/100ml

UPW-UV ULTRA PURIFIED WATER with UV lamp
 Nitrates < 0.2 ppm
 Heavy metals < 0.1 ppm
 TOC < 500 µg/L C
 Conductivity < 0.1 µS/cm at 20°C
 Bacteria < 2,000 CFU/100ml

— PW-PIPES

ÚTI
 ARKITEKTAR
 Jón Þór Þorvaldsson AÍ, FSSA
 Kt. 021256 7579

RAUNTEIKNING
 18.09.2007
 Dags.

No.	AMENDMENT	Date

Reykjavíkurvegur 80, Hafnarfirði
 R-Laboratory Building - New building
 Purified Water - Basement
 Tapping points and piping routes

Drawing No.: JSIR-M60-00-201
 Date: 10.08.2006 Scale: 1:75 @ A1 Project No.: 375
 Filename: Actavis-Purified-Water.dwg Design by: SK
LAGNATÆKNI
 HVAC Consulting Engineers
 Hárnaborg 12, 200 Kópavogur, Iceland
 phone +354-584 5252 fax +354-584 5251
 h@lagnotak.is http://www.lagnotak.is
 Drawn: KOS
 Checked by:

Sign:
 ID: 190147-2749