


15 FEB 2008
 UPS

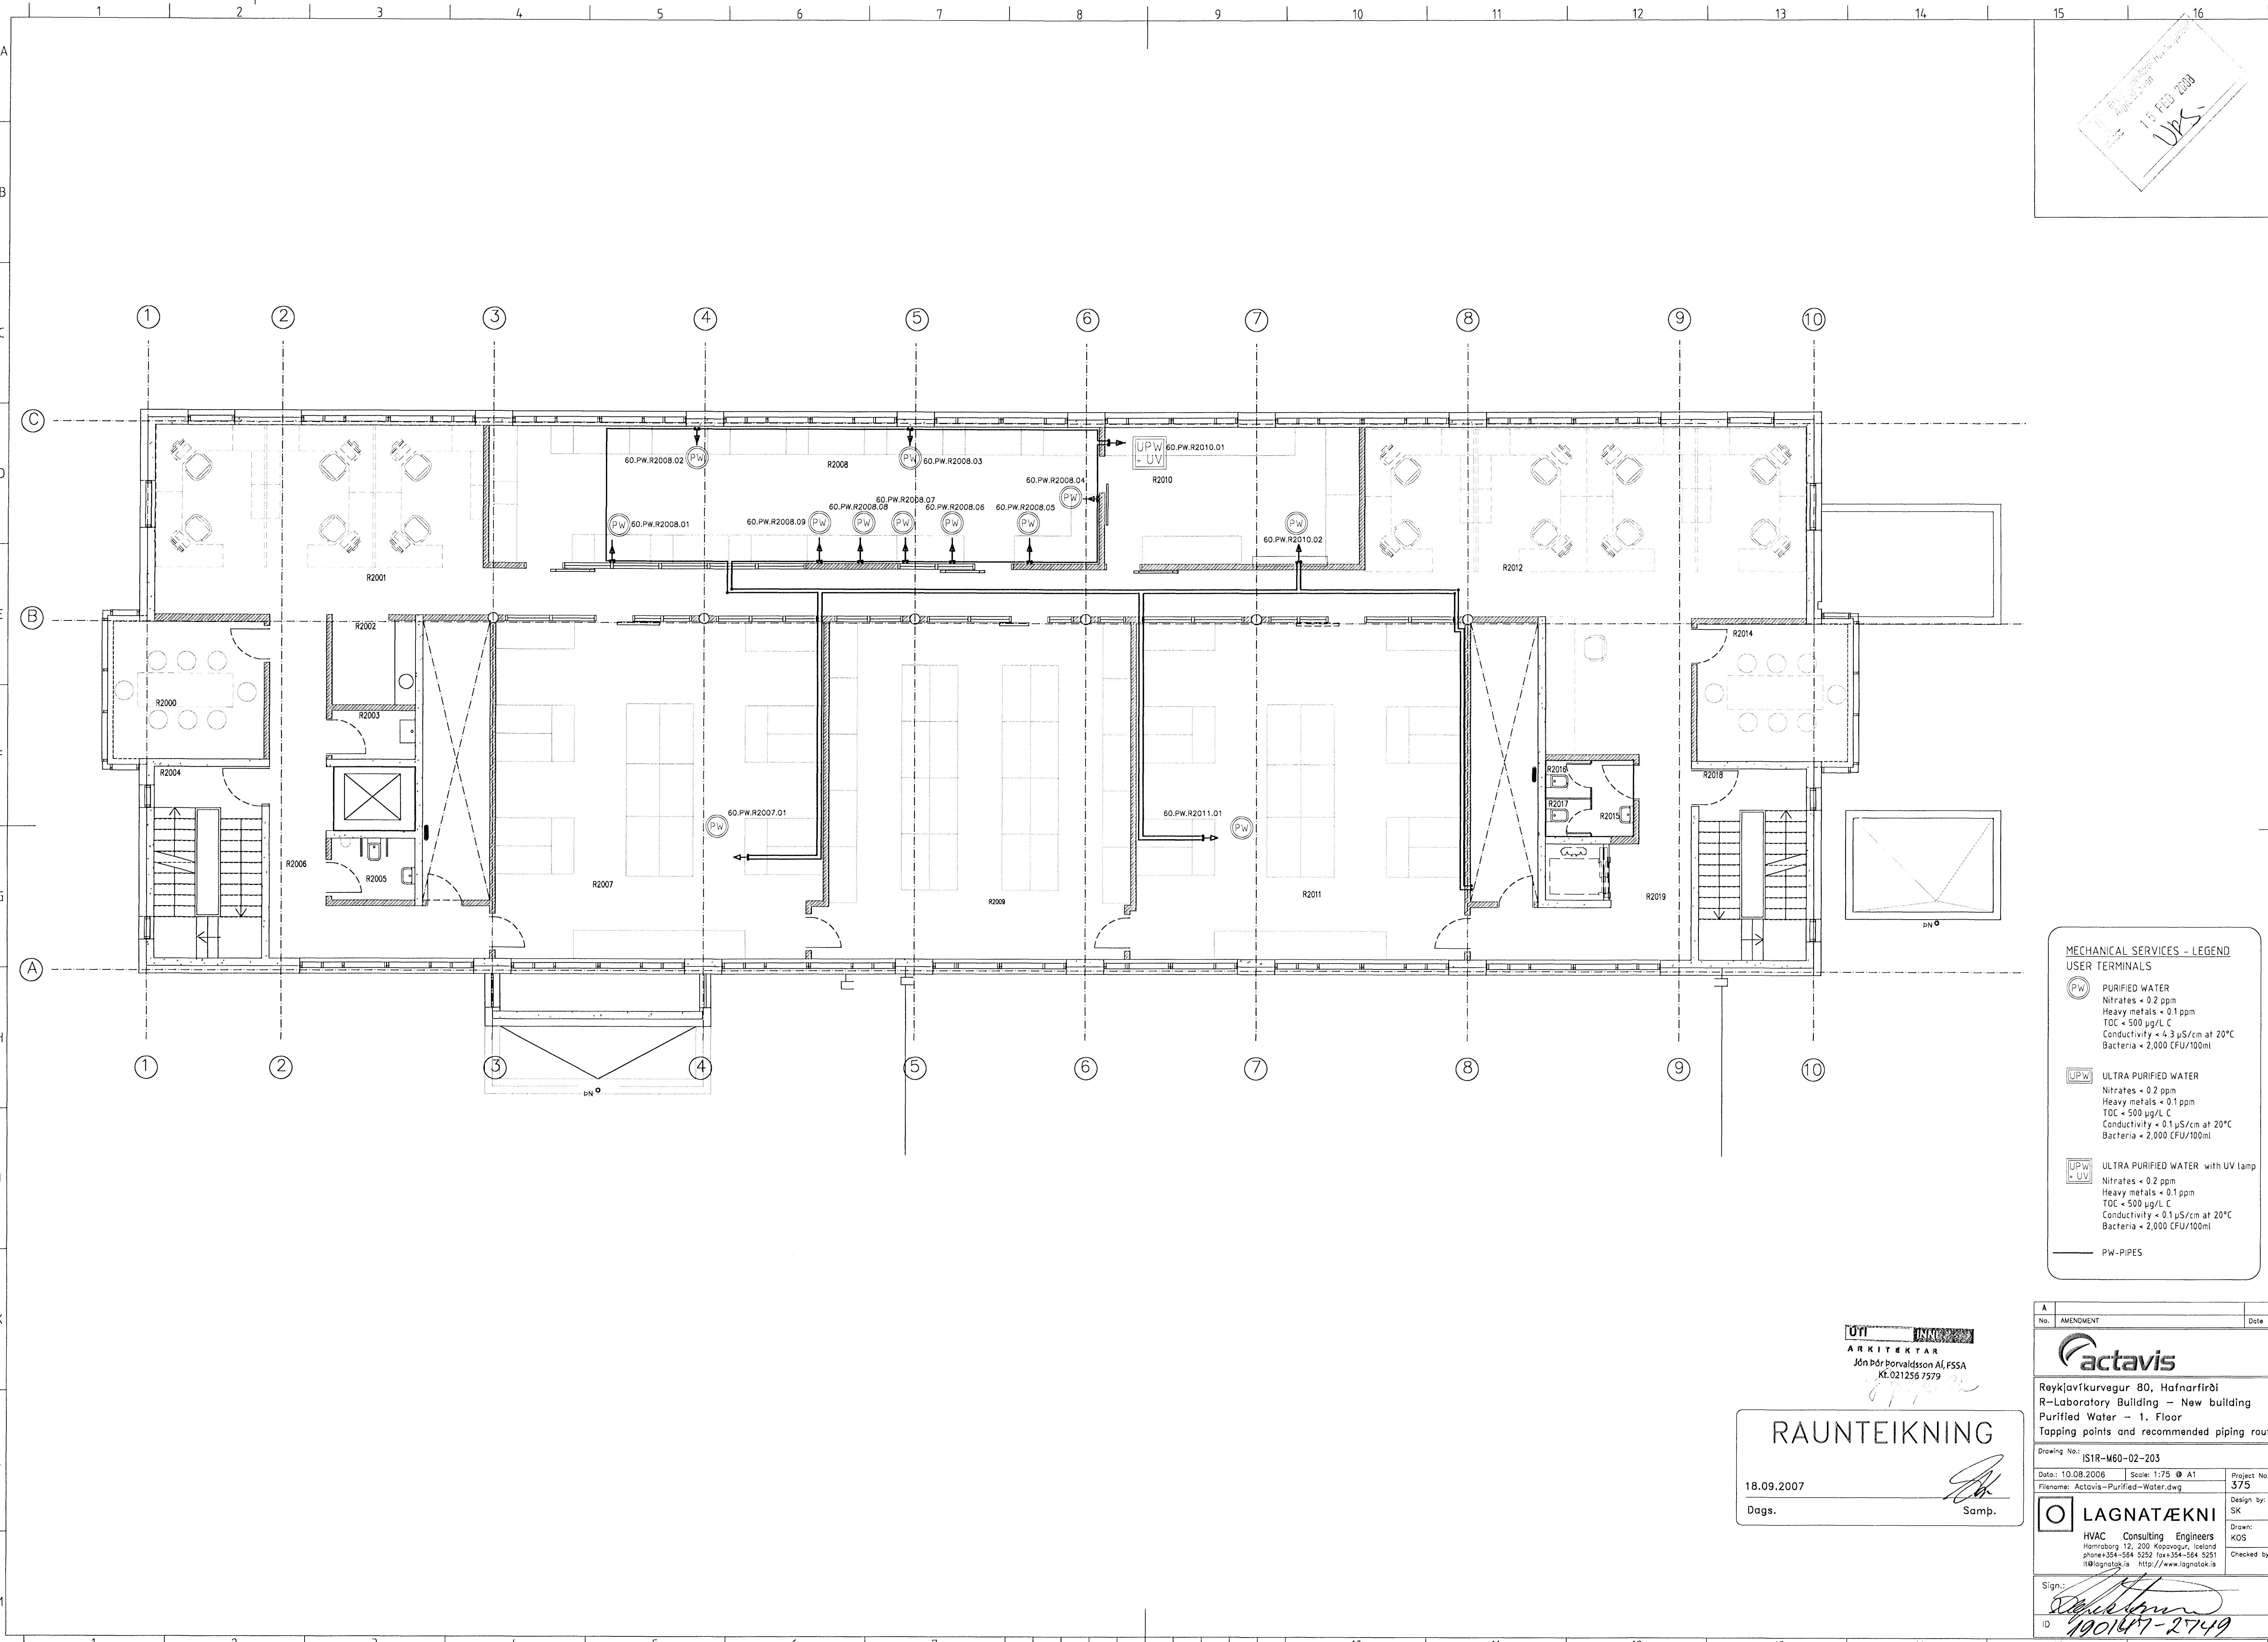

MECHANICAL SERVICES - LEGEND

USER TERMINALS

	PURIFIED WATER Nitrates < 0.2 ppm Heavy metals < 0.1 ppm TOC < 500 µg/L C Conductivity < 4.3 µS/cm at 20°C Bacteria < 2,000 CFU/100ml
	ULTRA PURIFIED WATER Nitrates < 0.2 ppm Heavy metals < 0.1 ppm TOC < 500 µg/L C Conductivity < 0.1 µS/cm at 20°C Bacteria < 2,000 CFU/100ml
	ULTRA PURIFIED WATER with UV lamp Nitrates < 0.2 ppm Heavy metals < 0.1 ppm TOC < 500 µg/L C Conductivity < 0.1 µS/cm at 20°C Bacteria < 2,000 CFU/100ml
	PW-PIPES

RAUNTEIKNING
 18.09.2007
 Dags.

Sampa

011
 ARKITEKTAR
 Jón Þór Þorvaldsson AÍ, FSSA
 Kf. 021256 7579

No.	AMENDMENT	Date
 Reykjavíkurvegur 80, Hafnarfirði R-Laboratory Building - New building Purified Water - 1. Floor Tapping points and recommended piping routes		
Drawing No.: ISIR-M60-02-203		
Date: 10.08.2006	Scale: 1:75 @ A1	Project No.: 375
Filename: Actavis-Purified-Water.dwg		
 LAGNATÆKNI HVAC Consulting Engineers Hamraborg 12, 200 Kópavogur, Iceland phone+354-564 5252 fax+354-564 5251 info@lagnatæki.is http://www.lagnatæki.is		Design by: SK Drawn: KOS Checked by:
Sign.: ID: 190147-2749		