
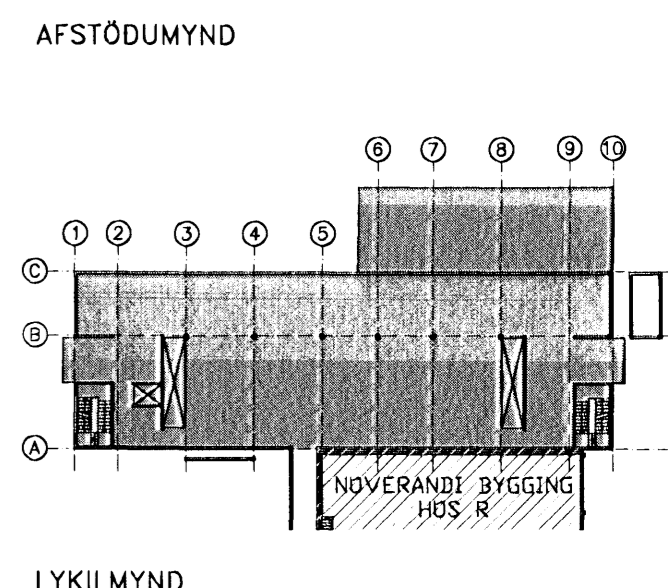


ÚTIFRÁS
 18. FEB 2007
 V.P.S.

Undirritun samráðingarráðgjafar:

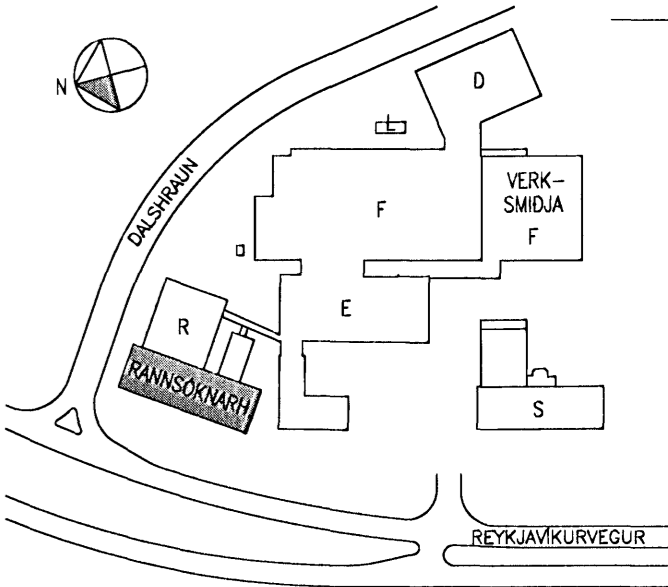

ÚTI **ARKITEKTAR**
 Jón Þór Þorvaldsson Af, FSSA
 Kt. 021256 7579

RAUNTEIKNING

18.09.2007 FSC Samp.

X xxx	xx.xx.xxxx
Nr. Lýsing & breytingu	Daga
Teikning nr. IS1R-M30-/-101	
Daga: 28.09.2005	Kverði: Enginn
Skjalnúmer: 375-Frærennsilskerfi.dwg	Verk nr.: 375
Hönnunar- og ráðgjafarstofa / FRV Hornborg 12, 200 Kópavogur, Ísland sími: 334-564 5252 fax: 334-564 5251 info@lagnotakis.is http://www.lagnotakis.is	
Samþ.: <i>Fritjof S. Jónsson</i> Kennitala: 300346-3409	