


15 FEB 2008  
 JFS

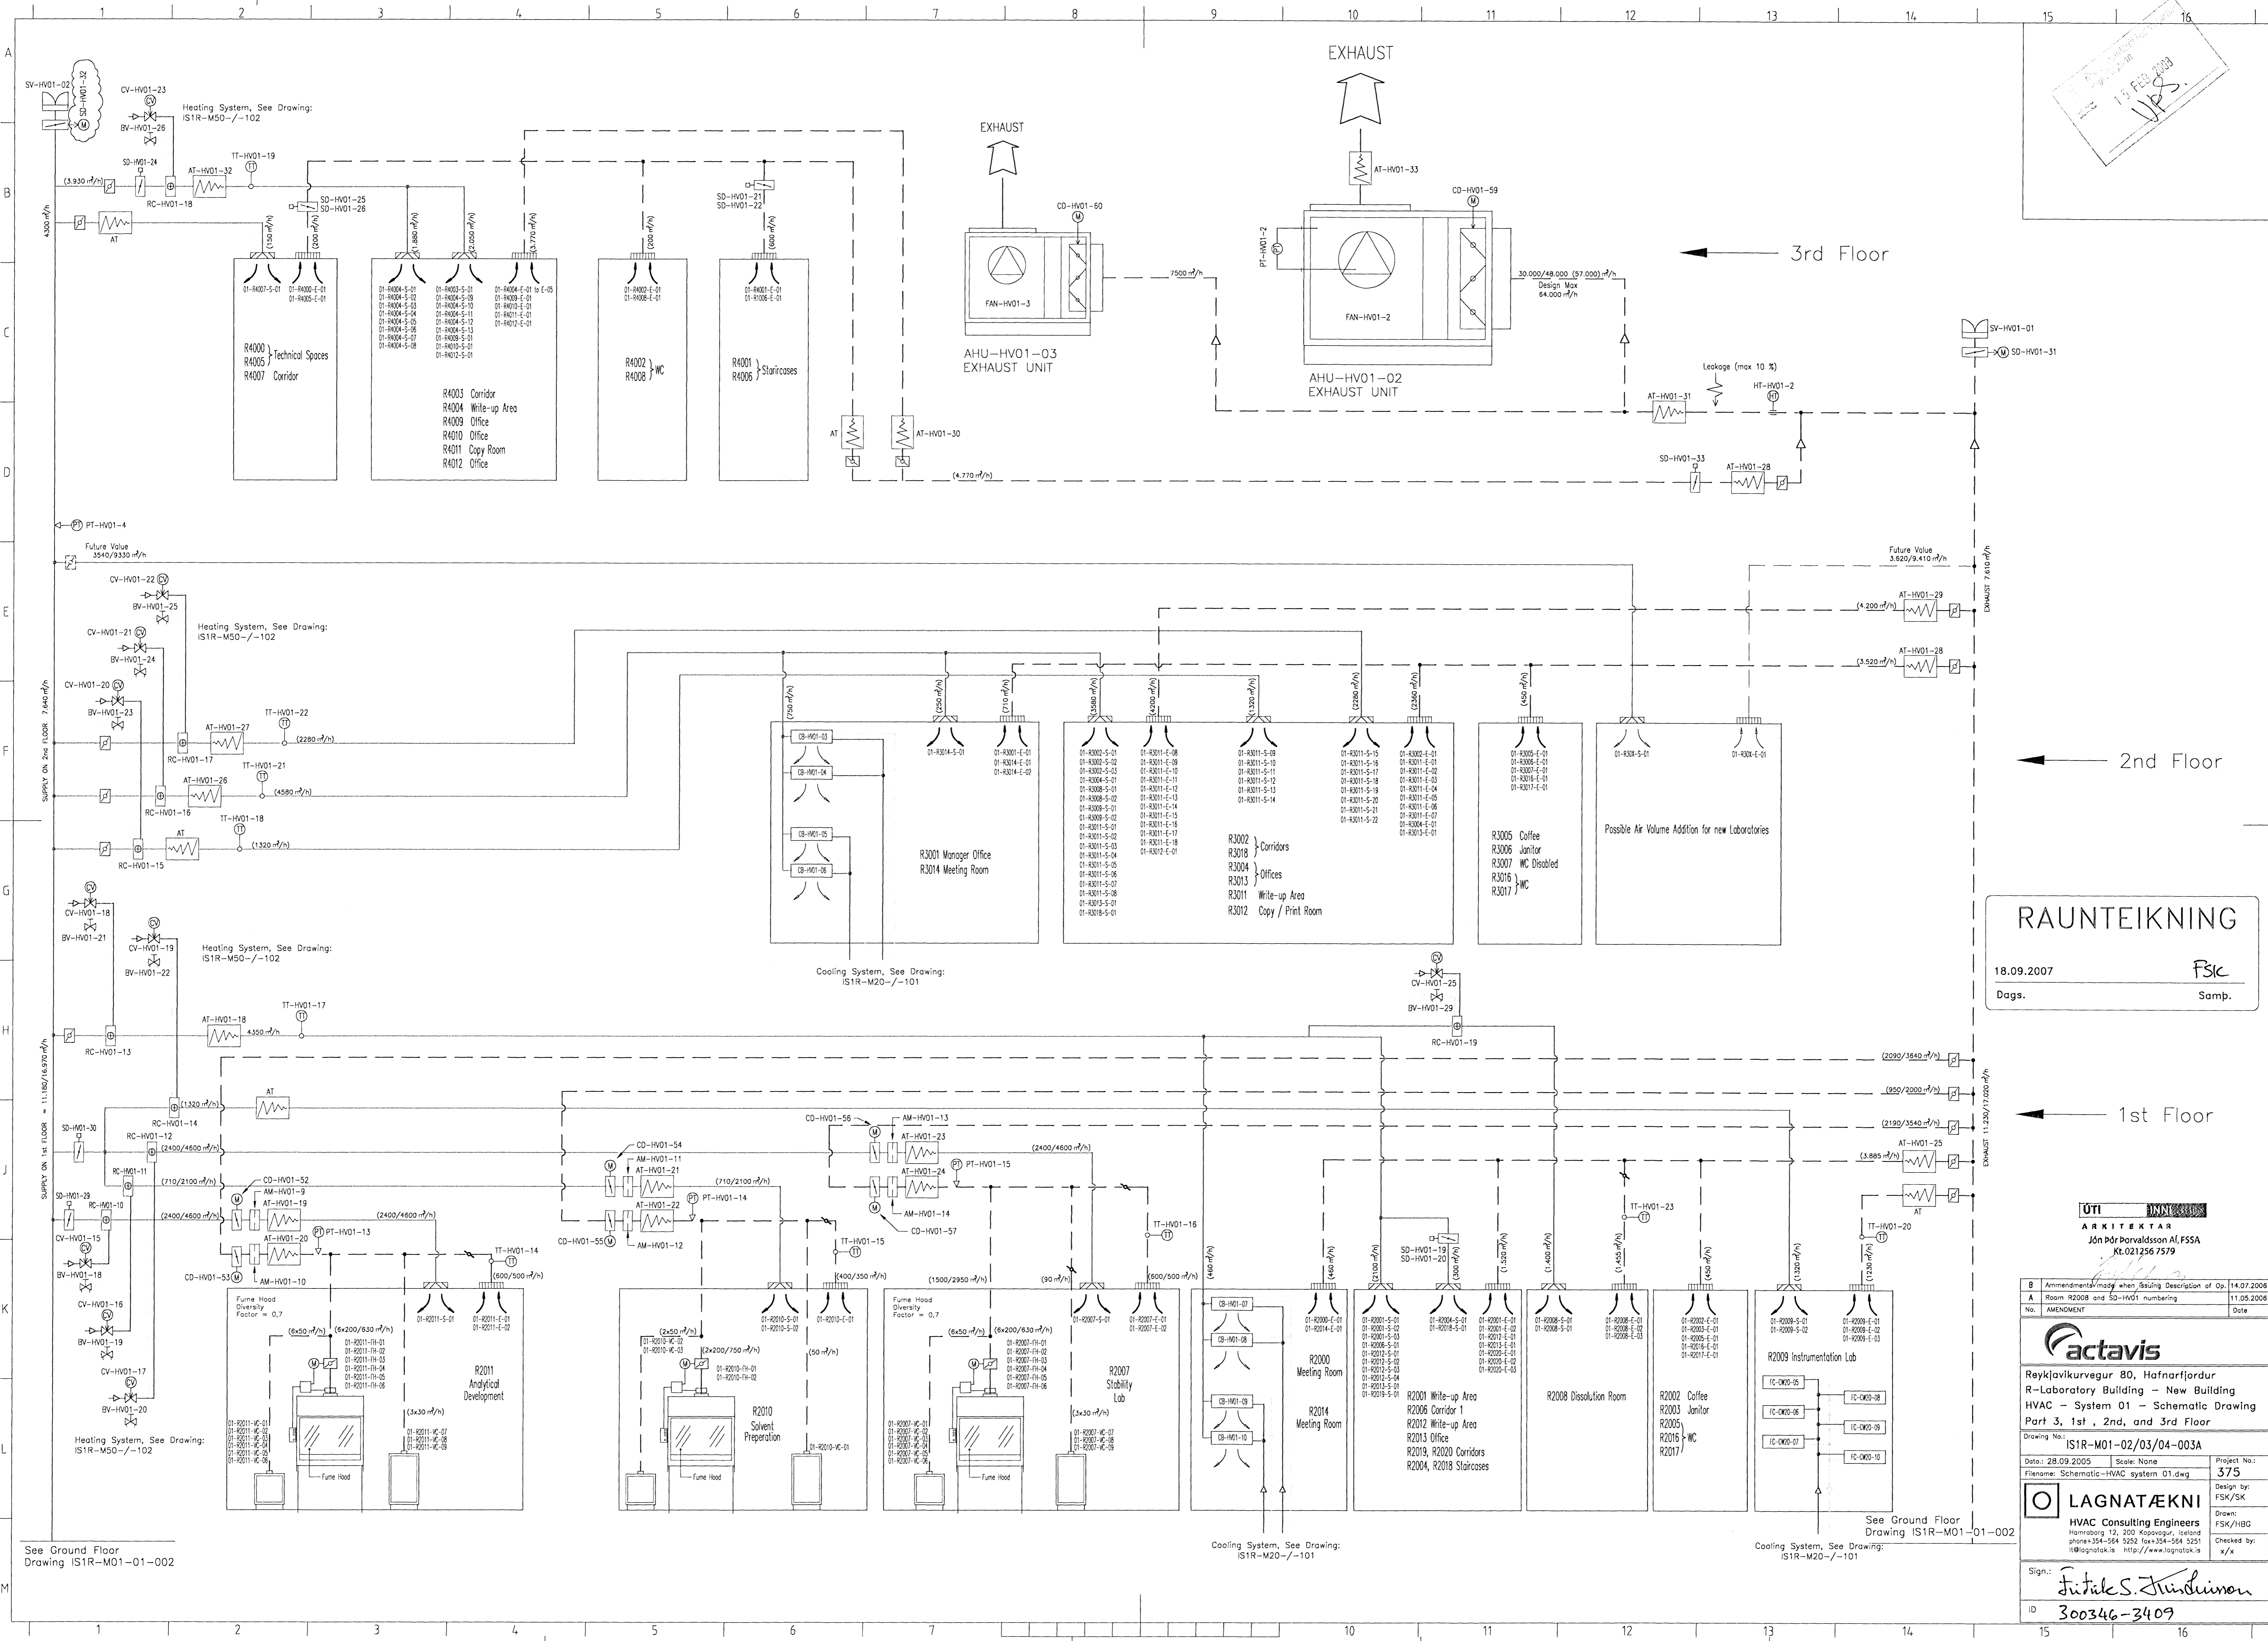

3rd Floor

2nd Floor

1st Floor

**RAUNTEIKNING**  
 18.09.2007  
 Dags.

FSÍK  
 Samp.

<b>actavis</b> Reykjavíkuvægur 80, Hafnarfjörður R-Laboratory Building - New Building HVAC - System 01 - Schematic Drawing Part 3, 1st, 2nd, and 3rd Floor	
Drawing No.: IS1R-M01-02/03/04-003A	
Date: 28.09.2005	Scale: None
Project No.: 375	Design by: FSK/SK
Drawn: FSK/HBG	Checked by: x/x
Sign.: <i>Fúla S. Jónsdóttir</i> ID 300346-3409	

See Ground Floor Drawing IS1R-M01-01-002

Cooling System, See Drawing: IS1R-M20-/-101

Cooling System, See Drawing: IS1R-M20-/-101