

18 FEB 2008
VBS


Undirritun samráðingarráðgjafar:

RISTAR OG TENGIBOX TIL VIÐMIÐUNAR:


- S 1 = ABB KH-100 + DTT2-10-10
- S 3 = ABB KH-125 + DTT2-12-12
- S 5 = ABB KH-160 + DTT2-16-16
- S 6 = ABB KH-200 + DTT2-16-20
- S 8 = ABB KH-250 + DTT2-20-25
- S 10 = Lindab GTI-0-200 + MBA-1-160-200
- S 11 = Stifab TDYc K 200-600 + ALSc 160-200
- S 12 = Stifab TDYc K 250-600 + ALSc 200-250
- S 13 = Grada JD 130-160
- S 14 = Lindab PKA 400 + MBA-2-250-400
- S 15 = Lindab PKA 250 + MBA-1-200-250
- S 16 = Lindab PKA 200 + MBA-1-160-200
- S 17 = Lindab GTI-0-200 + MBA-2-125-200
- S 18 = Stifab TDYc K 160-600 + ALSc 125-160
- S 20 = Lindab GTI-0-200
- S 21 = Lindab PKA 315 + MBA-1-315-400
- S 22 = Kællirattar 600x1200mm (sjá verkýsingu)

- E 1 = Lindab KSU 100 + MBA-0-100-100
- E 2 = Lindab KSU 125 + MBA-1-100-125
- E 3 = Lindab KSU 160 + MBA-1-125-160
- E 4 = Lindab KSU 160
- E 5 = Lindab CRL 125 + MBA-0-125-125
- E 6 = Lindab CRL 125 + MBA-1-100-125
- E 7 = Lindab CRL 160 + MBA-0-160-160
- E 8 = Lindab CRL 160 + MBA-1-125-160
- E 9 = Lindab CRL 200 + MBA-0-200-200
- E 10 = Lindab CRL 200 + MBA-1-160-200
- E 11 = Lindab CRL 250 + MBA-0-250-250
- E 12 = Lindab CRL 250 + MBA-1-200-250
- E 13 = Lindab CRL 250
- E 14 = Filtrist 400x300 (við gólf)
- E 15 = Lindab RGS-4-525-75
- E 16 = Lindab RGS-0-325-125
- E 17 = Lindab KSU 125

T 1 = Grada A 780 - 800 x 300

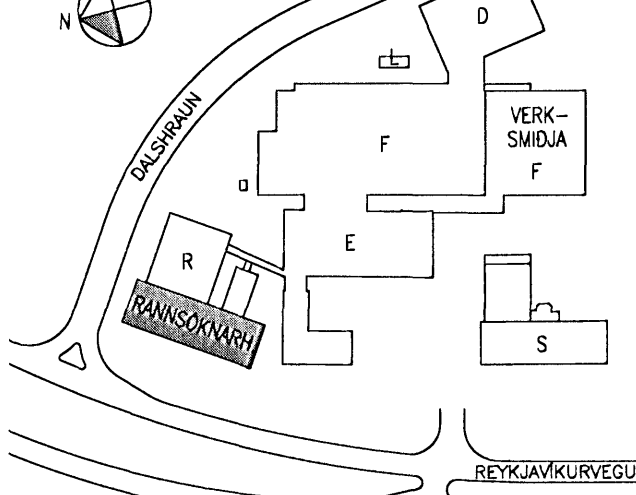

AFSTÖÐUMYND

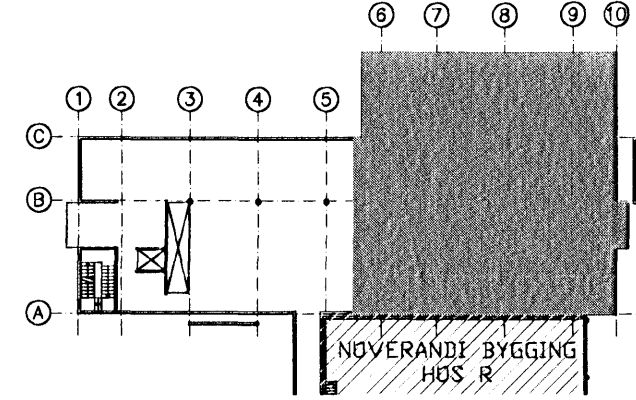

LYKILYND

ÚTI
ARKITEKTAR
Són þór Þorvaldsson AL FSSA
KL 081239 7979

Örugglegri þættir við og loftmagn 1 í herb. R0128 og R0136 þreytt	11.10.2006
Nr. Lýsing á breytinge	Stöps



R-Rannsóknarhús - Nýbygging
Lofttræstikerfi
Grunnmynd - Kjallari - Hluti II

RAUNTEIKNING
18.09.2007
Dags. *Fsk*
Samp.

Tekningarnúmer	IS1R-M01-00-202
Dagur	28.09.2005
Skjalnúmer	375-Lofttræstikerfi-helld.dwg
Kvadr.	150 @ A1
Verk númer	375
Hamad	FSK/HBG
Teknad	HBG/SD
Yfirfarar	

LAGNATÆKNI
Hönnunar- og ráðgjafarstofa / FRV
Hannaborg 12, 200 Kópavogur, Ísland
Sími: 354-564-5252 Fax: 354-564-5251
Ítlagnatakis: <http://www.lagnatakis.is>

Samp. *Fisk S. Jónsson*
Kennitala: 300346-3409

