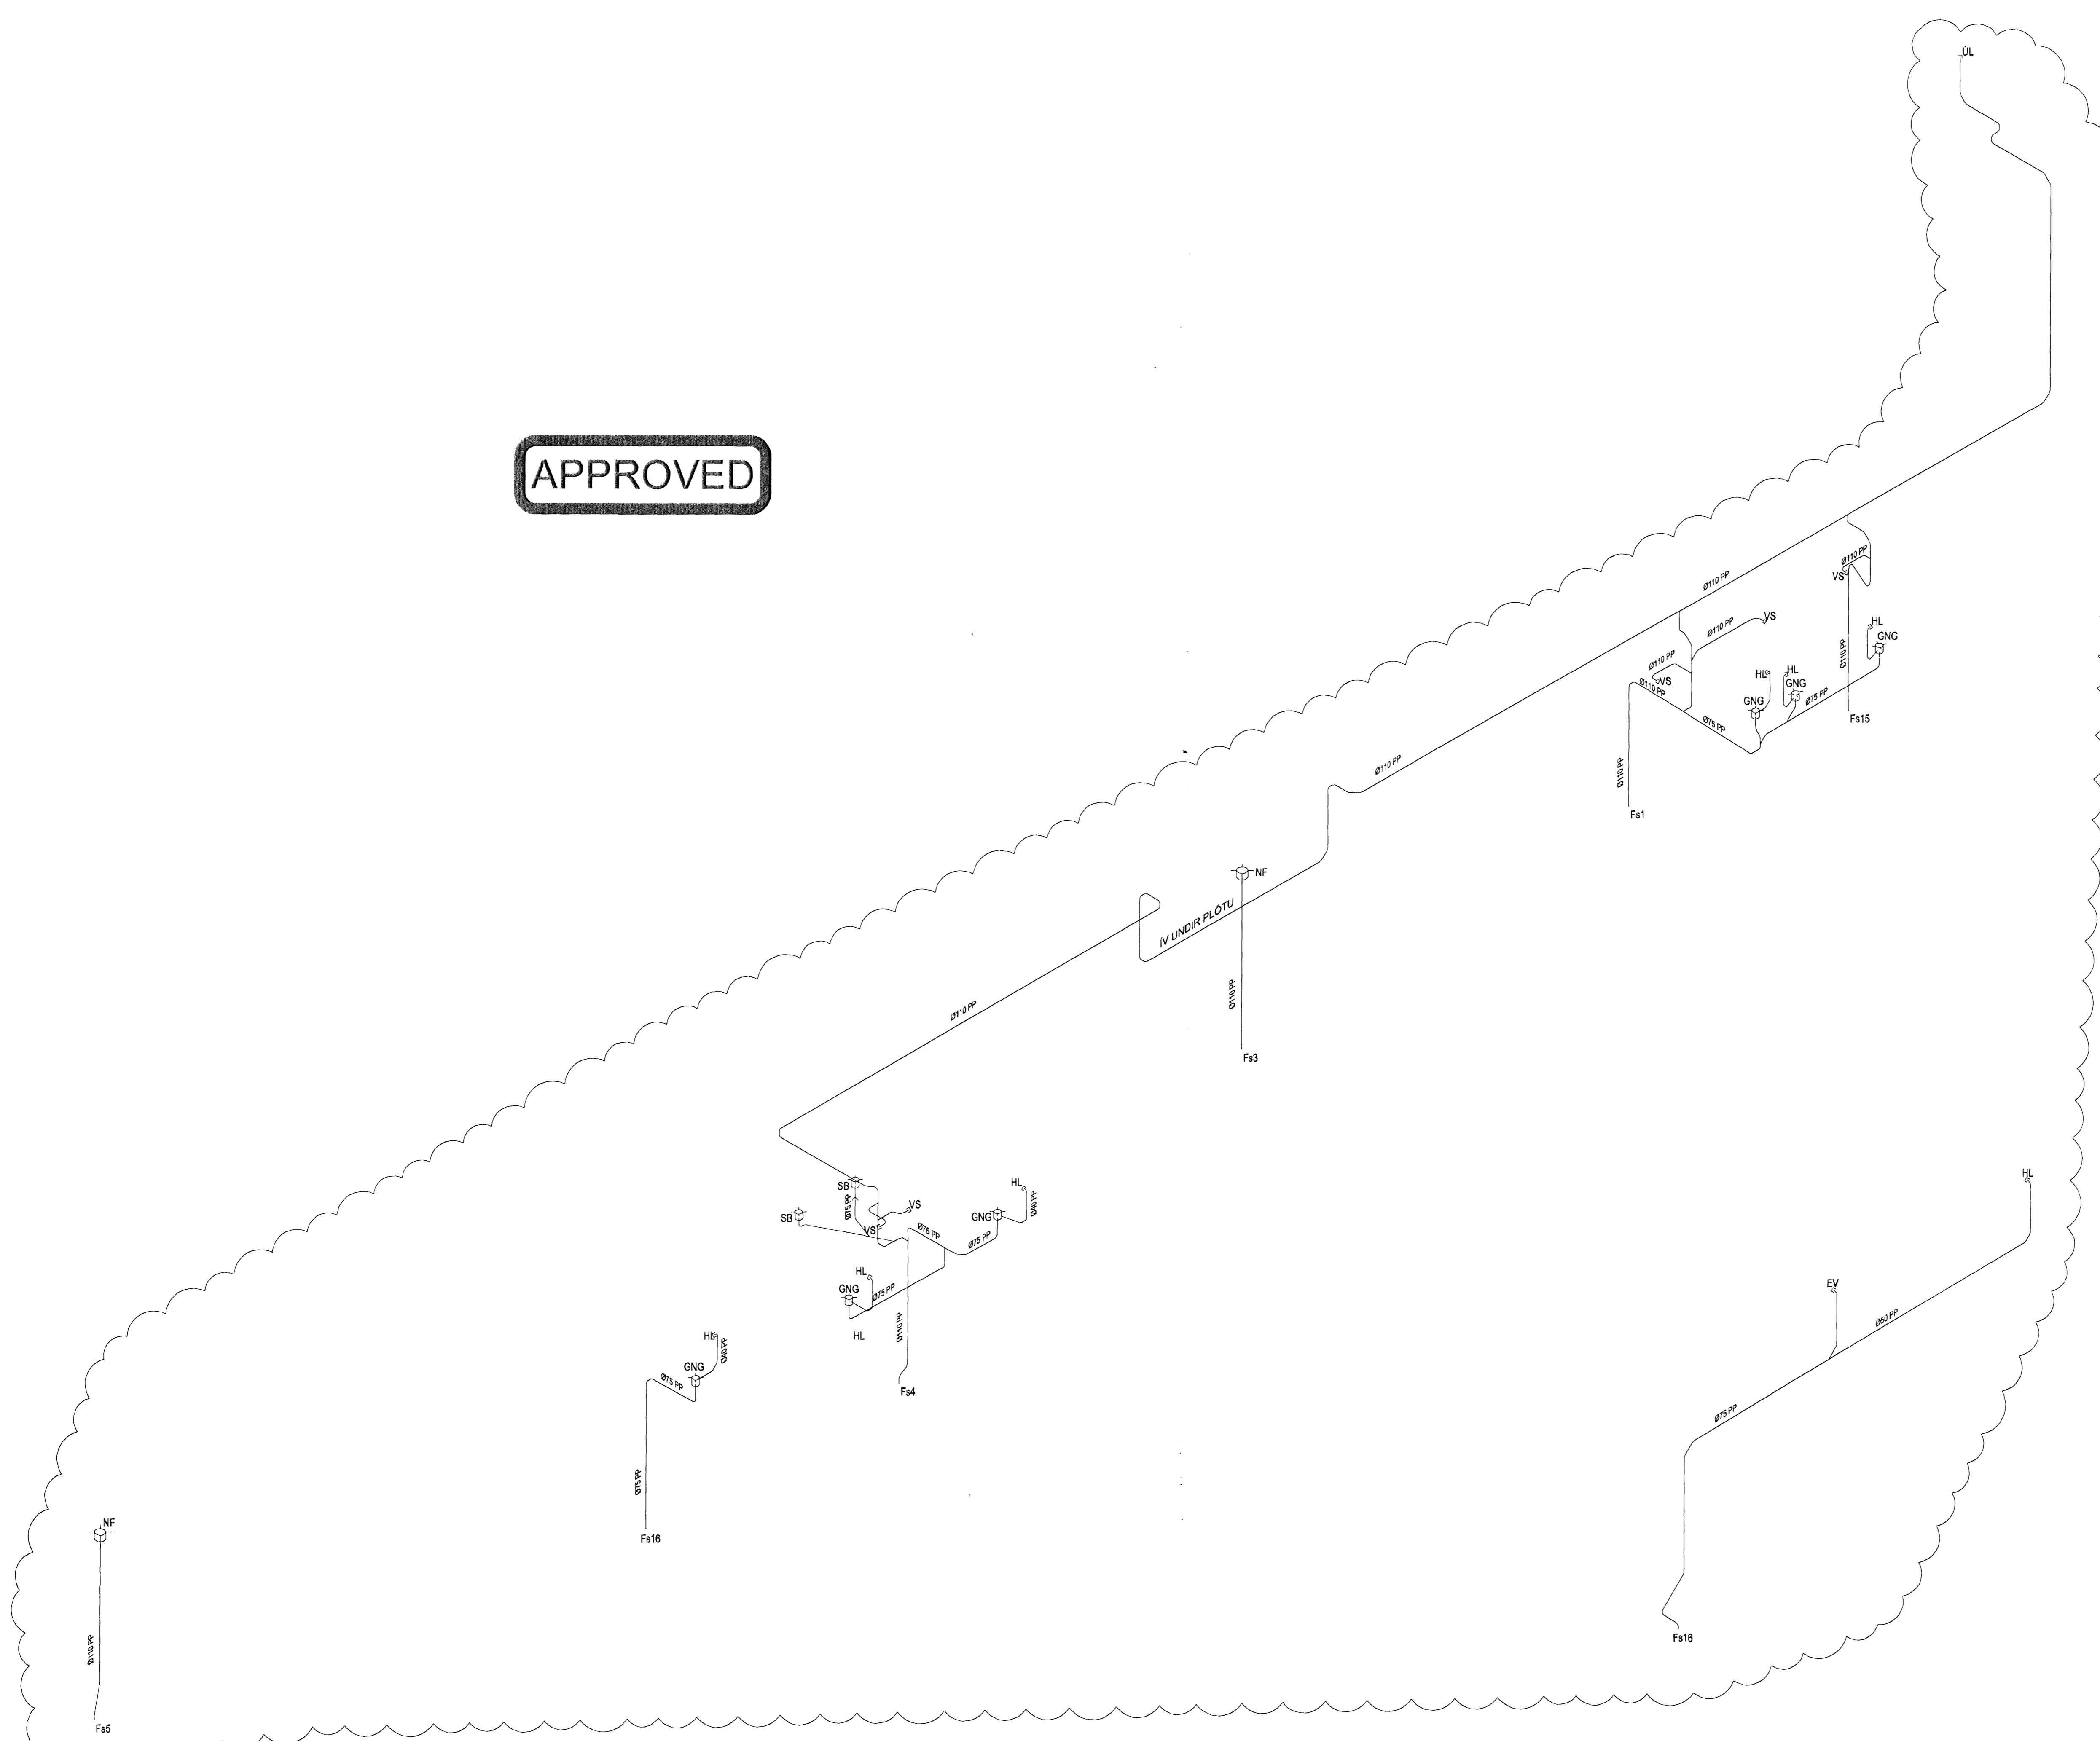

  
 Breytingafultrúi Hafnarjarða
   
 14. AUG 2008
   
*Björg*


**APPROVED**



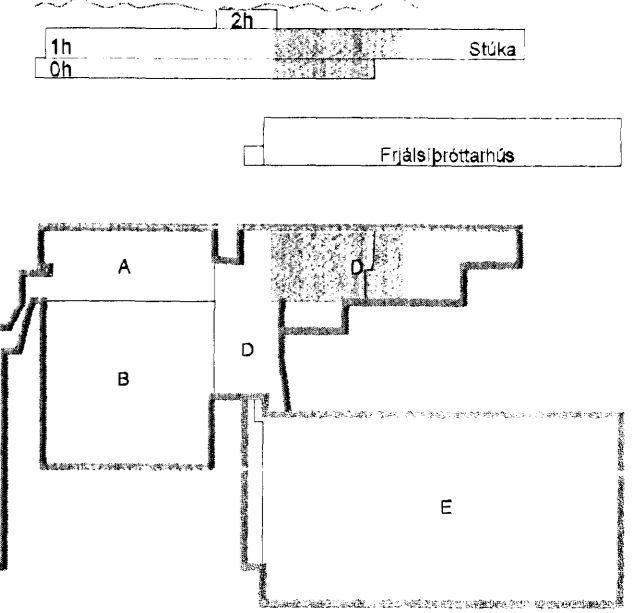**BATTERIID**

VERK: 0604  
 MÖTT: 06.08.08  
 SAMP: *[Signature]*  
 SKYRING:

**KAPLAKRIKI**



B 01.08.08 Breytingar lögnum JURKJUSÁS  
 A 23.11.07 Breytingar á stömmum KMJUSÁS  
 Útg. Dags. Skýring Hannabryfirarid.



**VERKFRÆÐISTOFA**

BÆJARHRAUN 20 - 220 HAFNARFJÖRÐUR - KENNIT. 710798-2899  
 vsb@vsb.is Sími 585 8600 Fax 585 8610 www.vsb.is

Aritun sérhönnuðar Sveinn Áki Sverrisson Kt/230855 5609

Verkefni: **KAPLAKRIKI**  
**HAFNARFIRÐI**

Verktali: **Lagnir**  
**Frárennsliagnir**  
**Rúmmynd**

Hannað	Teiknað	Yfirfarð	Kvarði	Síða
BS/KMJ	BS/KMJ	SÁS	1:50	/ A1
Dags.	Verkefni	Teikning	Útgáfa	
30.04.07	06811	A P191	B	