
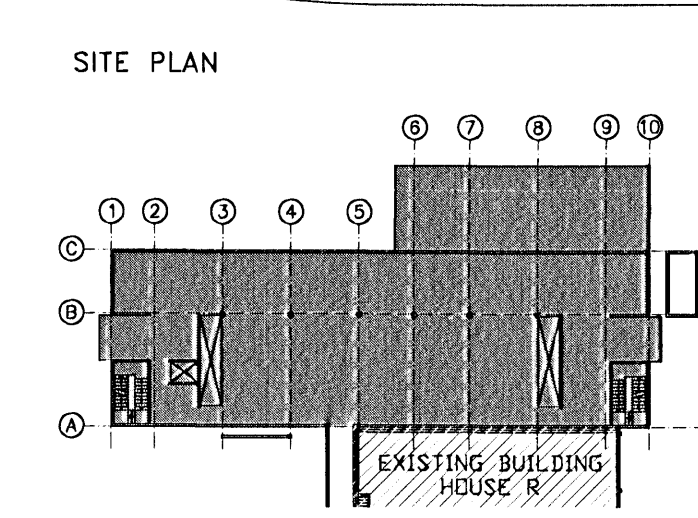


Coordination designer:

NOTES

- MODULATING CONTROL VALVE - WITHOUT CURRENT CLOSED
 - MODULATING CONTROL VALVE - WITHOUT CURRENT OPEN
 - VALVE
 - NON RETURN VALVE
 - BALANCING VALVE
 - CLOSED VALVE IN NORM. OP.
 - SAFETY VALVE
 - GATE VALVE
 - GAUGE / TEMP.
 - GAUGE / PRESSURE
 - MEASURING POINT
 - TEMPERATURE TRANSMITTER
 - PRESSURE TRANSMITTER
 - PRESSURE SWITCH
 - HUMIDITY TRANSMITTER
 - SMOKE SENSOR
 - SWITCH
 - REHEATING COIL (RC)
 - AIR VENT
 - STRAINER
 - AIR SEPARATOR
 - PUMP
 - MANUAL PUMP
 - EXPANSION TANK
 - HEAT EXCHANGER
 - PRESSURE CONTROLLER
 - HEATING CONTROLLER
- LB = LAVATORY BASIN
 WC = WATER CLOSET
 CS = CLEANERS SINK
 DW = DISHWASHER
 KS = KITCHEN SINK
 US = UTILITY SINK
 CWS = COLD WATER SUPPLY
 UR = URINAL
 SH = SHOWER

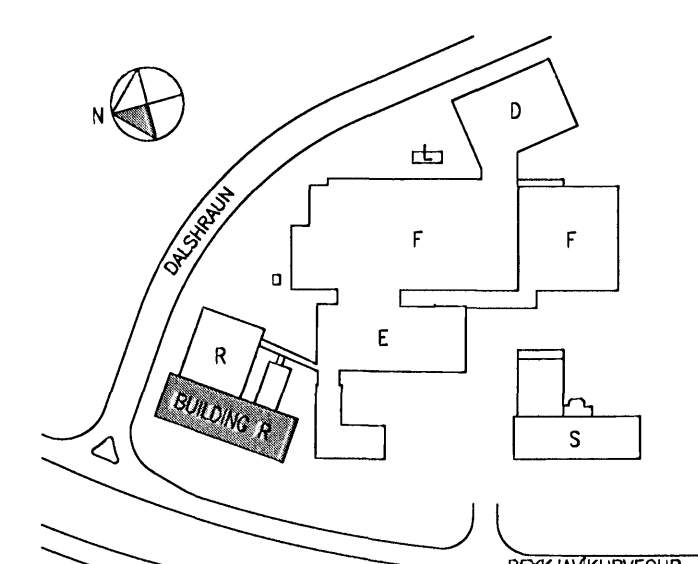

No.	AMENDMENT	Date
A	CHANGE PIPE SIZE FOR FIRE HOSE SYSTEM	21.11.2005

actavis


Reykjavíkurvegur 80, Hafnarfjörður
 R-Laboratory Building - New Building
 HVAC-Domestic Water and Fire Hose Systems - Schematic Drawing

Drawing No.: IS1R-M40/41/-101A
 Date: 28.09.2005 Scale: None Project No.: 375
 Filename: 375-Pfpakerfi.dwg
 Design by: HBG/FSK
 Drawn: HBG
 Checked by: x/x

Sign.: *Furile S. Thorsdóttir*
 ID: 300346-3409

RAUNTEIKNING

18.09.2007
 Dags. *Fsk*
 Samp.

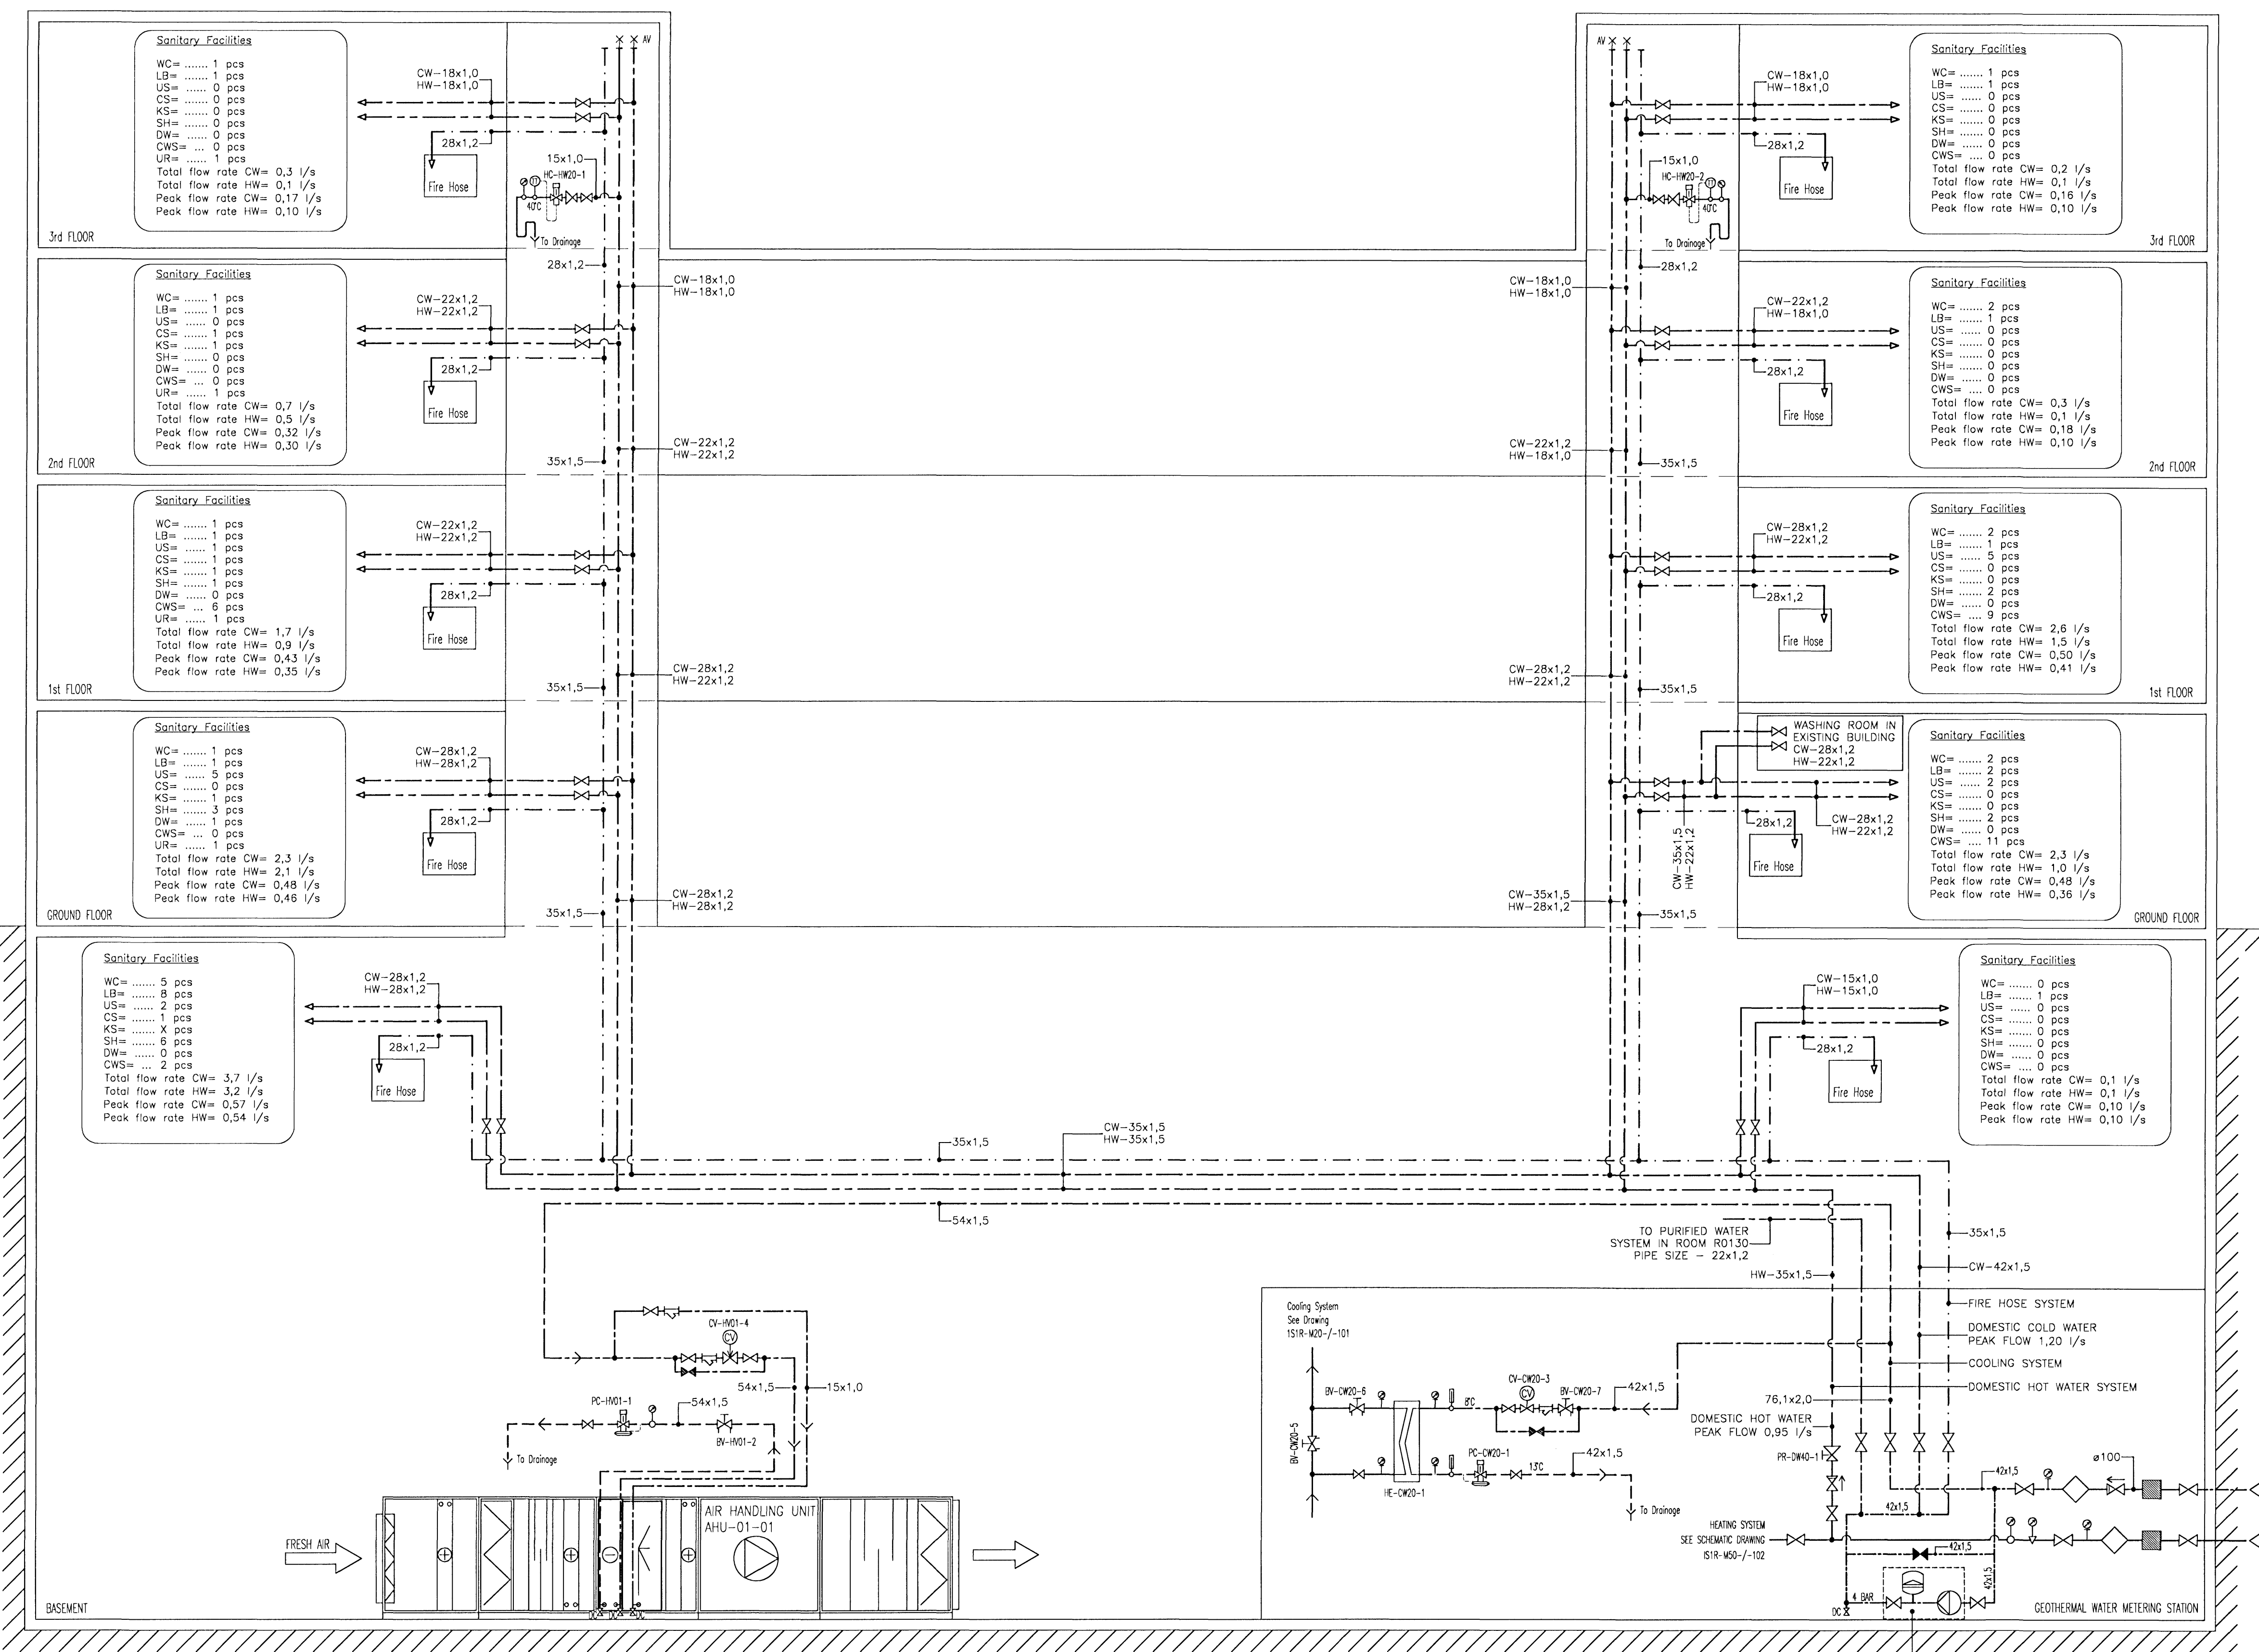

UTI INNVI
 ARKITEKTAR
 Jón Þór Þorgrósson/Al FSSA
 Kf. 021256/7379