


Coordination designer:

- NOTES**
- MODULATING CONTROL VALVE - WITHOUT CURRENT CLOSED
 - MODULATING CONTROL VALVE - WITHOUT CURRENT OPEN
 - VALVE
 - NON RETURN VALVE
 - BALANCING VALVE
 - CLOSED VALVE IN NORM.OP.
 - GATE VALVE
 - GAUGE / TEMP.
 - GAUGE / PRESSURE
 - MEASURING POINT
 - TEMPERATURE TRANSMITTER
 - PRESSURE TRANSMITTER
 - PRESSURE SWITCH
 - HUMIDITY TRANSMITTER
 - SMOKE SENSOR
 - SWITCH
 - REHEATING COIL (RC)
 - AIR VENT
 - STRAINER
 - AIR SEPARATOR
 - PUMP
 - MANUAL PUMP
 - EXPANSION TANK
 - HEAT EXCHANGER
 - PRESSURE CONTROLLER
 - HEATING CONTROLLER
- HEATING SUPPLY (HS)
 HEATING RETURN (HR)
 CHILLED WATER SUPPLY
 CHILLED WATER RETURN

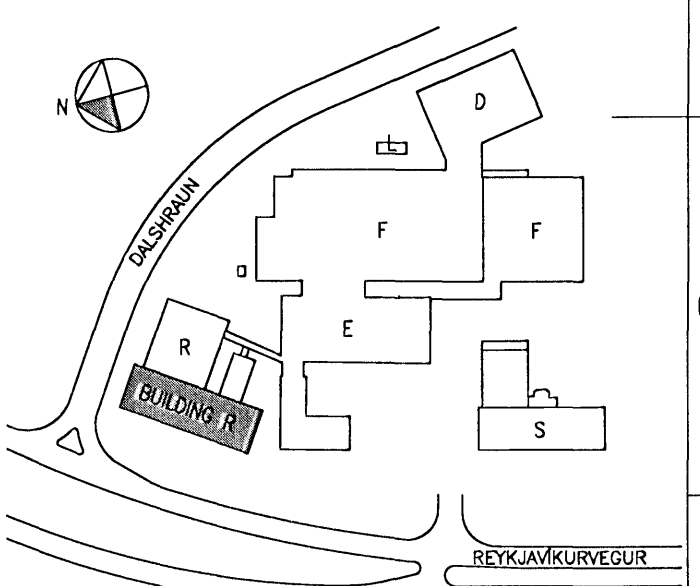

RAUNTEIKNING

18.09.2007

Dags. **ÚTI**

ARKTITEKTAR
 Jón Þór Þorvaldsson Af, FSSA
 Kf. 0212587579

No.	AMENDMENT	Date
D	Breyting á snösmeltu á 4 hæð og niðringu	10.08.2008
D	Breyting á stöðsetningu stífla	02.06.2006
C	Stíflaflakir og tengingar við geymslupólshæbergi	23.05.2006
B	Hlífablastrar og stýringar við hann, herb. R1000 a.fl.	10.05.2006
A	Breytingar á stíflum fyrir ofna auk eftirlitara	09.02.2006

actavis

Reykjavíkurvegur 80, Hafnarfjörður
 R-Laboratory Building - New Building
 HVAC-Heating System-Schematic Drawing

Drawing No.: ISIR-M50-/102E

Date: 28.09.2005	Scale: None	Project No.: 375
Filename: 375-Pfpukerfi.dwg		Design by: HBG/FSK
		Drawn: HBG
		Checked by: x/x

Sign.: *Sigrún Þorvaldsson*

ID 300346-3409