
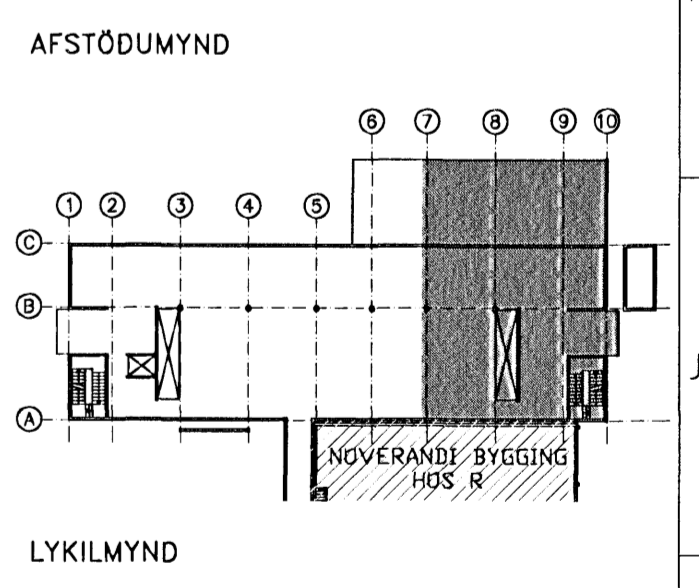


UNDIRRITUN
15.09.2007
HDS


Undirritun samræmingarhönnuðar:

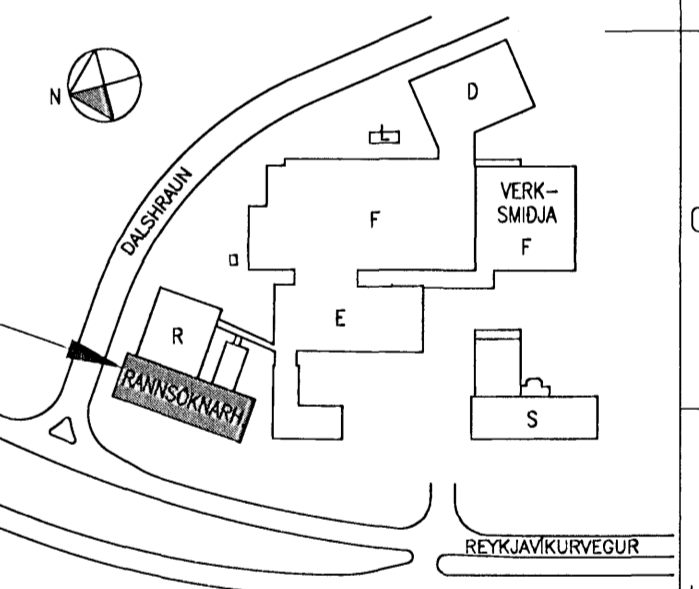

DALSHRAUN

RAUNTEIKNING

18.09.2007 Fsk
Dags. Samp.

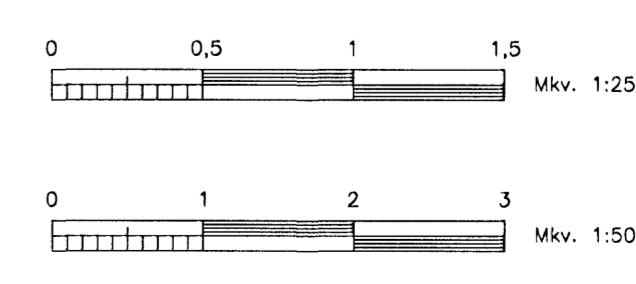

X	Xxx	xx.xx.xxx
Nr.	Lýsing á breytingu	Daga
actavis		
Reykjavíkurvegur 80, Hafnarfirði		
R-Rannsóknarhús - Nýbygging		
Inntök Hita- Vatns- og Rafveitu		
Grunnmynd - Kjallari og snið A og B		
Teikning nr.	IS1R-/-/-000	
Daga:	20.07.2005	Kvarði: 1:50/1:25 @ A1
Skjalshetti:	375-P/puikerfi.dwg	Verk nr.: 375
LAGNATÆKNI		Hannað: HBG
Hönnunar- og ráðgjafarstofa / FRV		Teiknað: HBG
Hönnunargötu 12, 200 Kópavogur, Ísland		Yfirfarð: x/x
Sími: 354-584 5252 fax: 354-584 5251		
E-mail: lagnatak.is http://www.lagnatak.is		
Samp.:	Jón Þór Þorvaldsson	
Kennitala:	300346-3409	

ÚTI
ARKITEKTAR
Jón Þór Þorvaldsson þ.f. FSSA
Kf. 0212597579