
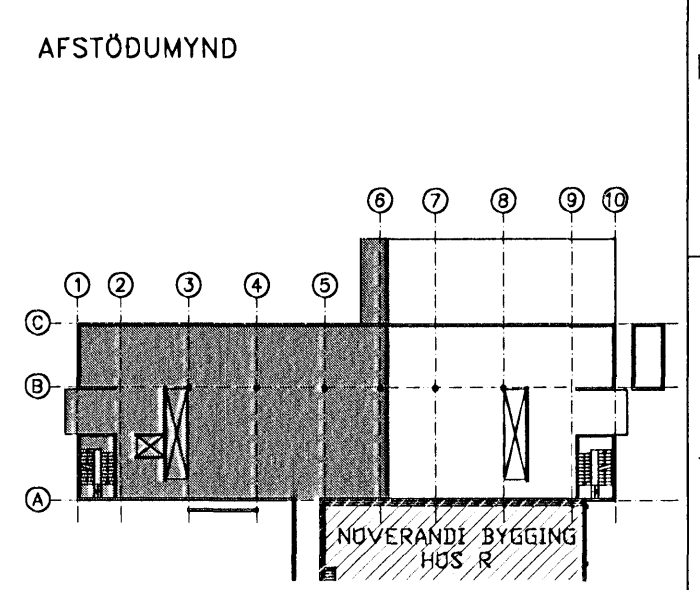


Undirritun samræmingarhönnuðar:

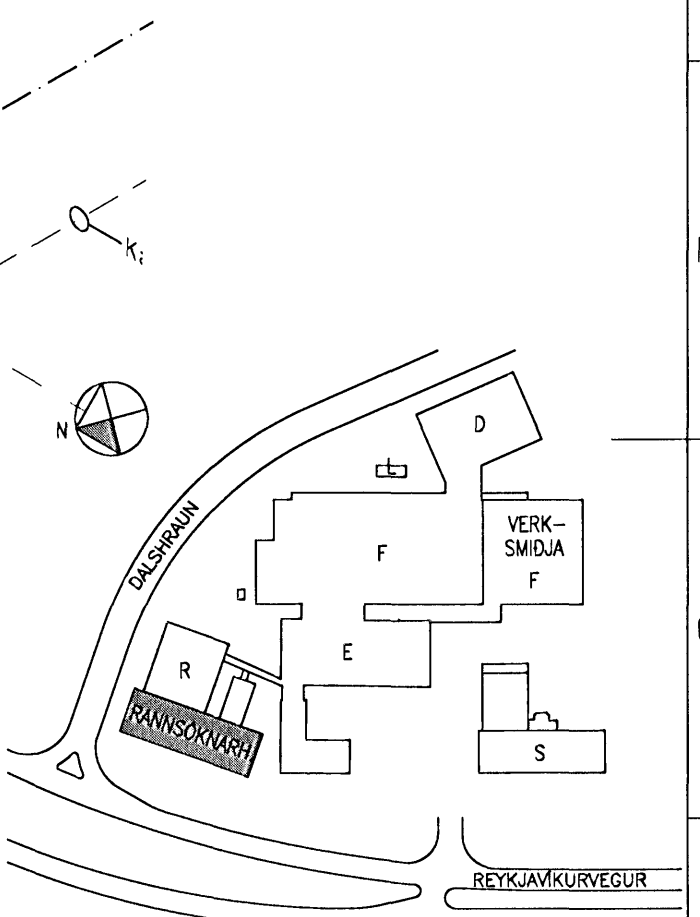

ÚTI
 ARKITEKTAR
 Jón Þór Þorvaldsson Aí, FSSA
 Kr. 021256 7579


MESTA FJARLEGD MILLI PÍPUFESTINGA (STÁLPIPUR)

PÍPUSTÆRD	LÆRITTAR PÍPUR	LÖÐRITTAR PÍPUR
DN 10-DN 15	1,5 METRAR	1,8 METRAR
DN 20-DN 52	2,5 METRAR	3,0 METRAR
DN 40-DN 50	3,0 METRAR	3,5 METRAR
DN 65-DN 80	3,5 METRAR	4,0 METRAR

RAUNTEIKNING

18.09.2007 FSK

Dags. Samp.

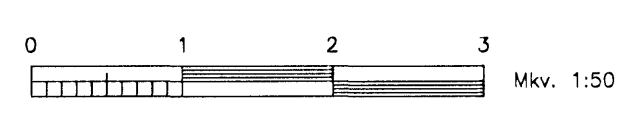

actavis
 Reykjavíkuregur 80, Hafnarfirdi
 R-Rannsóknarhús - Nýbygging
 Pípukerfi
 Ráðmynd - Kjallari - Hluti I

Tekning nr. IS1R-M40/41/50-00-211A
 Dags: 28.09.2005 Kvarði: 1:50 A1
 Skjalshéiti: 375-Pípukerfi.dwg Verk nr.: 375
Hönnuð: FSK/HBG

LAGNATÆKNI
 Hönnun- og iðgjafarstafa / FRV
 Hamraborg 12, 200 Kópavogur, Ísland
 Sími +354-564 5252 fax +354-564 5251
 H@lagnotak.is http://www.lagnotak.is Tölknað: HBG
Yfirforð: x/x

Samp.: *Fridrik S. Jónsson*
 Kennitala: 300346-3409