
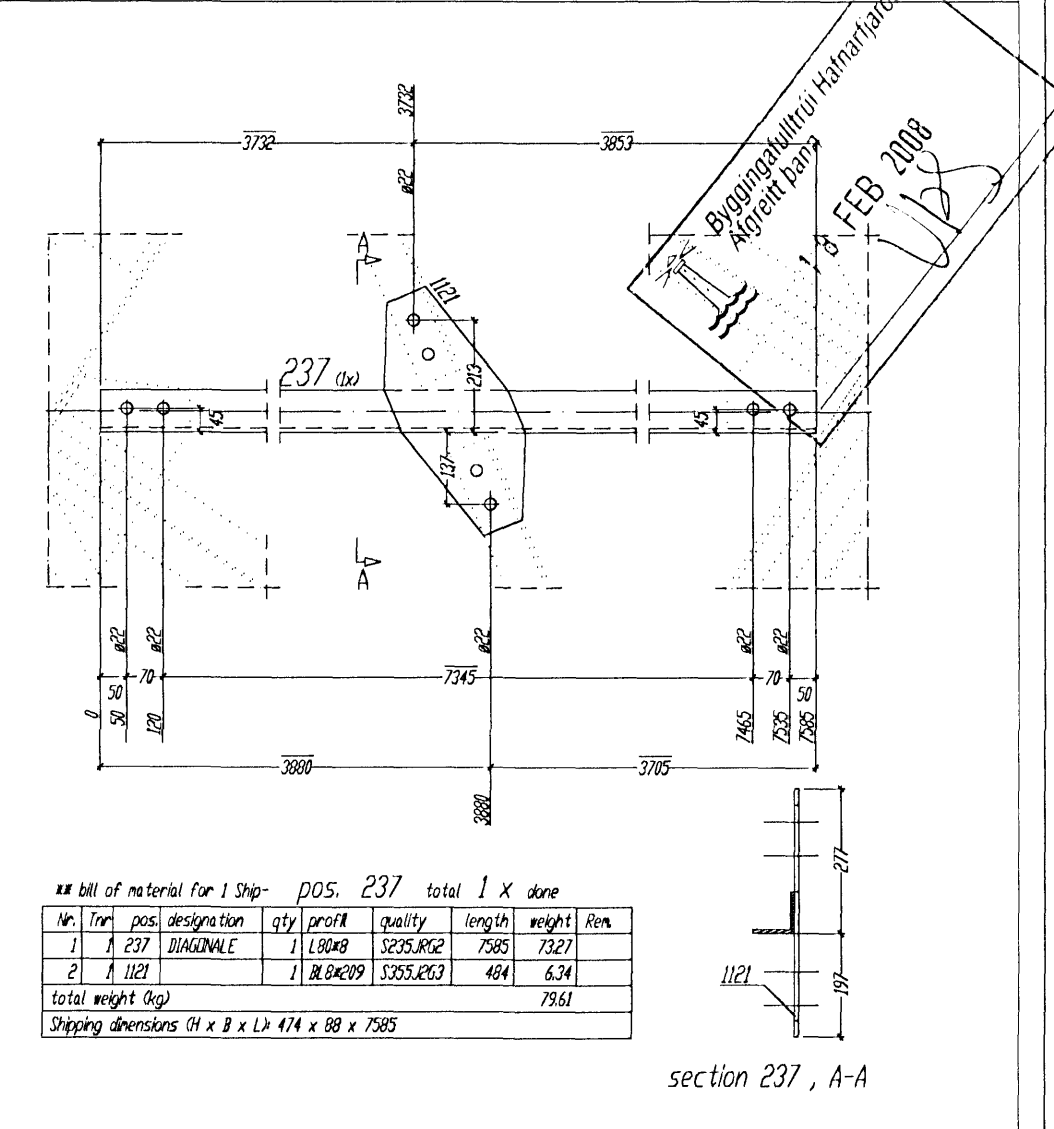
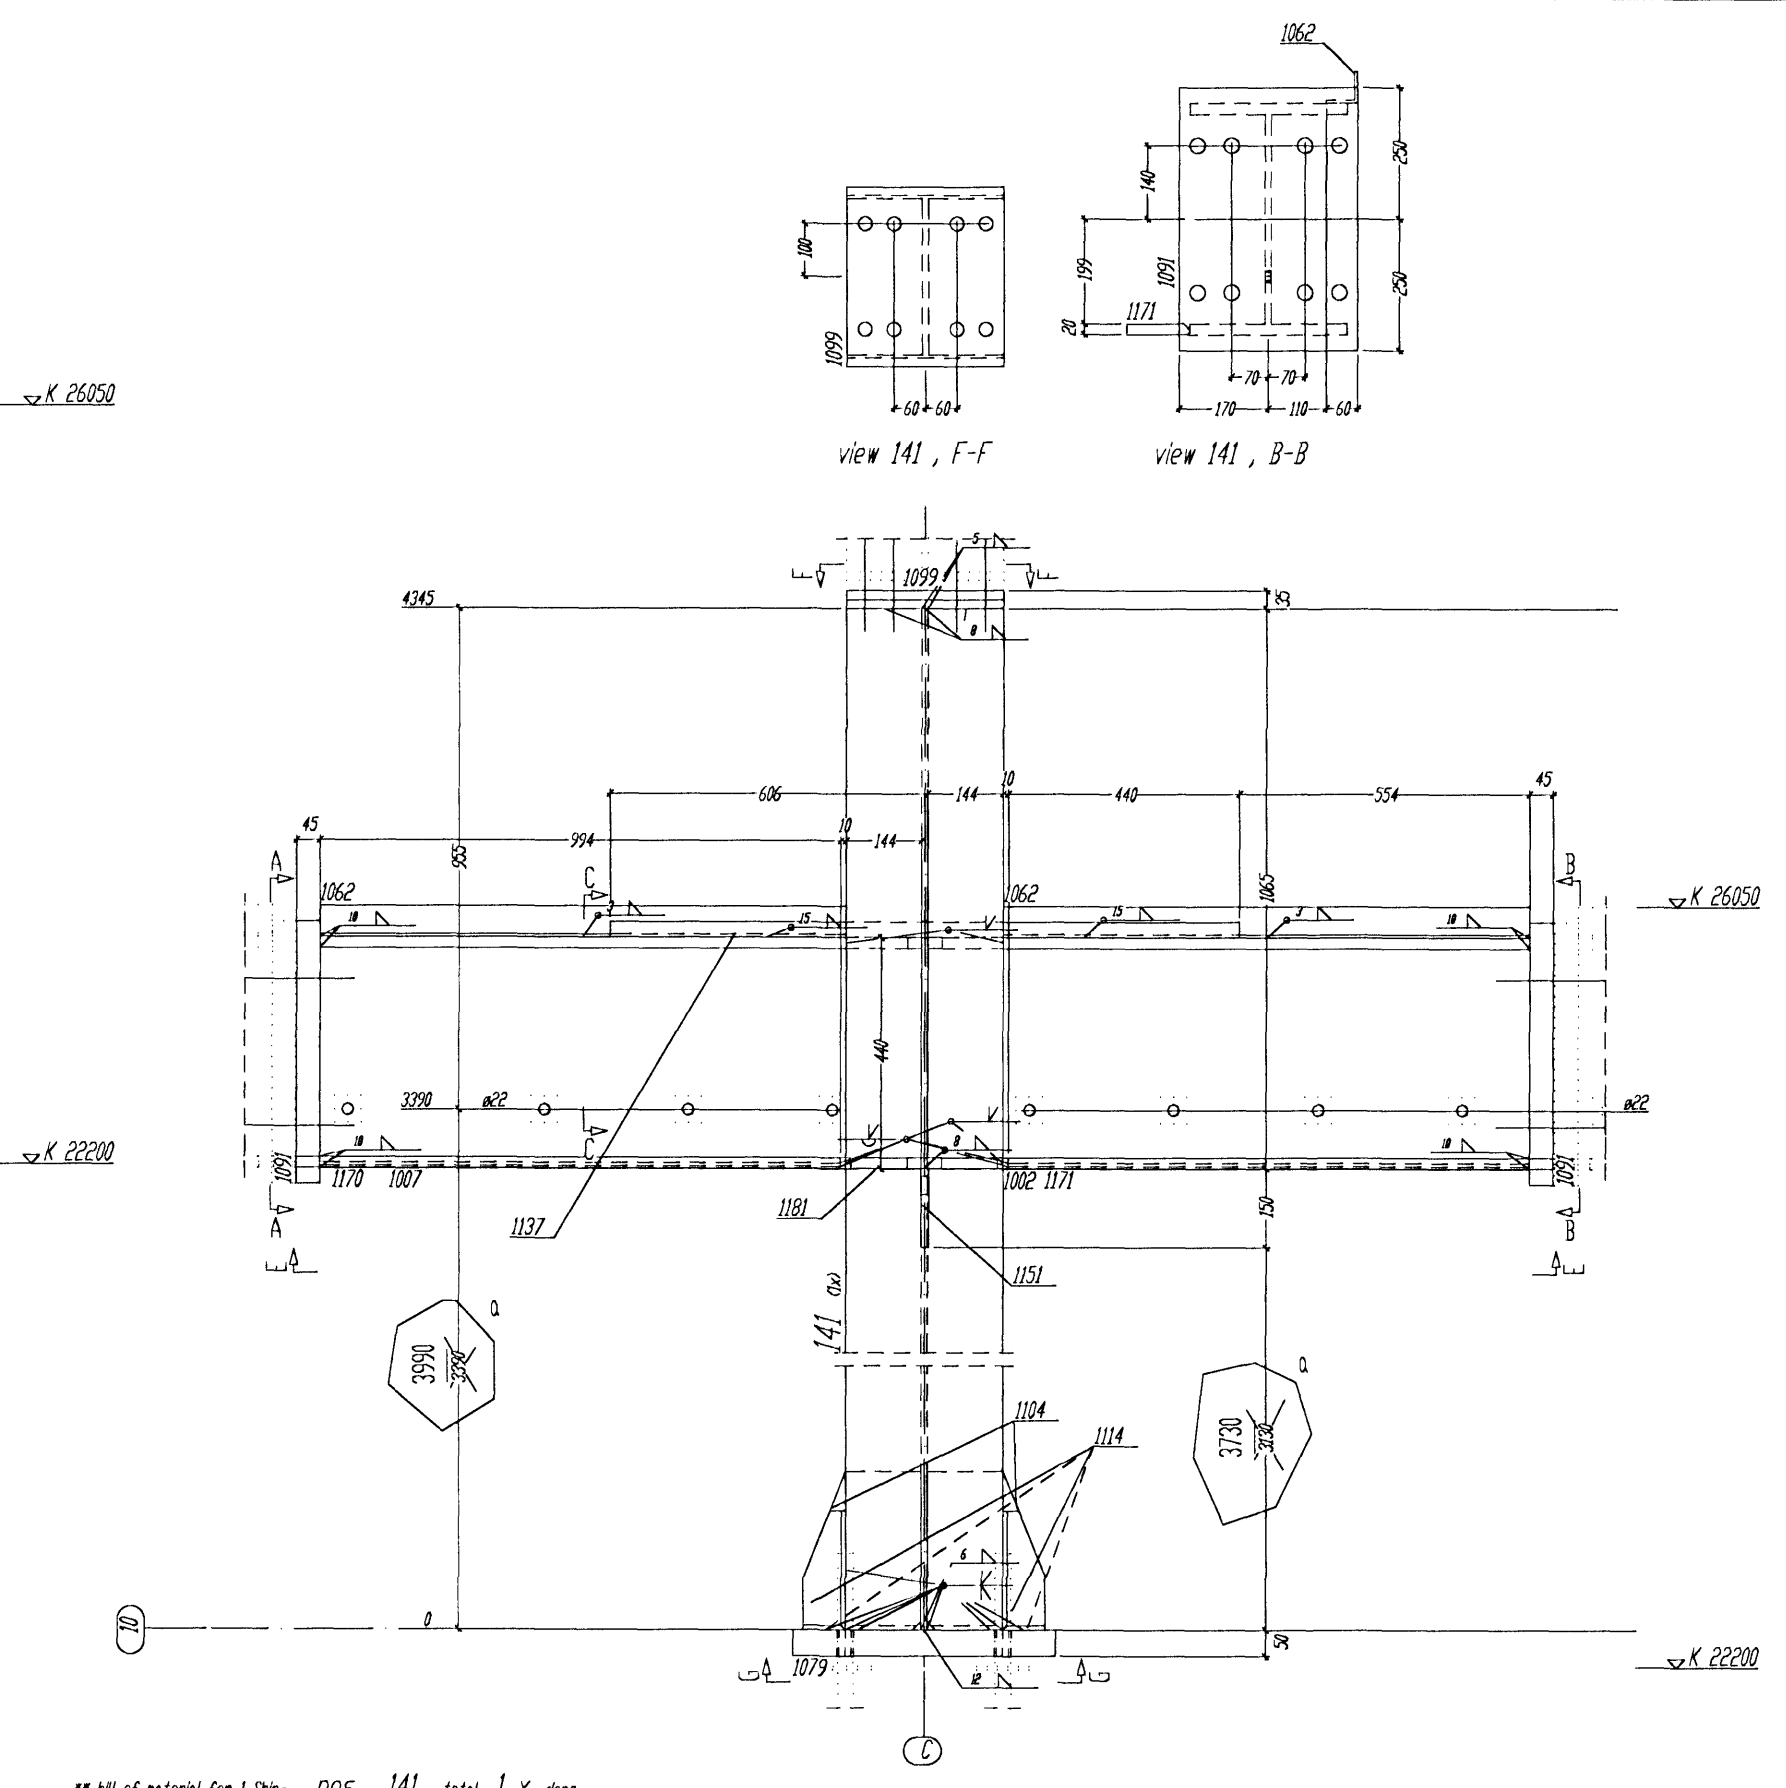
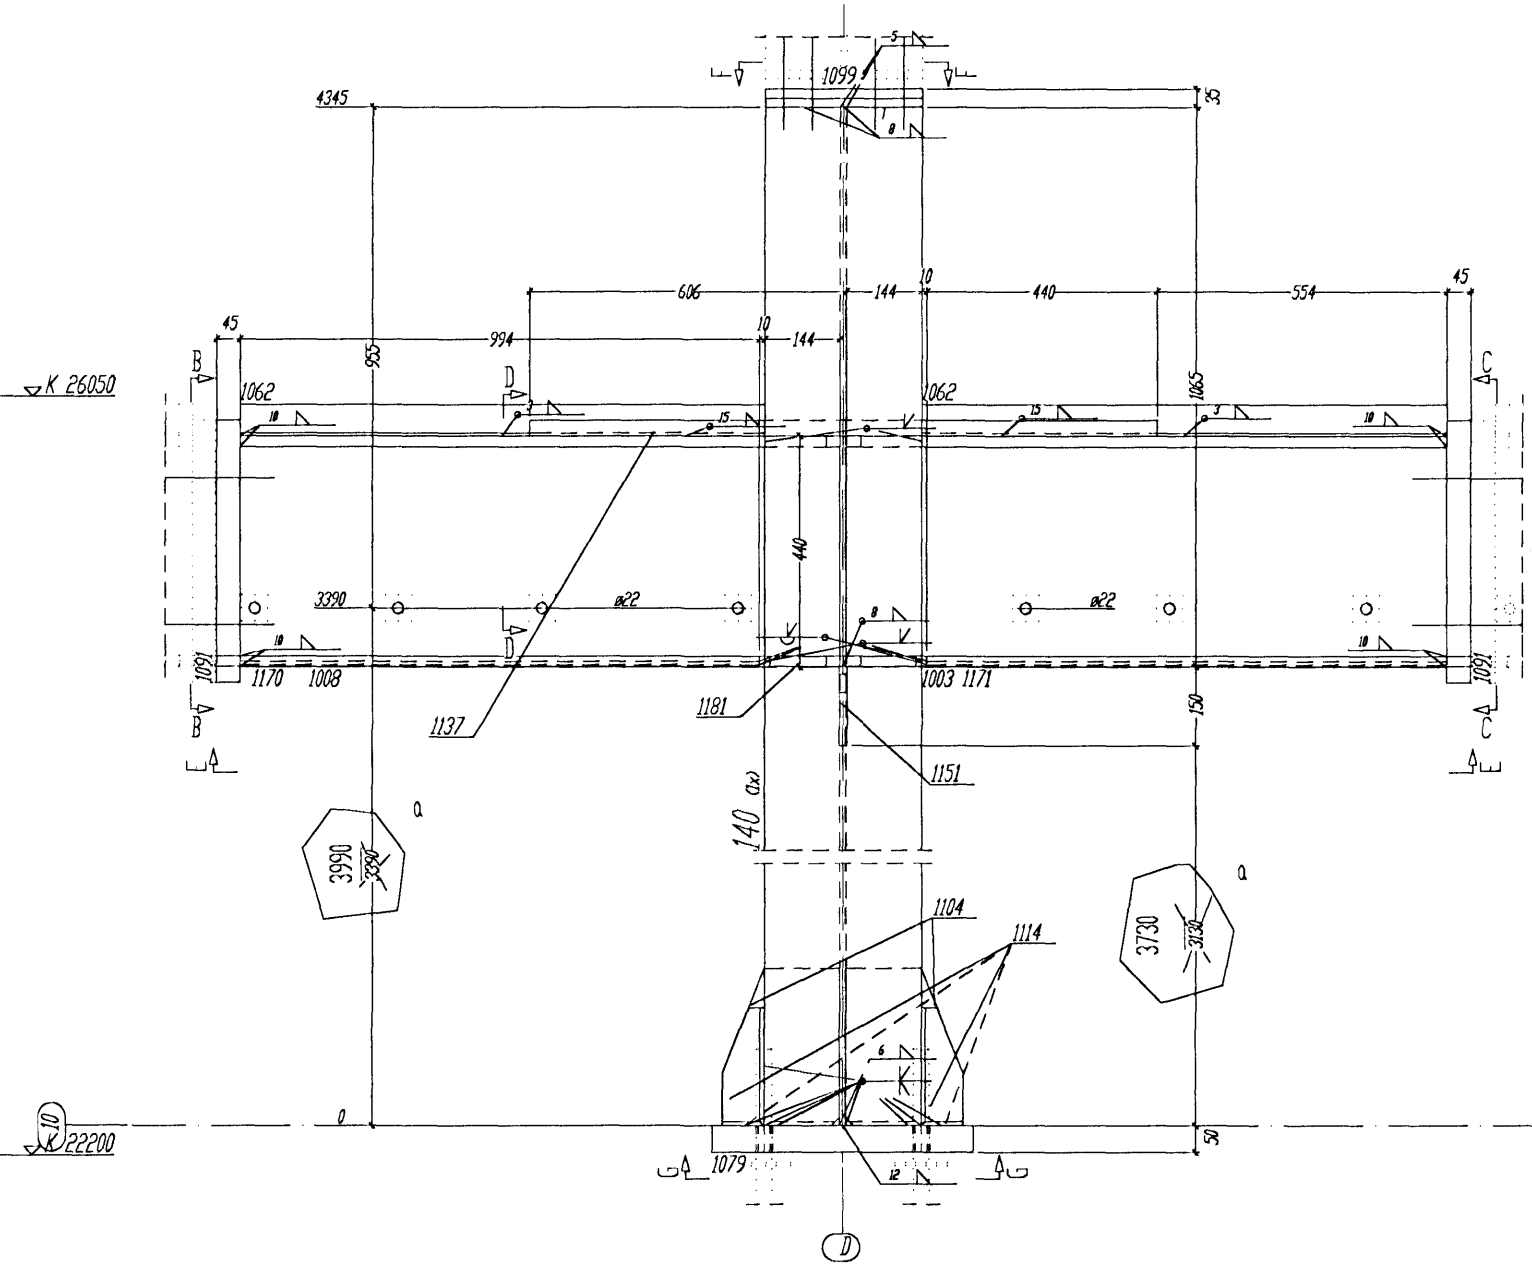



 16. FEB 2008

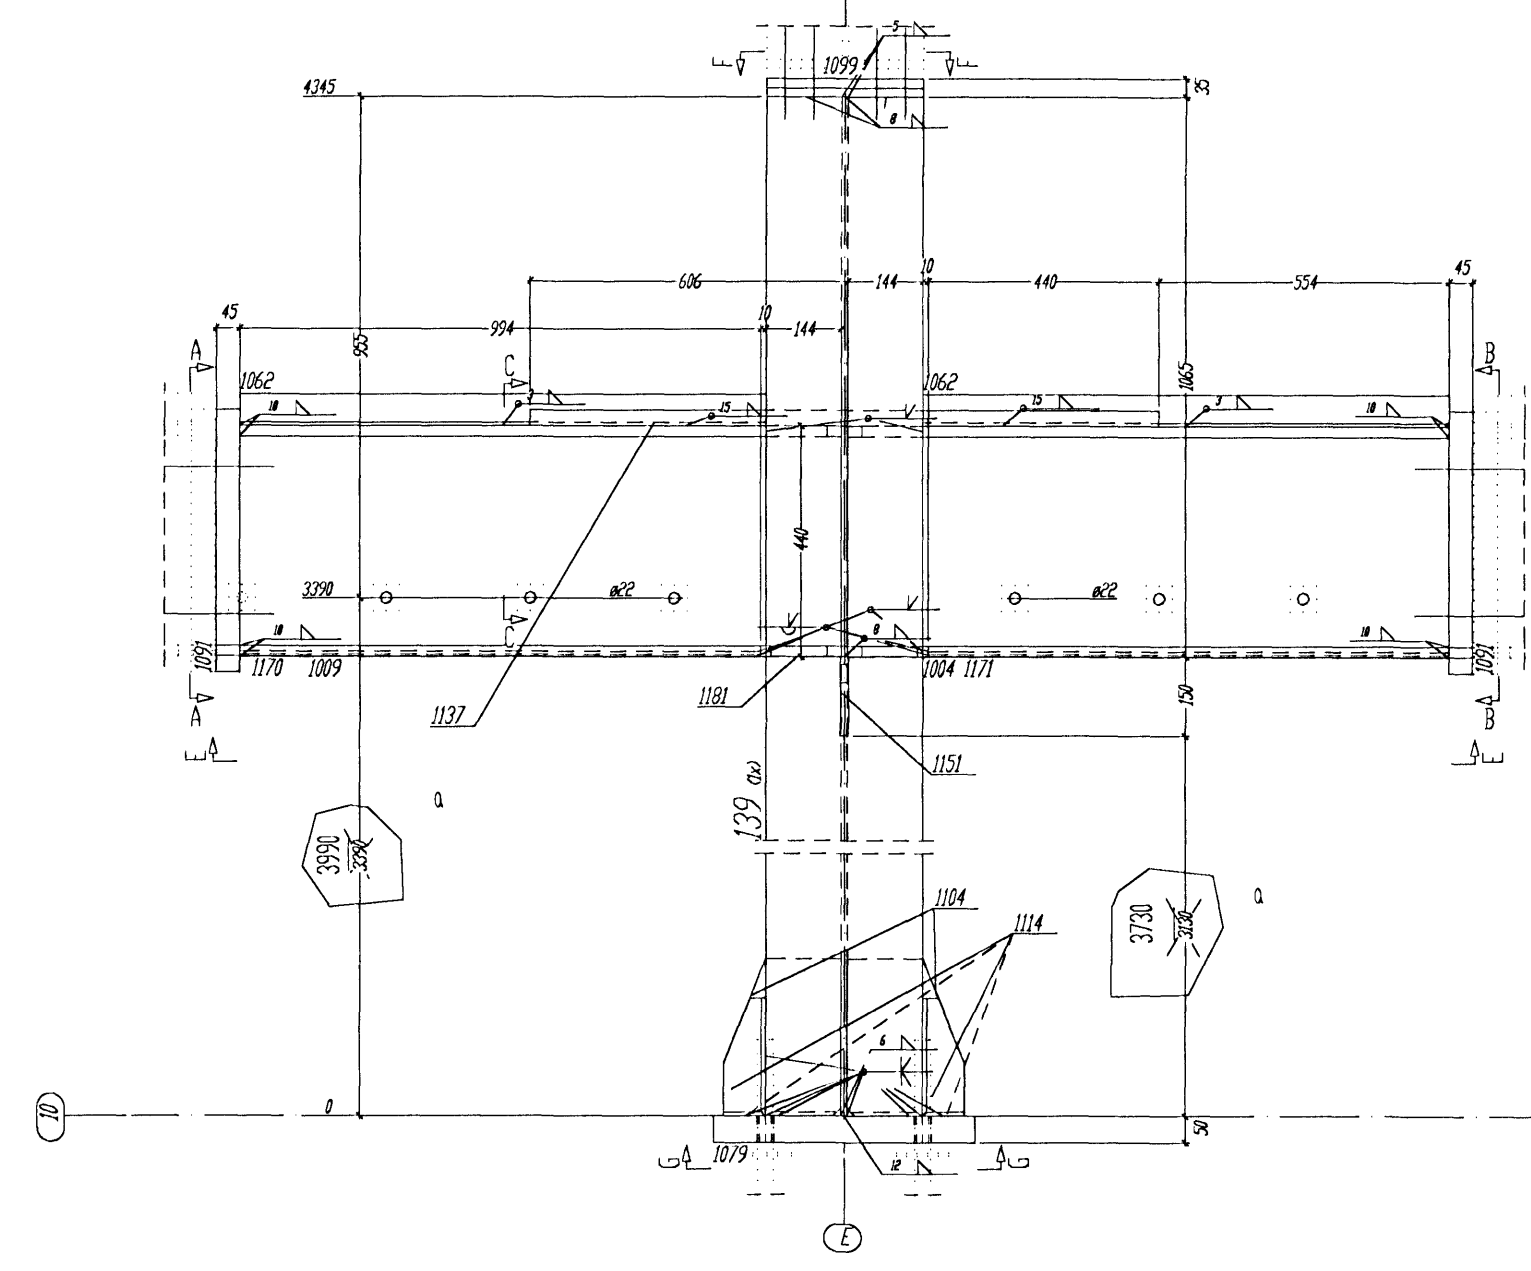

Bill of material for 1 Dip. POS. 139 total 1 X done

Nr	Part pos.	designation	qty	prof	quality	length	weight	dim	



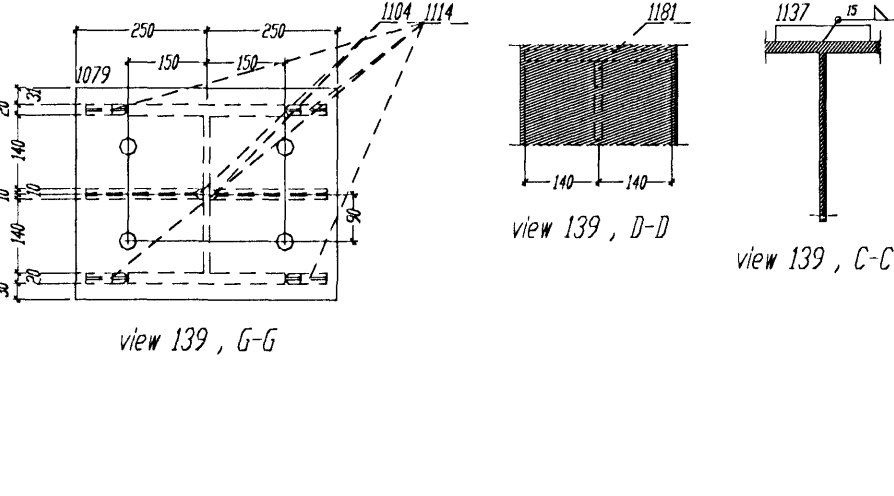

Bill of material for 1 Dip. POS. 140 total 1 X done

Nr	Part pos.	designation	qty	prof	quality	length	weight	dim	









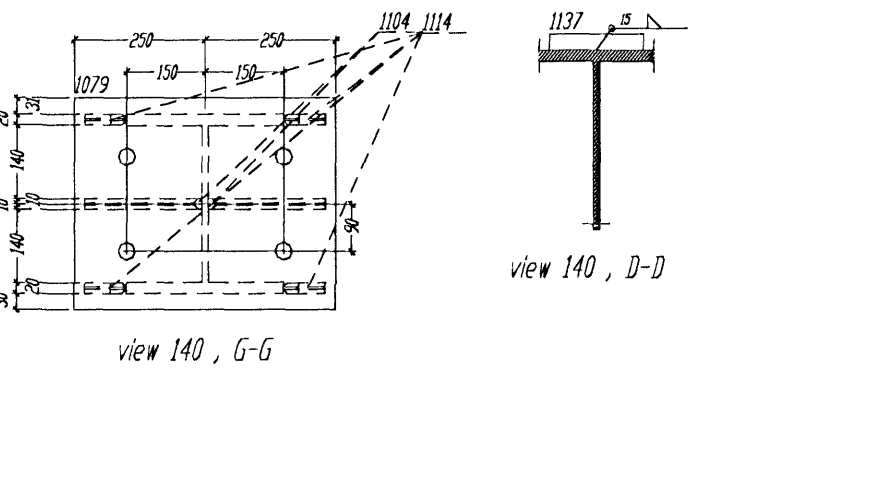

Bill of material for 1 Dip. POS. 141 total 1 X done

Nr	Part pos.	designation	qty	prof	quality	length	weight	dim	


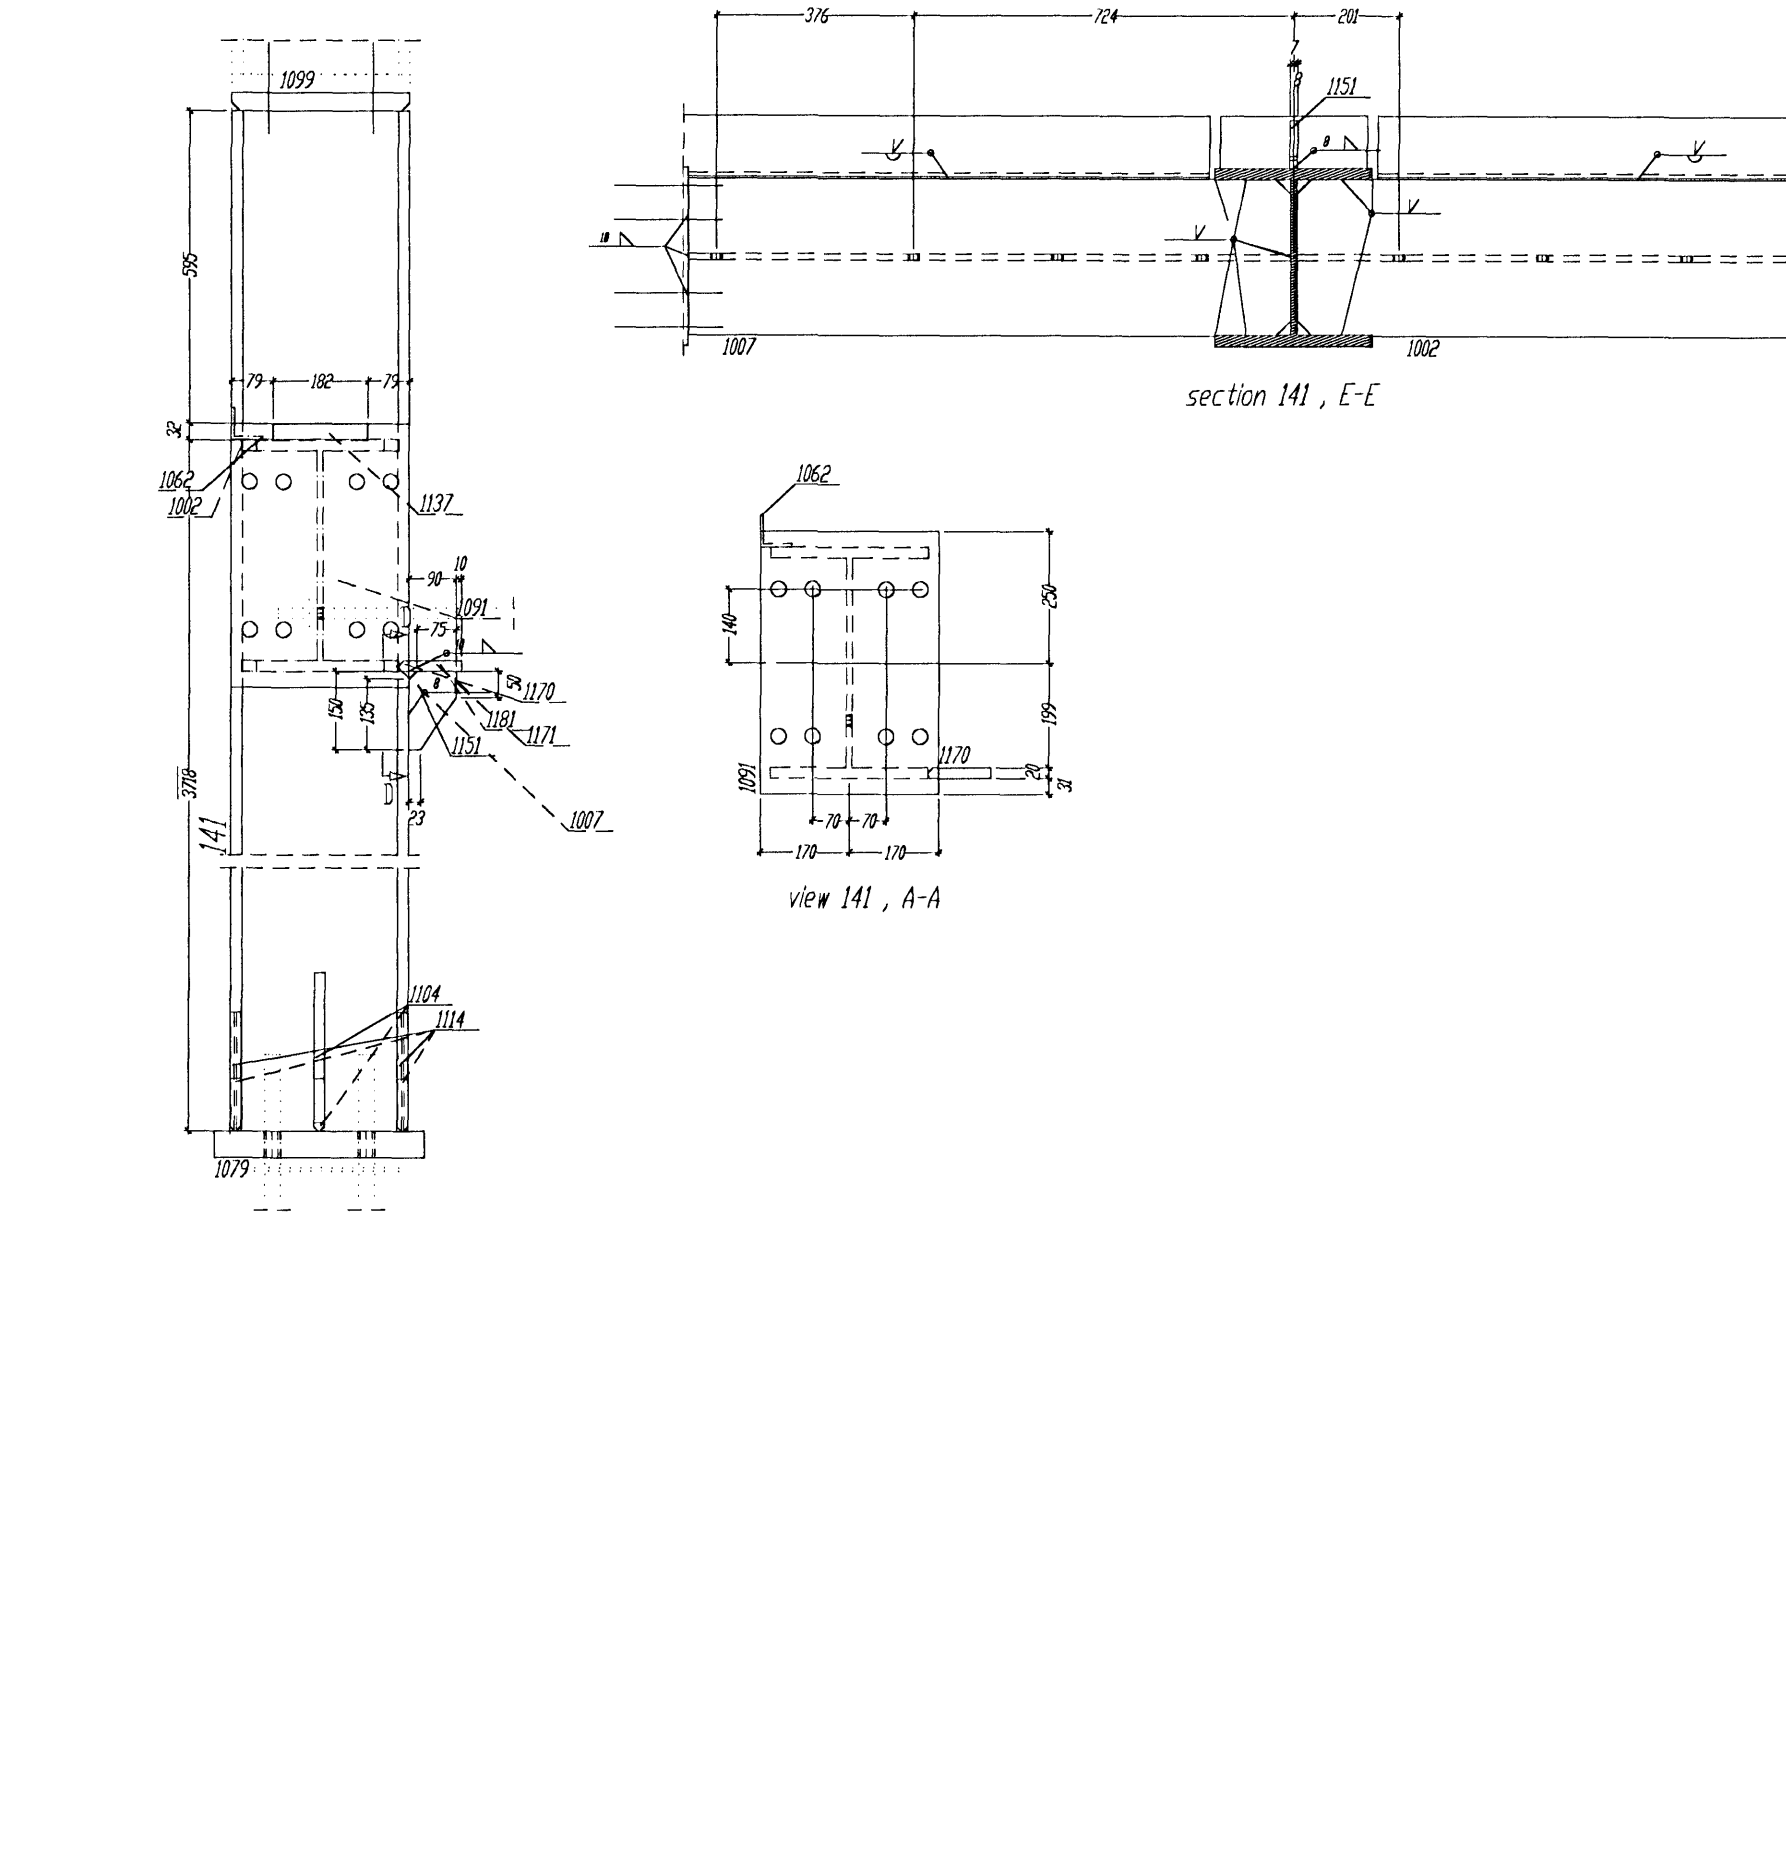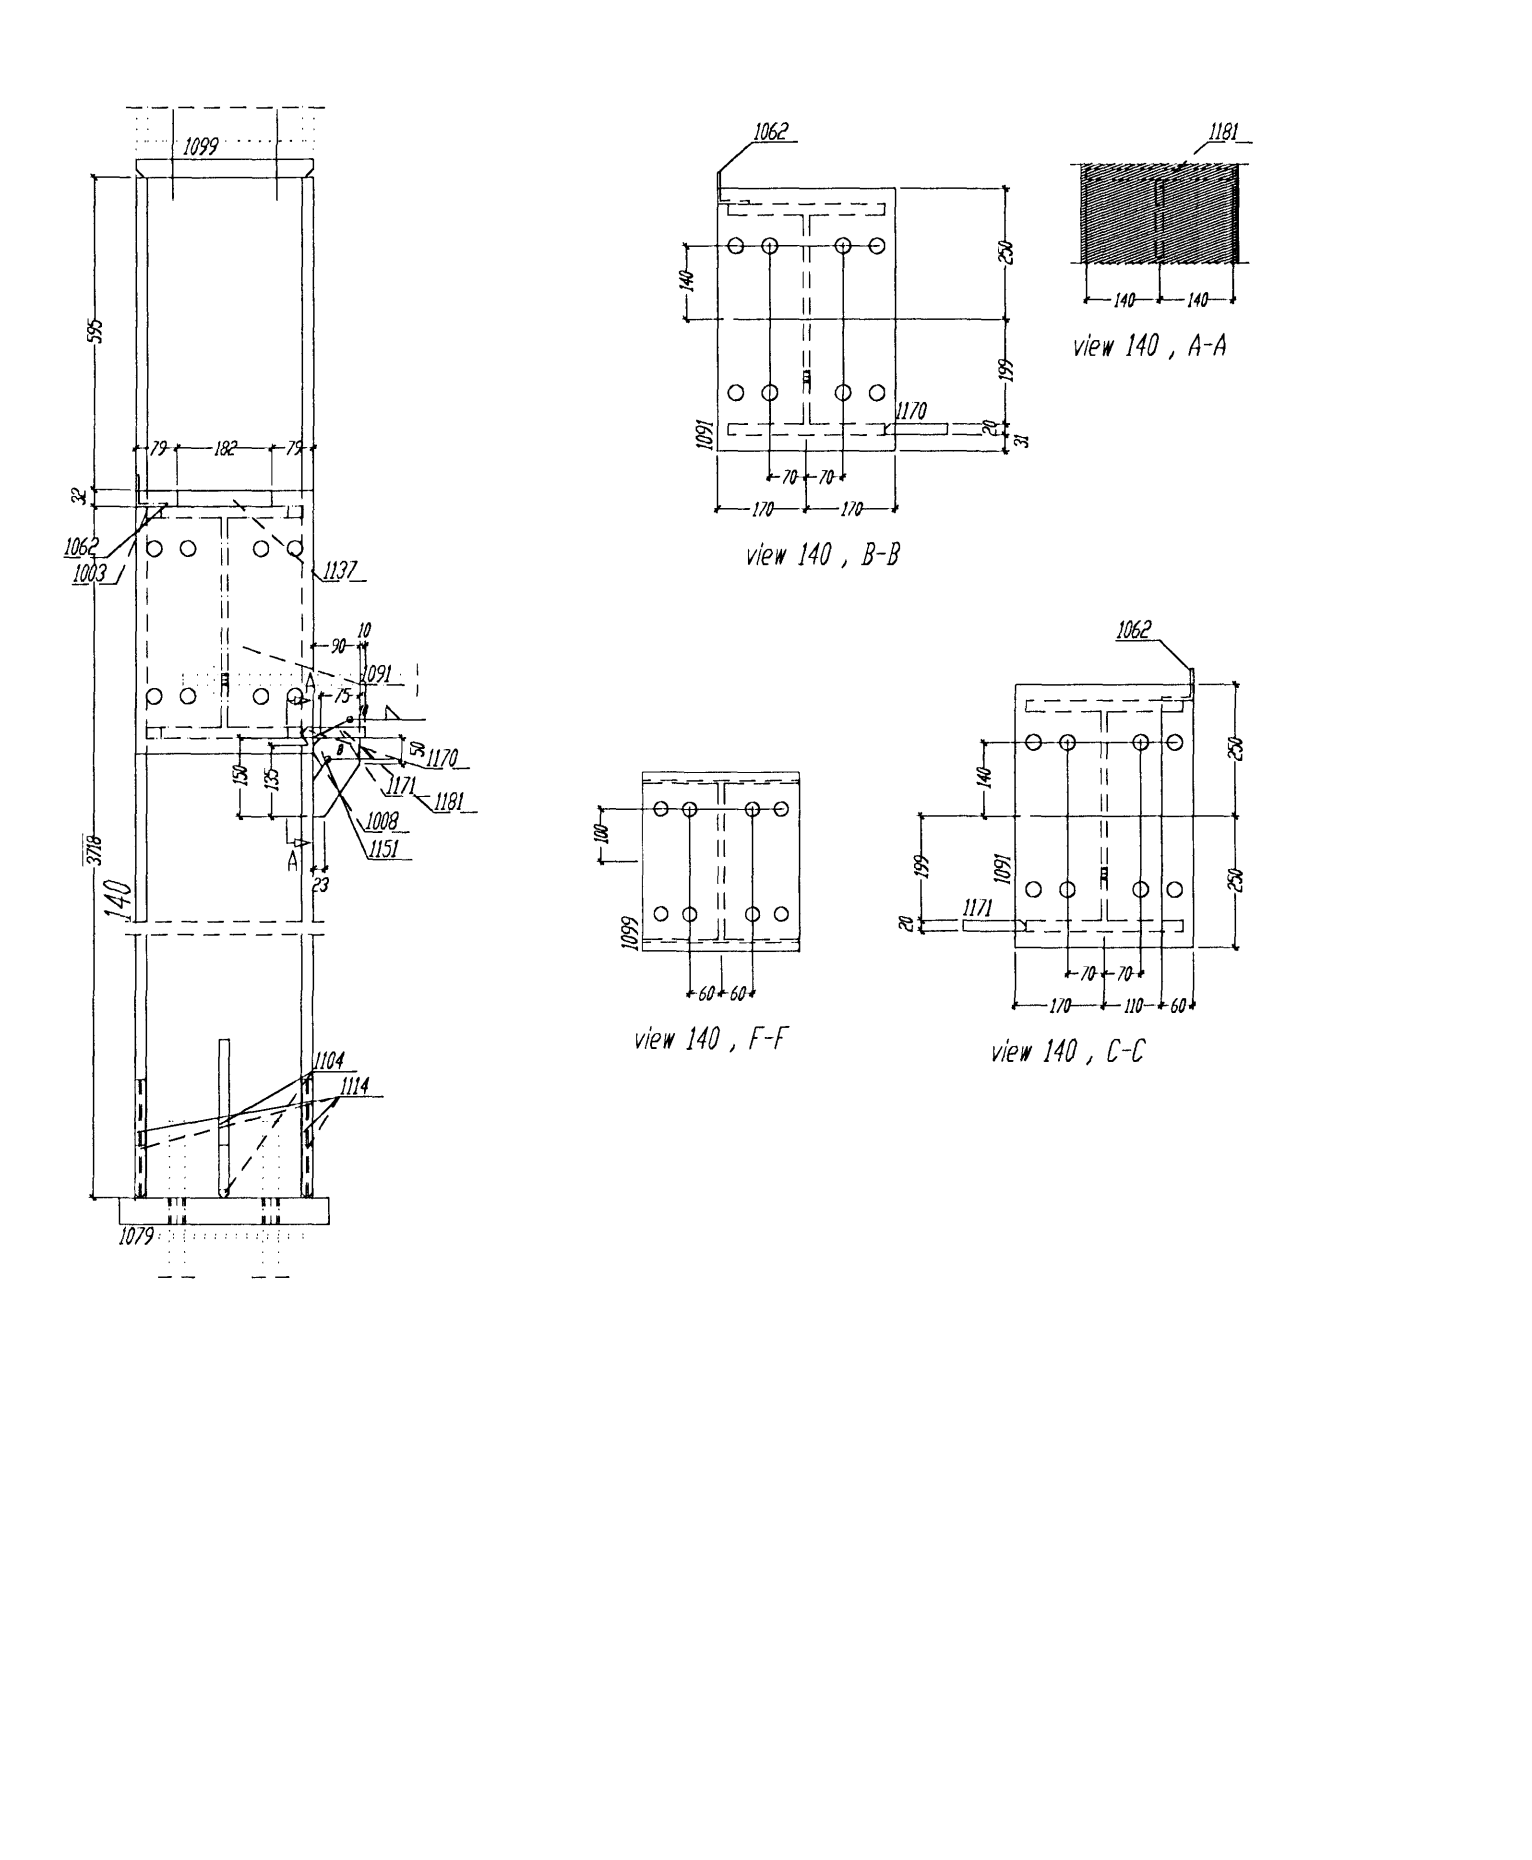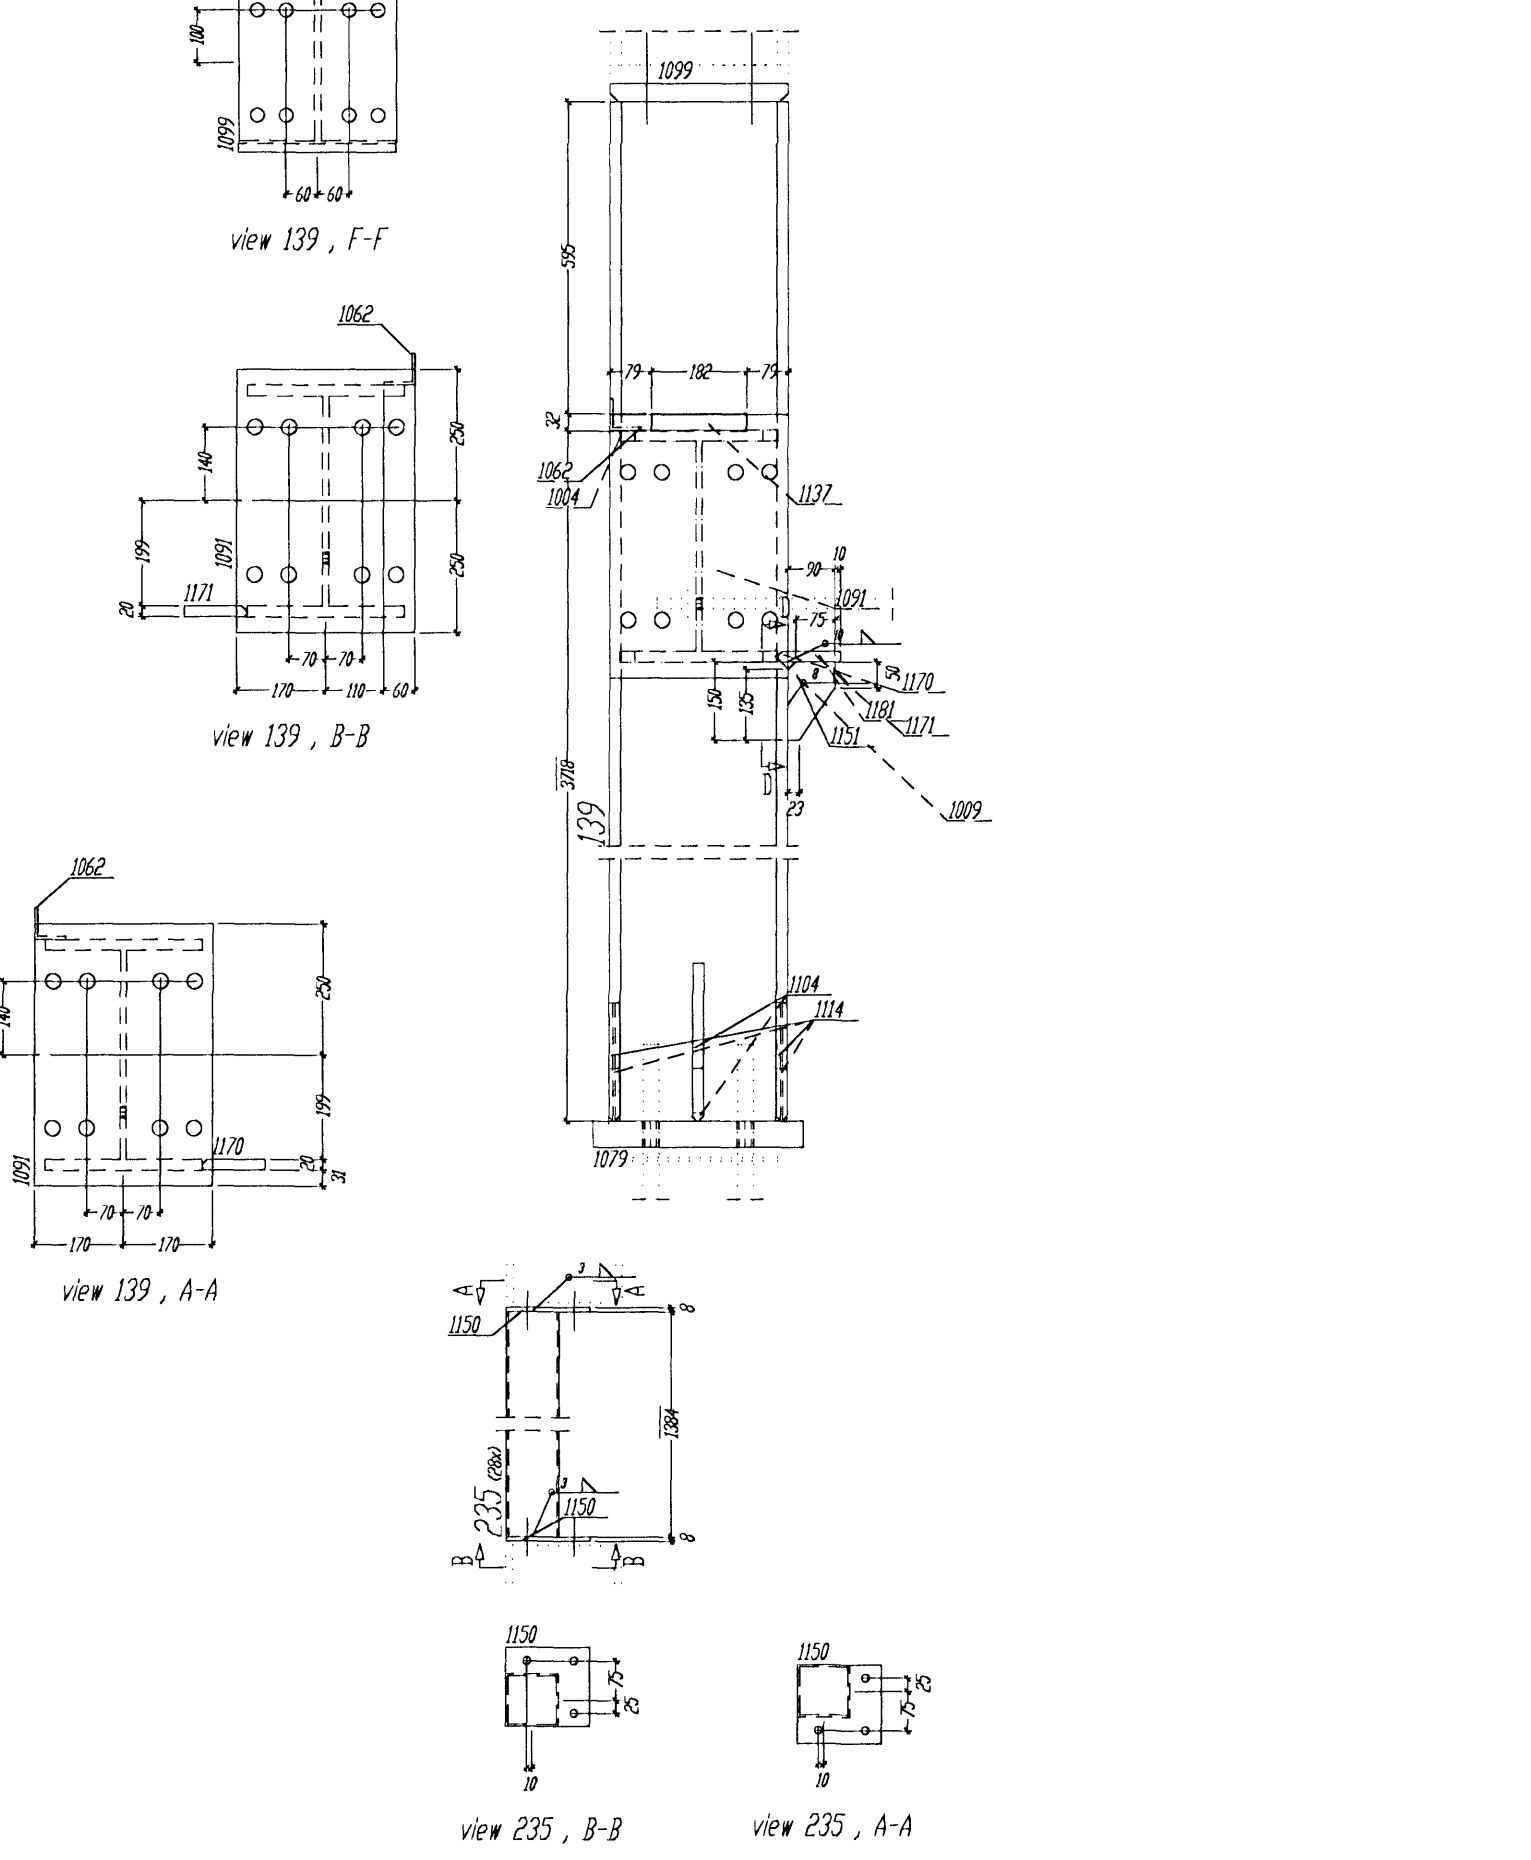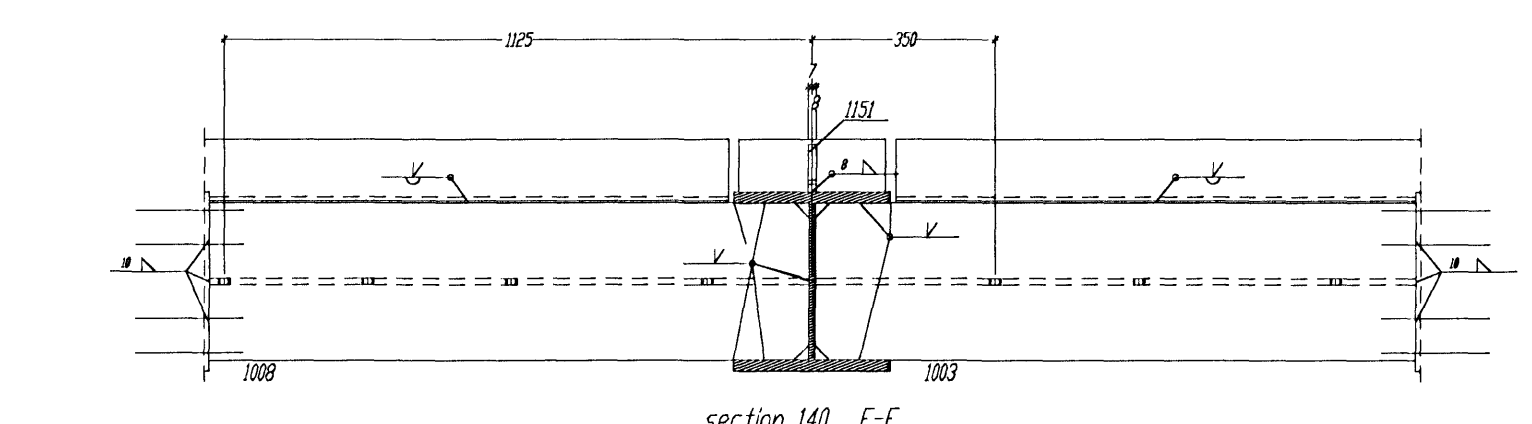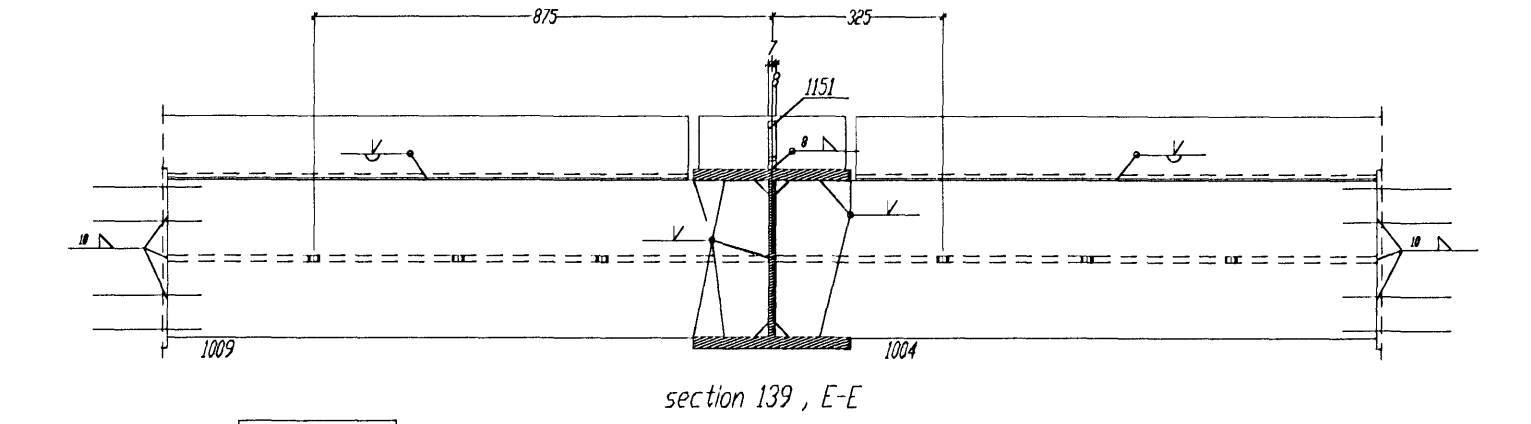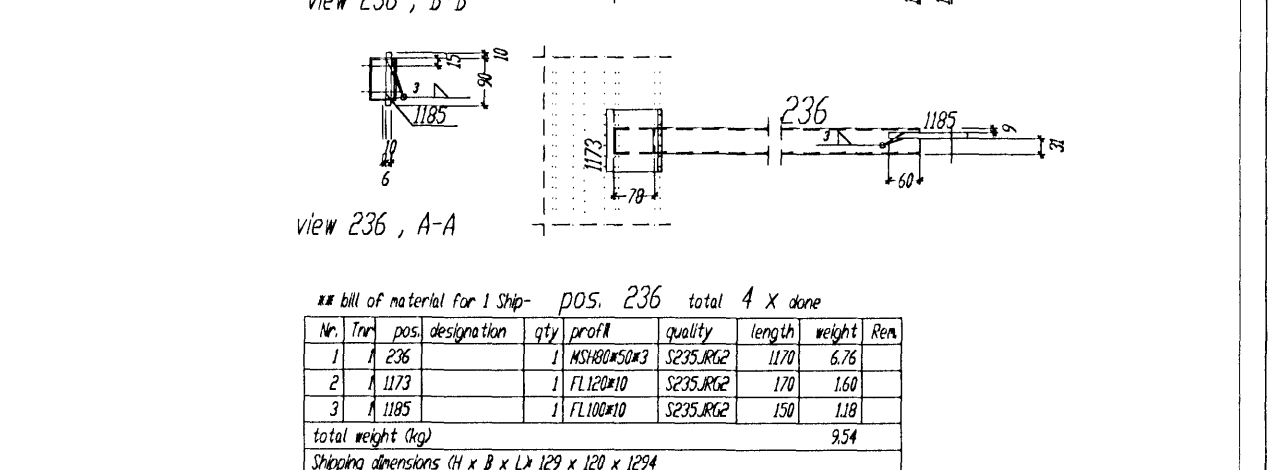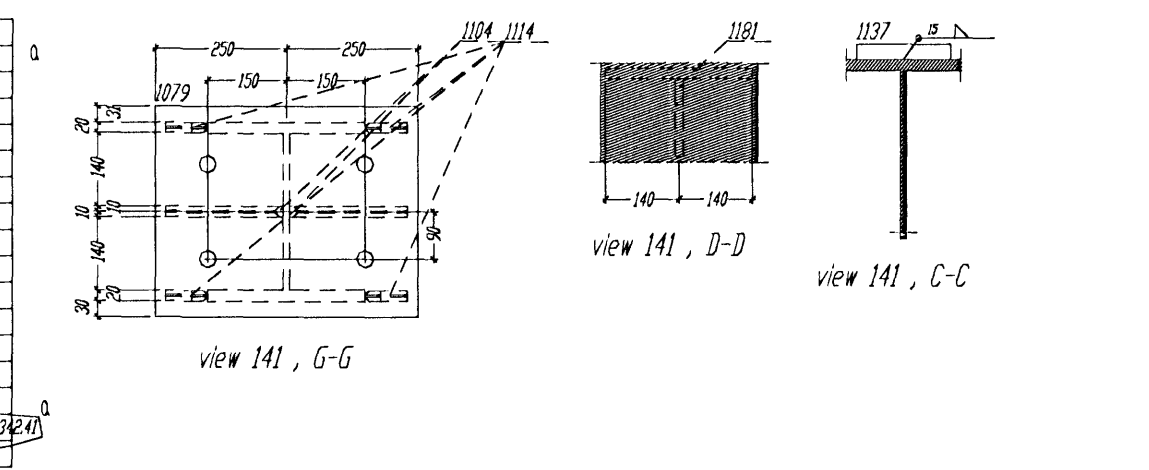

Bill of material for 1 Dip. POS. 236 total 4 X done

Nr	Part pos.	designation	qty	prof	quality	length	weight	dim	


Fyrir hönd Conis ehf, kt. 600105-1400
 staðfestist að teikning þessi hefur verið
 yfirfirin. Teikningin er í samræmi við
 íslenska staðla og reglugerðir. 28/10/07
 130557-41/05
 Kennitala

Tolerance for welded constructions
 According to DIN 8570, Pt.1+2/3/4/5/6/7
 Welding (WPS) according to
 DIN-EN 288 - 2

All unmarked welds to be fillet
 continuous a-fan thick,
 not greater than 0.7 d
 of the thinner element

The material for cap plates 20 mm thick
 to be examined for laminations

Required torque-stressing forces and forced
 tension angles according to DIN 18800 Pt. 7, 03/93


BIURO INZYNIERSKIE
 Marek i Janina MUCHA
 Osiny, ul. Opolska 30a, 46-070 Komprachcice tel.077-46 46 757

DATE	NAME	SIGNATURE	DWG SCALE
23.02	Marta		

Pos. 139-141,235-237
 TJARNARVELLIR 11
 Steel Office part
 DRG 114 a