
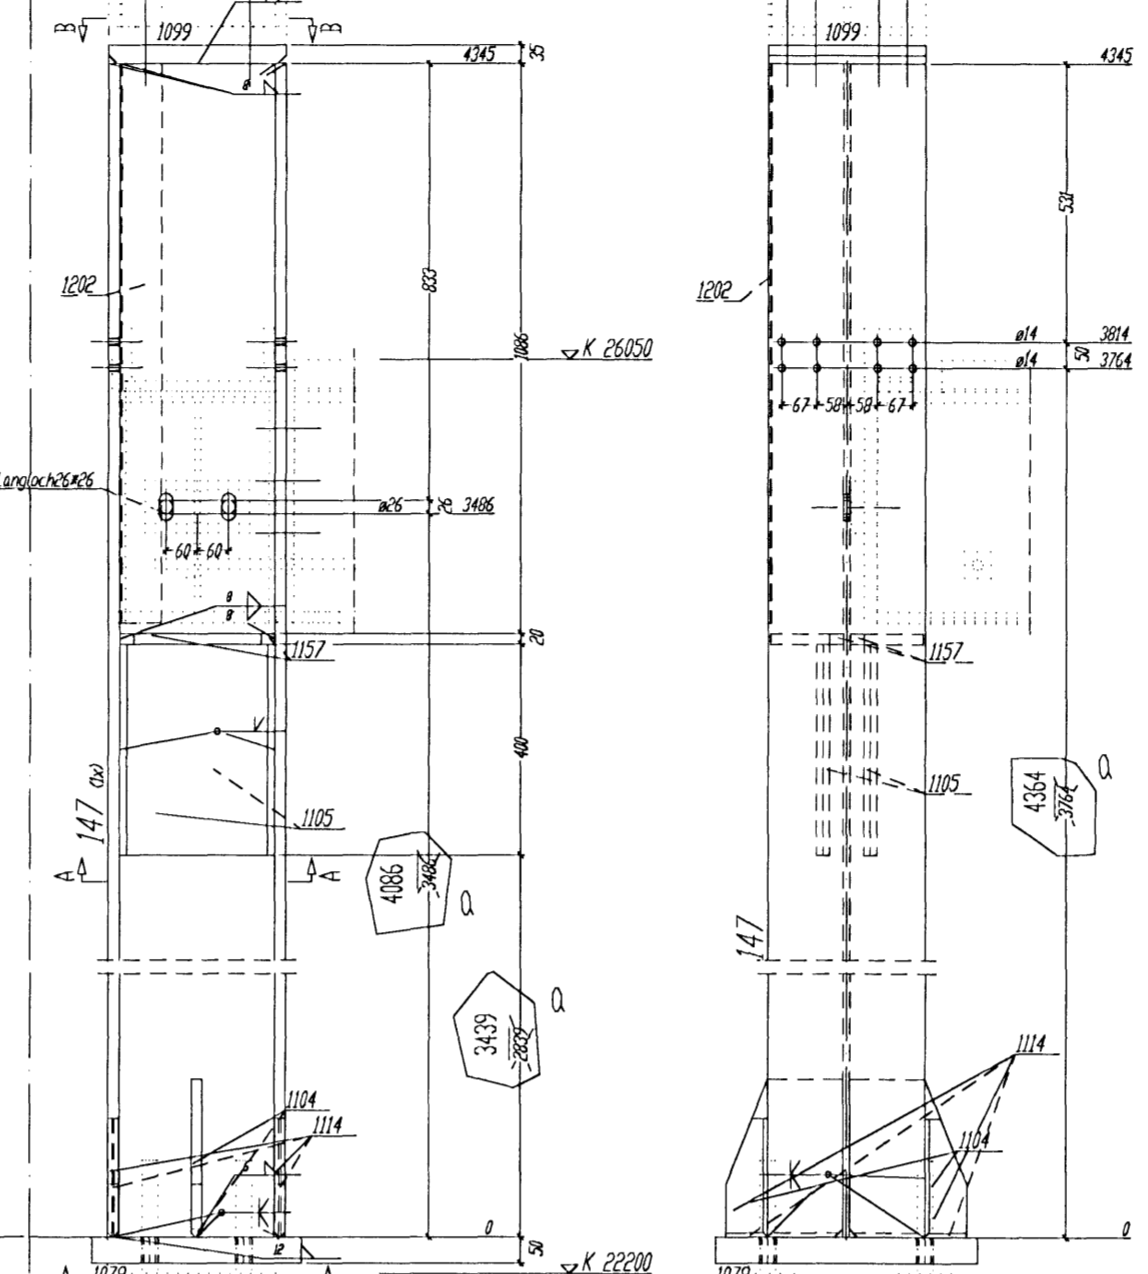
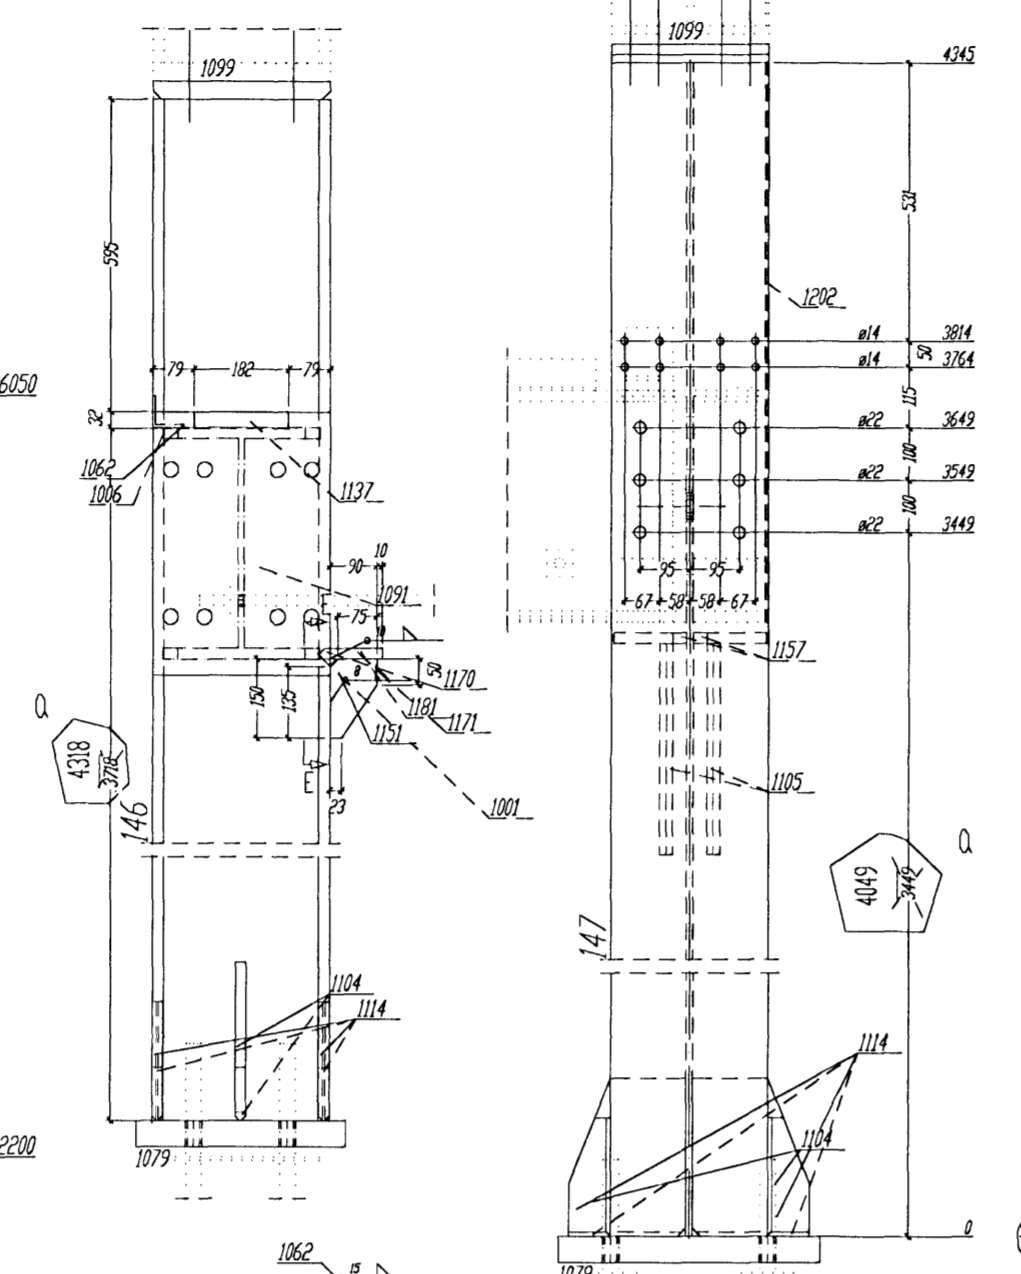
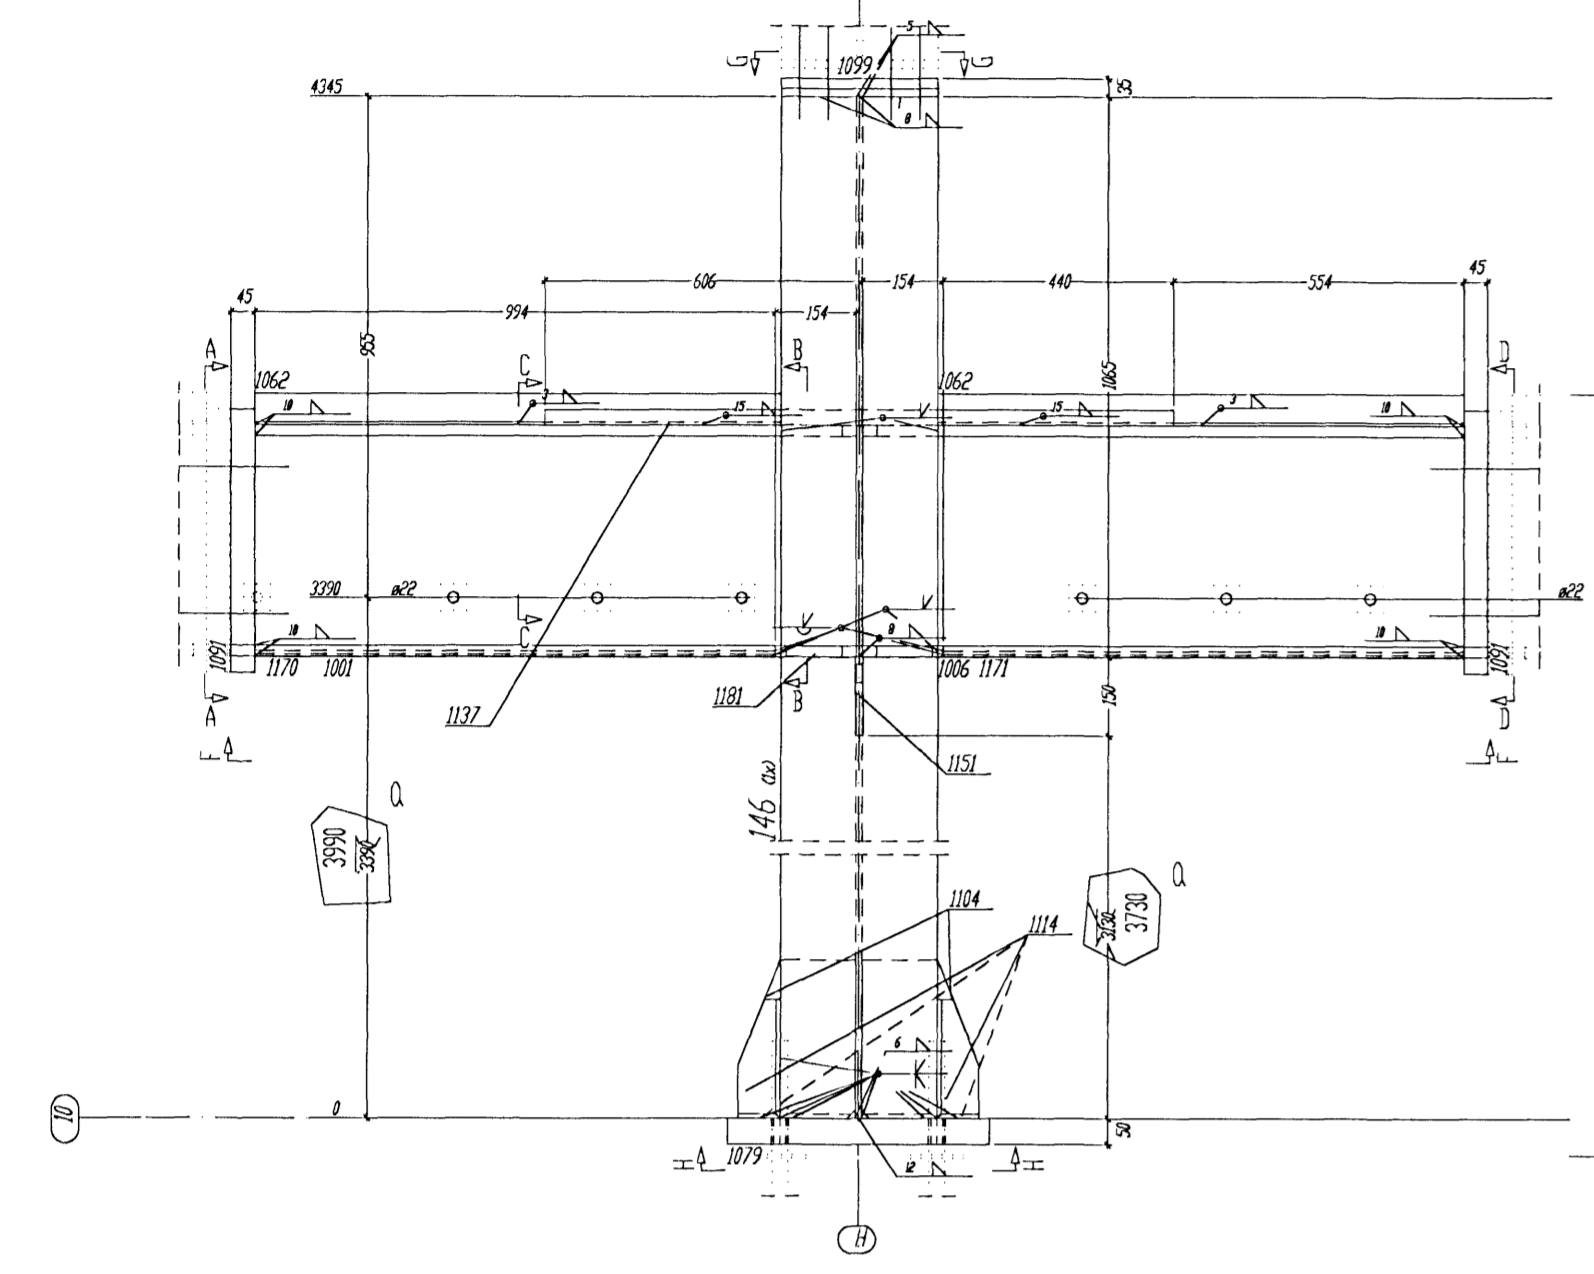
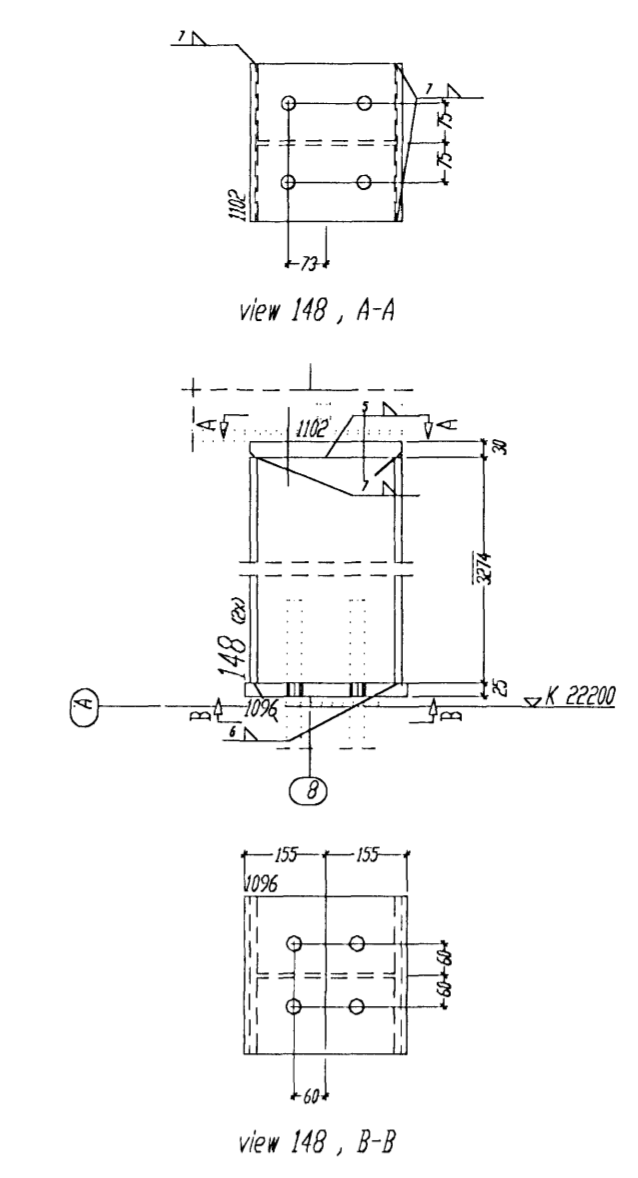
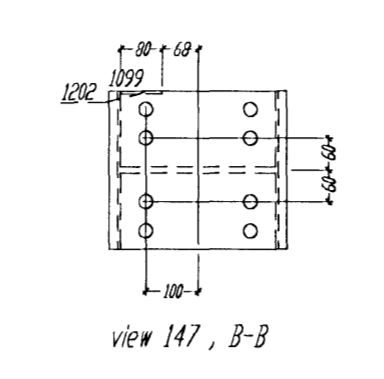







16 FEB 2008
118

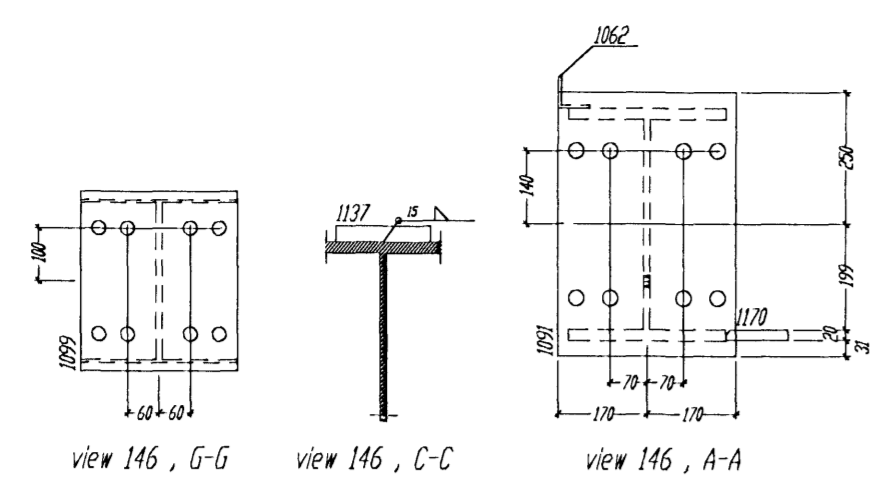

of material for 1 Dip: POS. 148 total 2 X done

| Nr | Pos | designation | qty | profil | quality | length | weight | dim |
|------------------|-------|-------------|-----|--------|---------|--------|--------|-----|

Shipping dimensions 01 x B x L3 300 x 200 x 2200

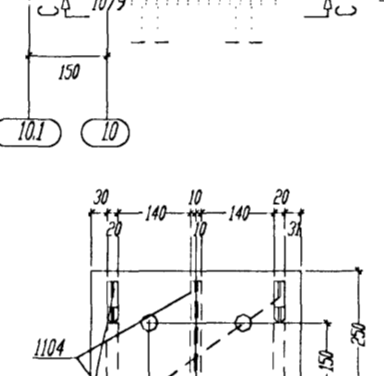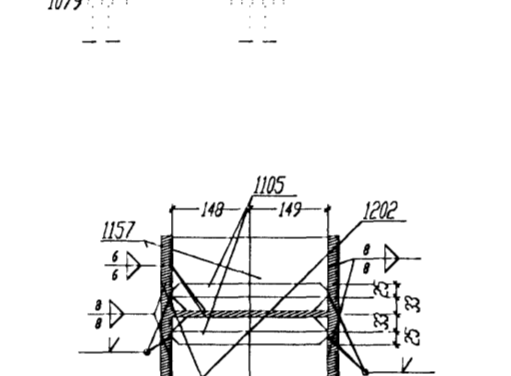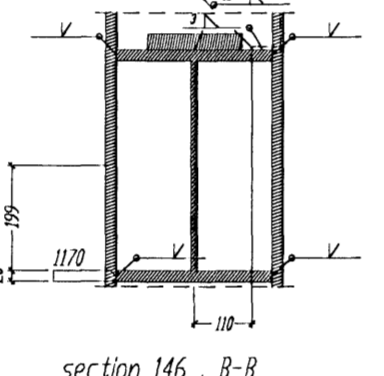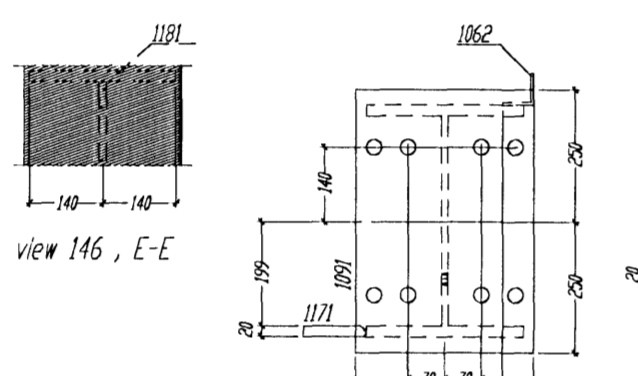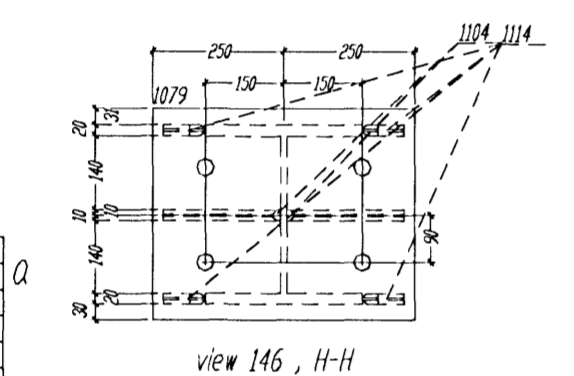

of material for 1 Dip: POS. 147 total 1 X done



| Nr | Pos | designation | qty | profil | quality | length | weight | dim |
|------------------|-------|-------------|-----|--------|---------|--------|--------|-------|

Shipping dimensions 01 x B x L3 400 x 500 x 4400

of material for 1 Dip: POS. 146 total 1 X done

| Nr | Pos | designation | qty | profil | quality | length | weight | dim |
|------------------|-------|-------------|-----|--------|---------|--------|--------|--------|


Shipping dimensions 01 x B x L3 400 x 200 x 4400

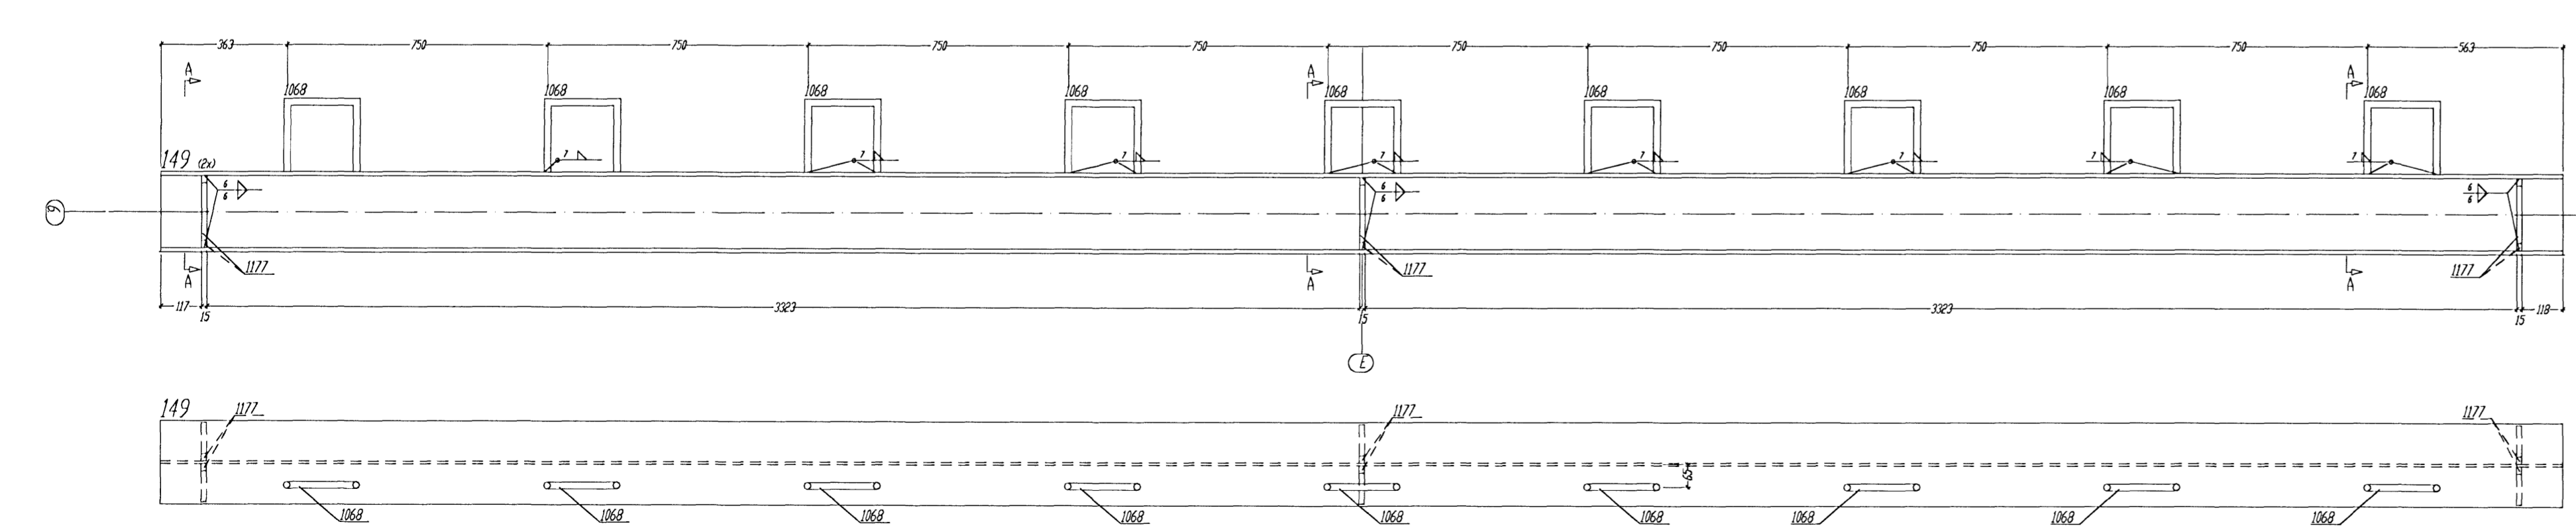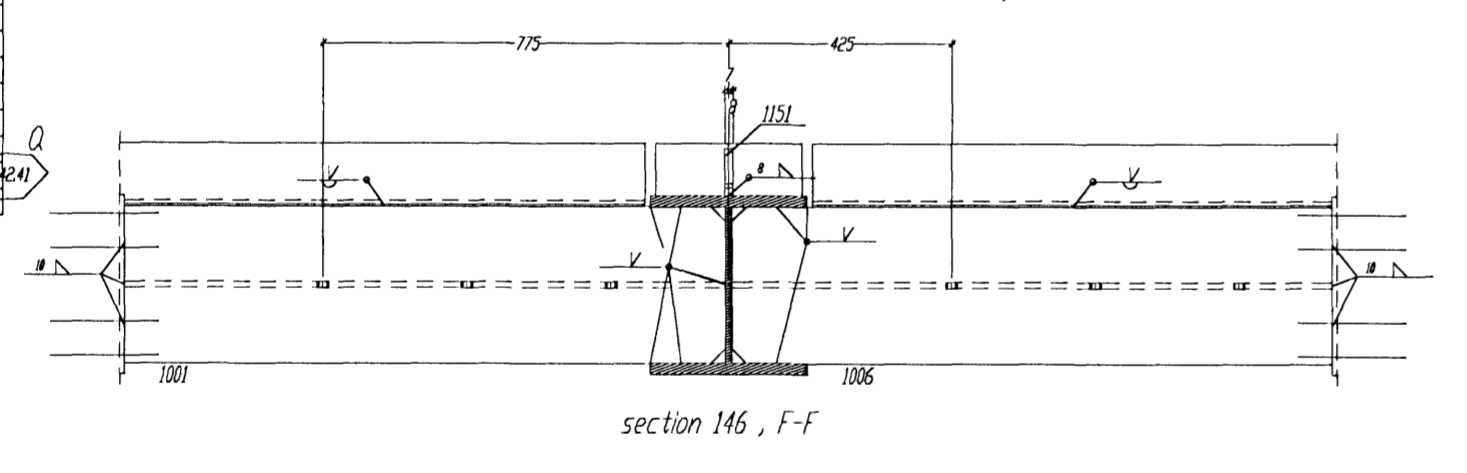

of material for 1 Dip: POS. 149 total 2 X done

| Nr | Pos | designation | qty | profil | quality | length | weight | dim |
|------------------|-------|-------------|-----|--------|---------|--------|--------|-----|

Shipping dimensions 01 x B x L3 400 x 200 x 688

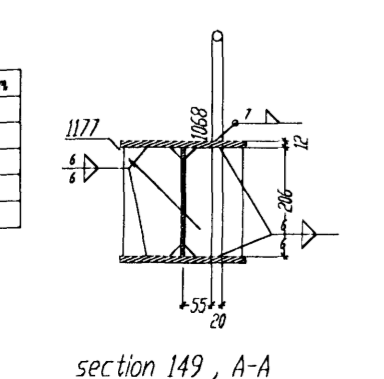

Fyrir hönd Conis ehf, kt. 600105-1400
staðfestist að teikning þessi hefur verið
yfirlit. Teikningin er í samræmi við
Íslenska staðla og reglugerðir. 28/107

Conis
Nafn 130657-4413
Kennitala

Tolerance for welded constructions according to DIN 8570, Pt.1-3/BV.1087
Welding (W.P.S.) according to DIN EN 288 - 2

Required transverse forces and forced tension angles according to DIN 18800 Pt. 1, 0583



All unworked welds to be fillet continuous a=4mm thick, not greater than 0.7 d of the thinner element

The material for cap plates 20 mm thick to be examined for laminations

BIURO INZYNIERSKIE
Marek i Janina MUCHA
Osiny, ul. Opalska 30a, 46-070 Komprachcice tel.077-46 46 757

Pos. 146-149
T.JARNARVELLIR 11
Steel Office part
DRG 116 a