


18. FEB 2008

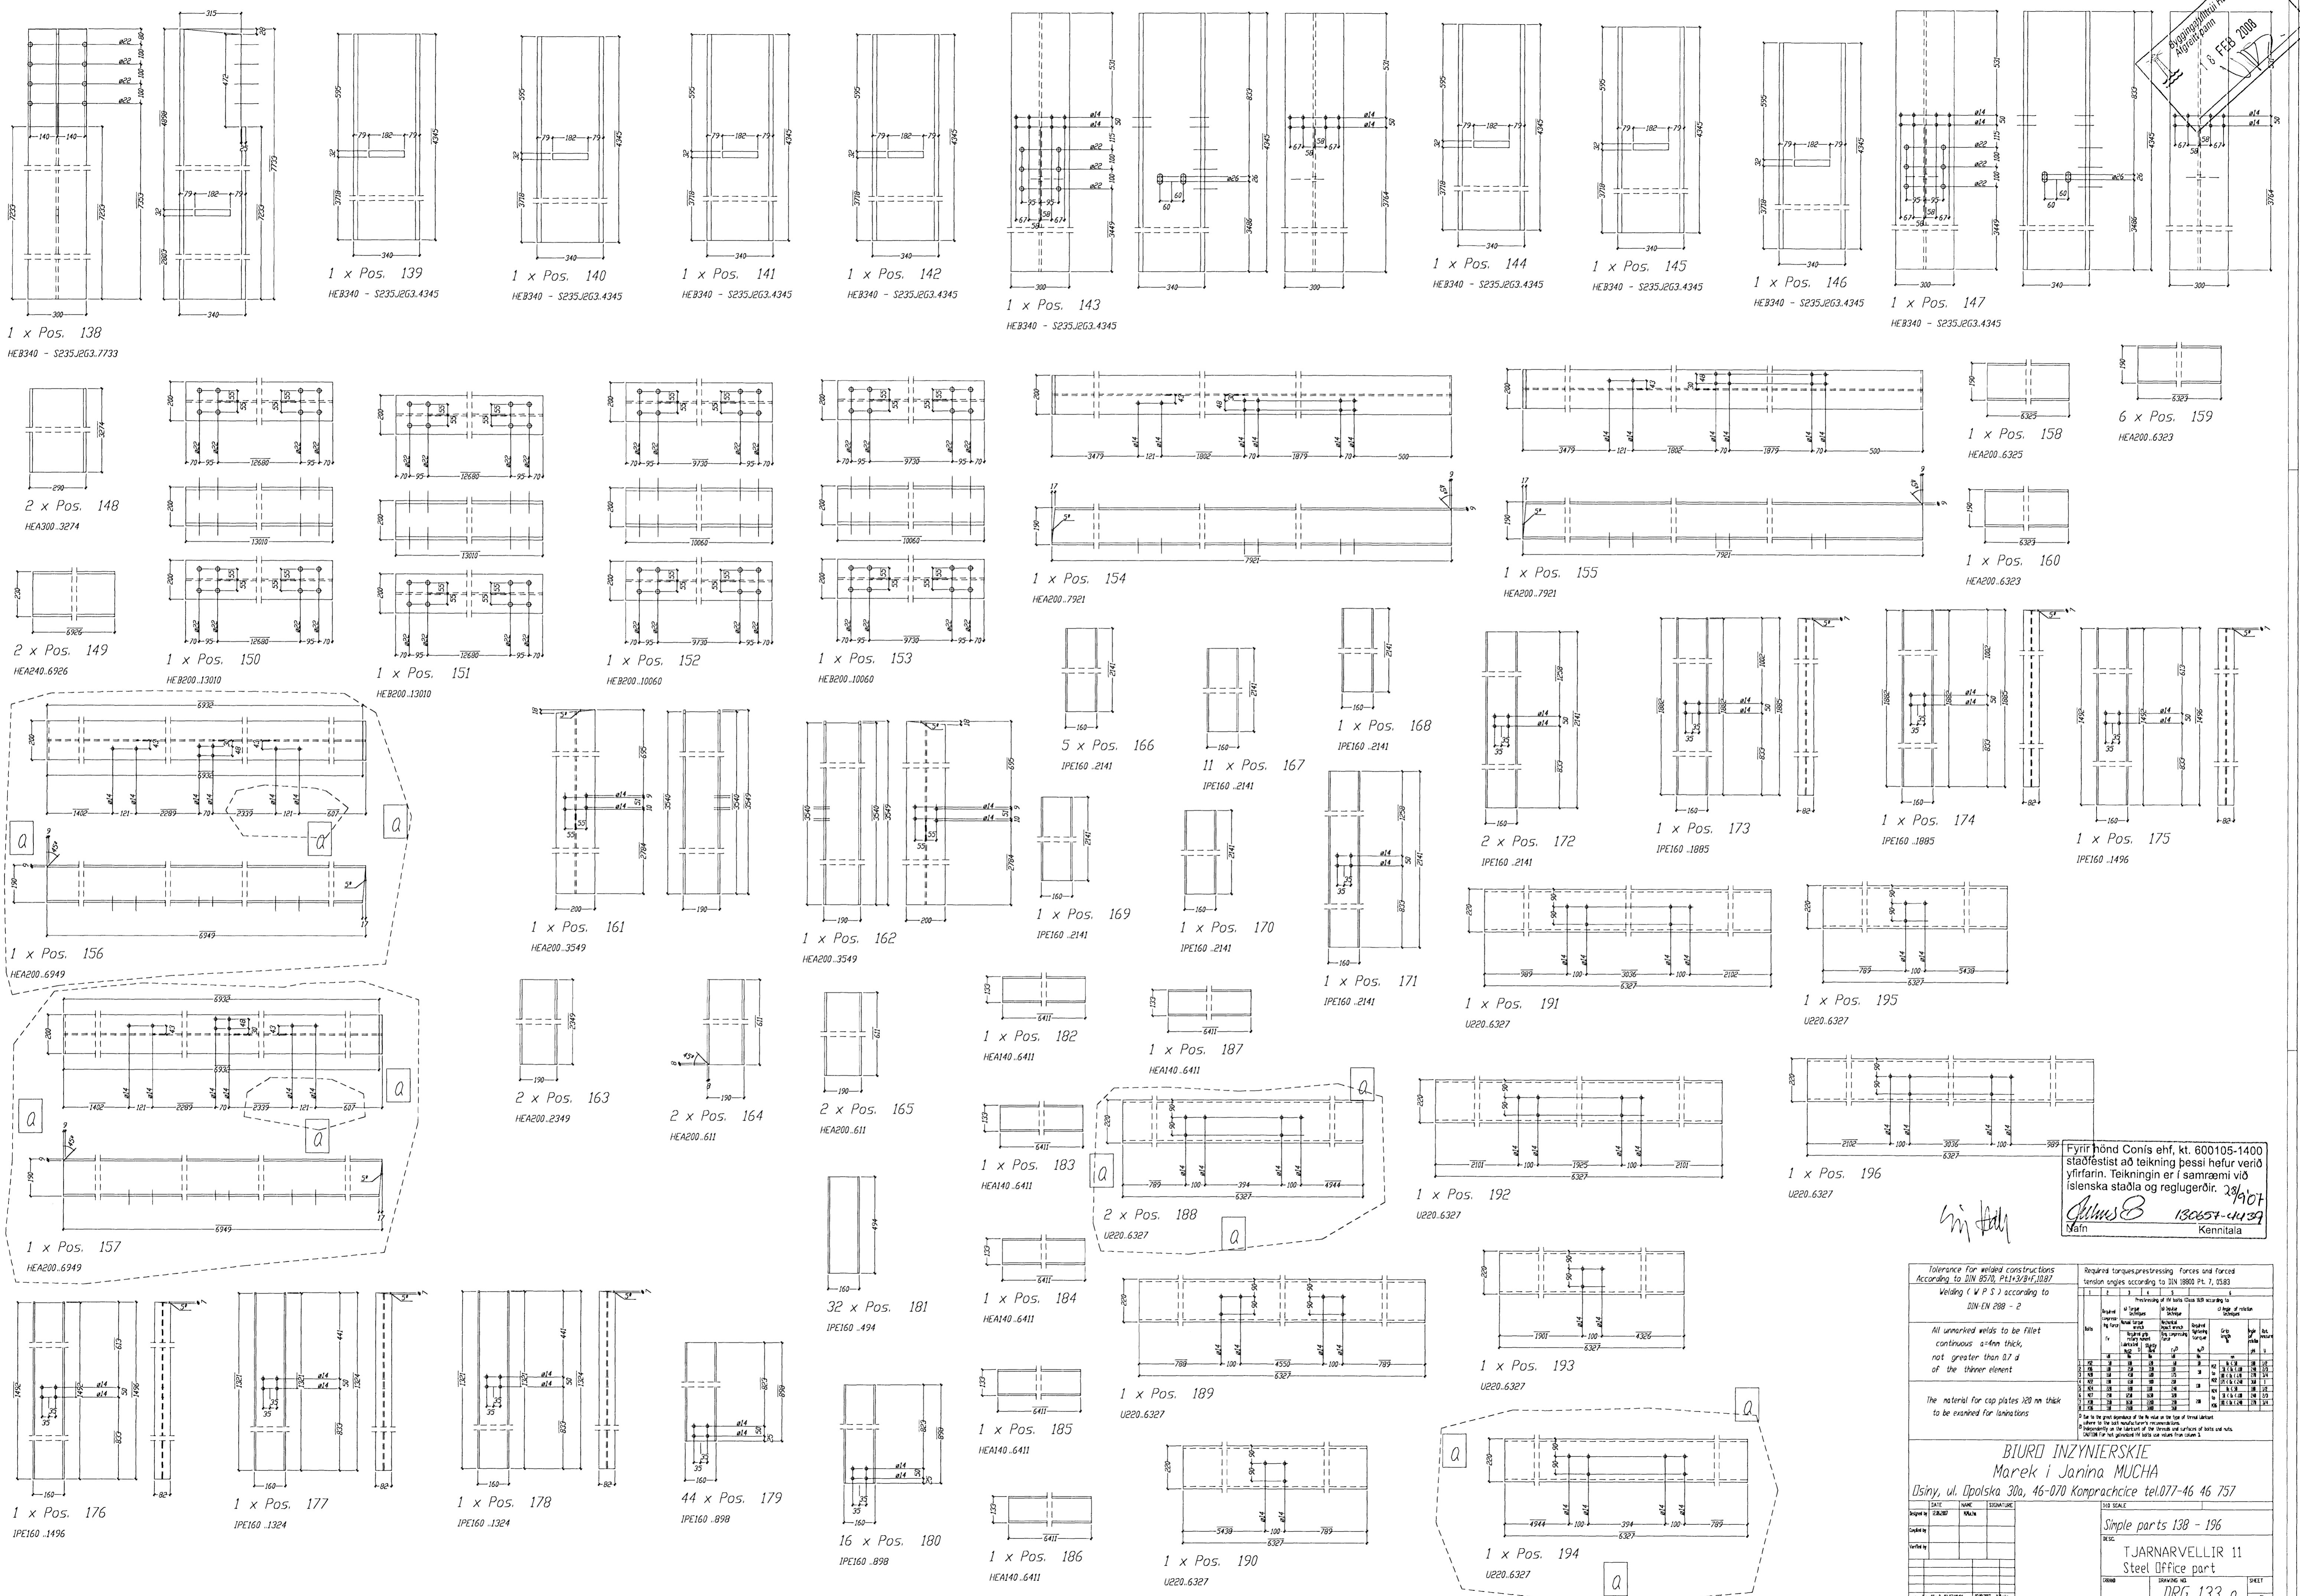

Fyrir hönd Conis ehf, kt. 600105-1400
staðfestist að teikning þessi hefur verið
yfirlit. Teikningin er í samræmi við
íslenska staðla og reglugerðir. 28/10/07
Mafn *[Signature]* 130657-41137
Kennitala

Tolerance for welded constructions According to DIN 9130, Pt1+3/3/1,1087		Required tensioning forces and forced tension angles according to DIN 18800 Pt. 7, 05/83																																	

All unmarked welds to be fillet continuous a=4mm thick, not greater than 0,2 d of the thicker element																																			
The material for cap plates 120 mm thick to be examined for laminations																																			
<p>BIURO INZYNIERSKIE Marek i Janina MUCHA Dłyna, ul. Dłowska 30a, 46-070 Komprachcice tel.077-46 46 757</p>																																			
Drawn by: <i>[Signature]</i> Checked by: <i>[Signature]</i> Date:		Drawing no.: Simple parts 138 - 196 TJARNARVELLIR 11 Steel Office part DRG 133 a																																	