
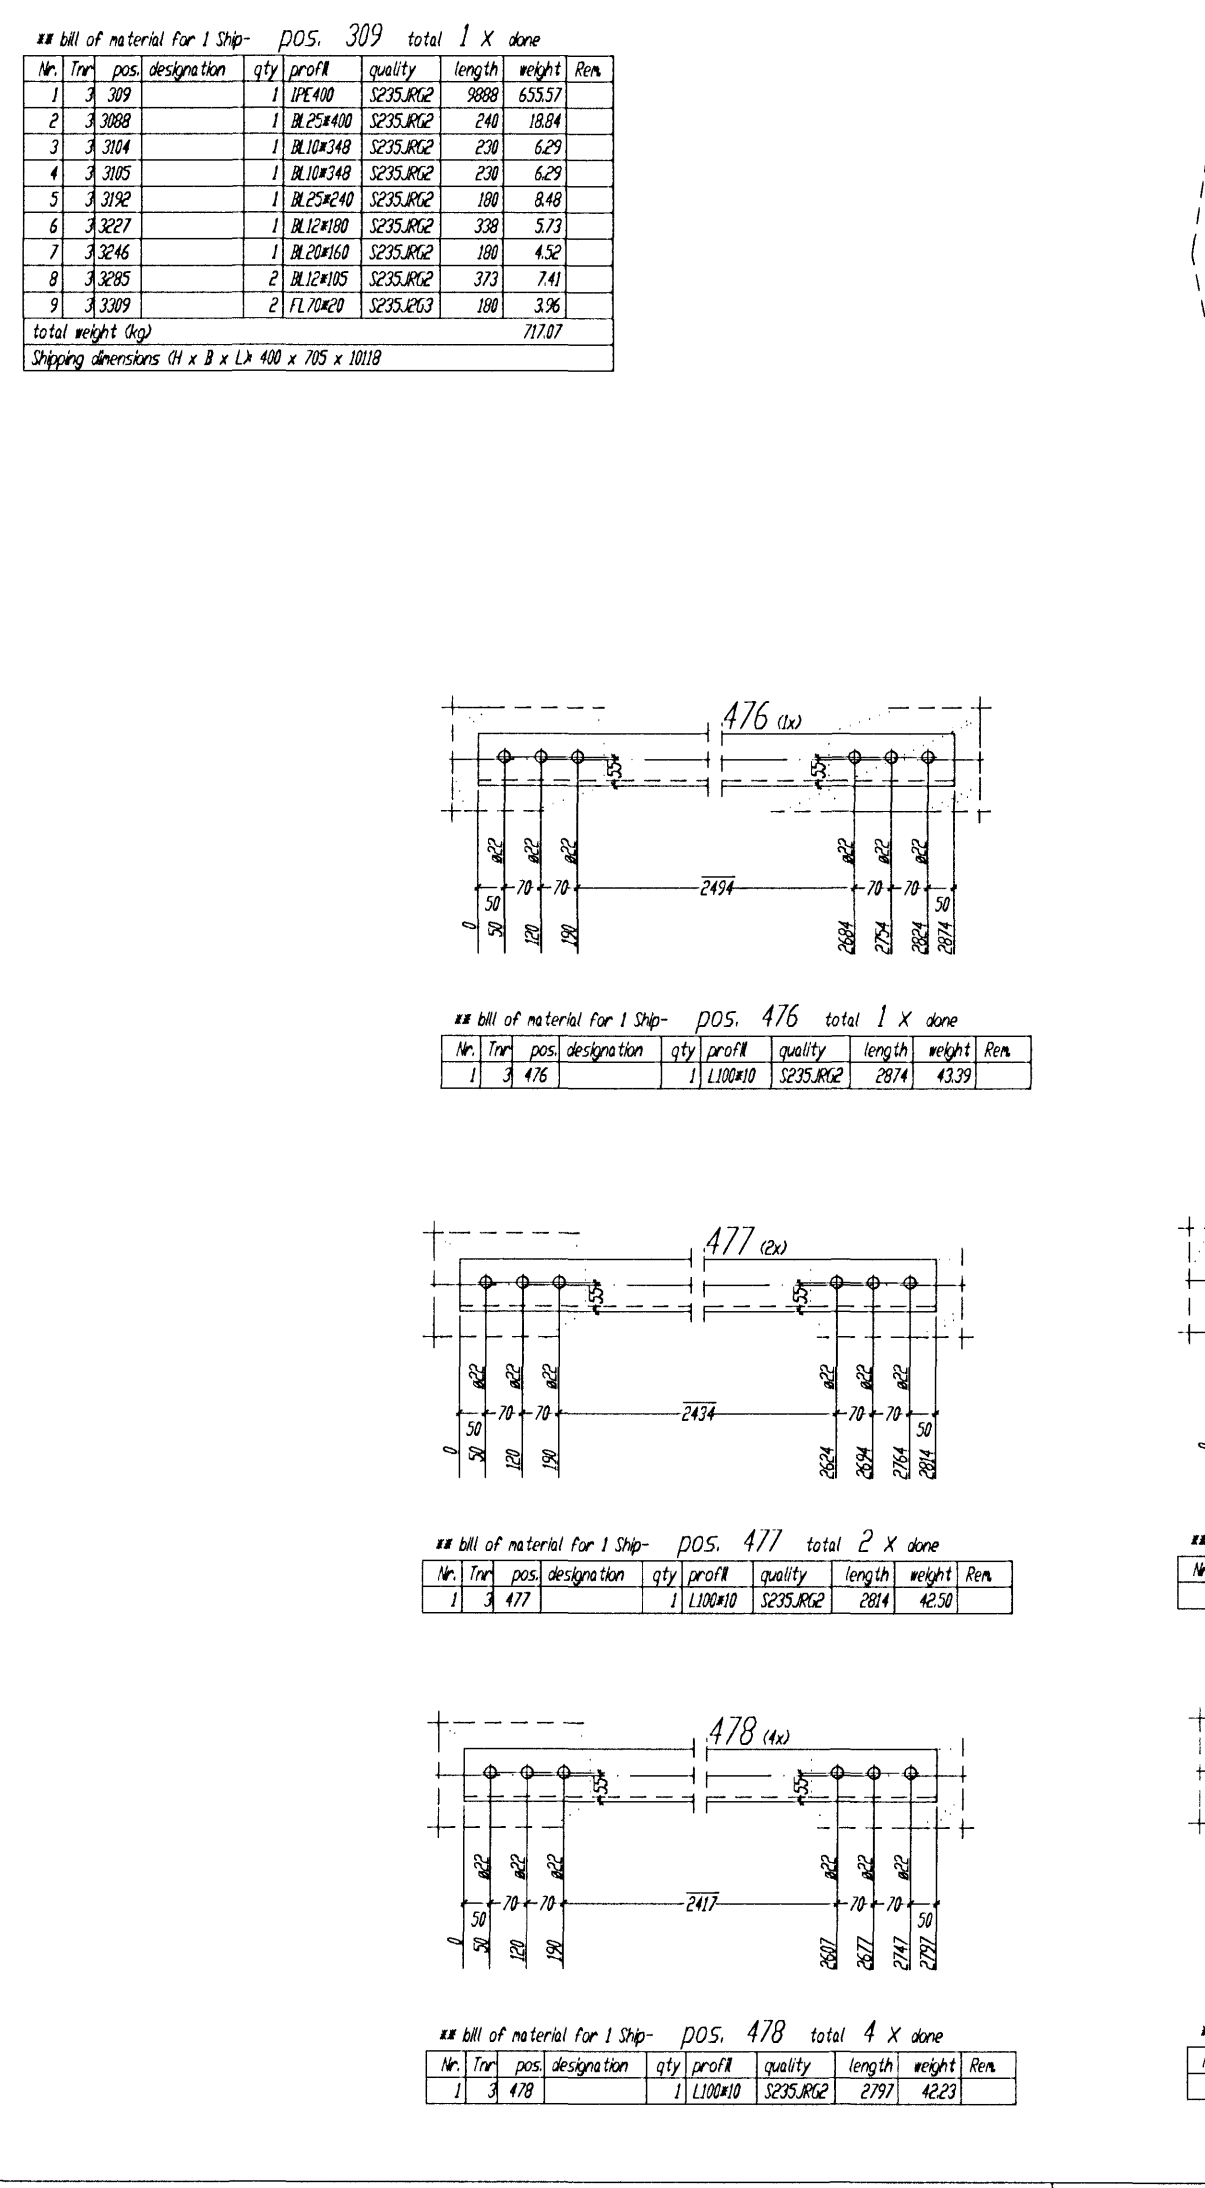
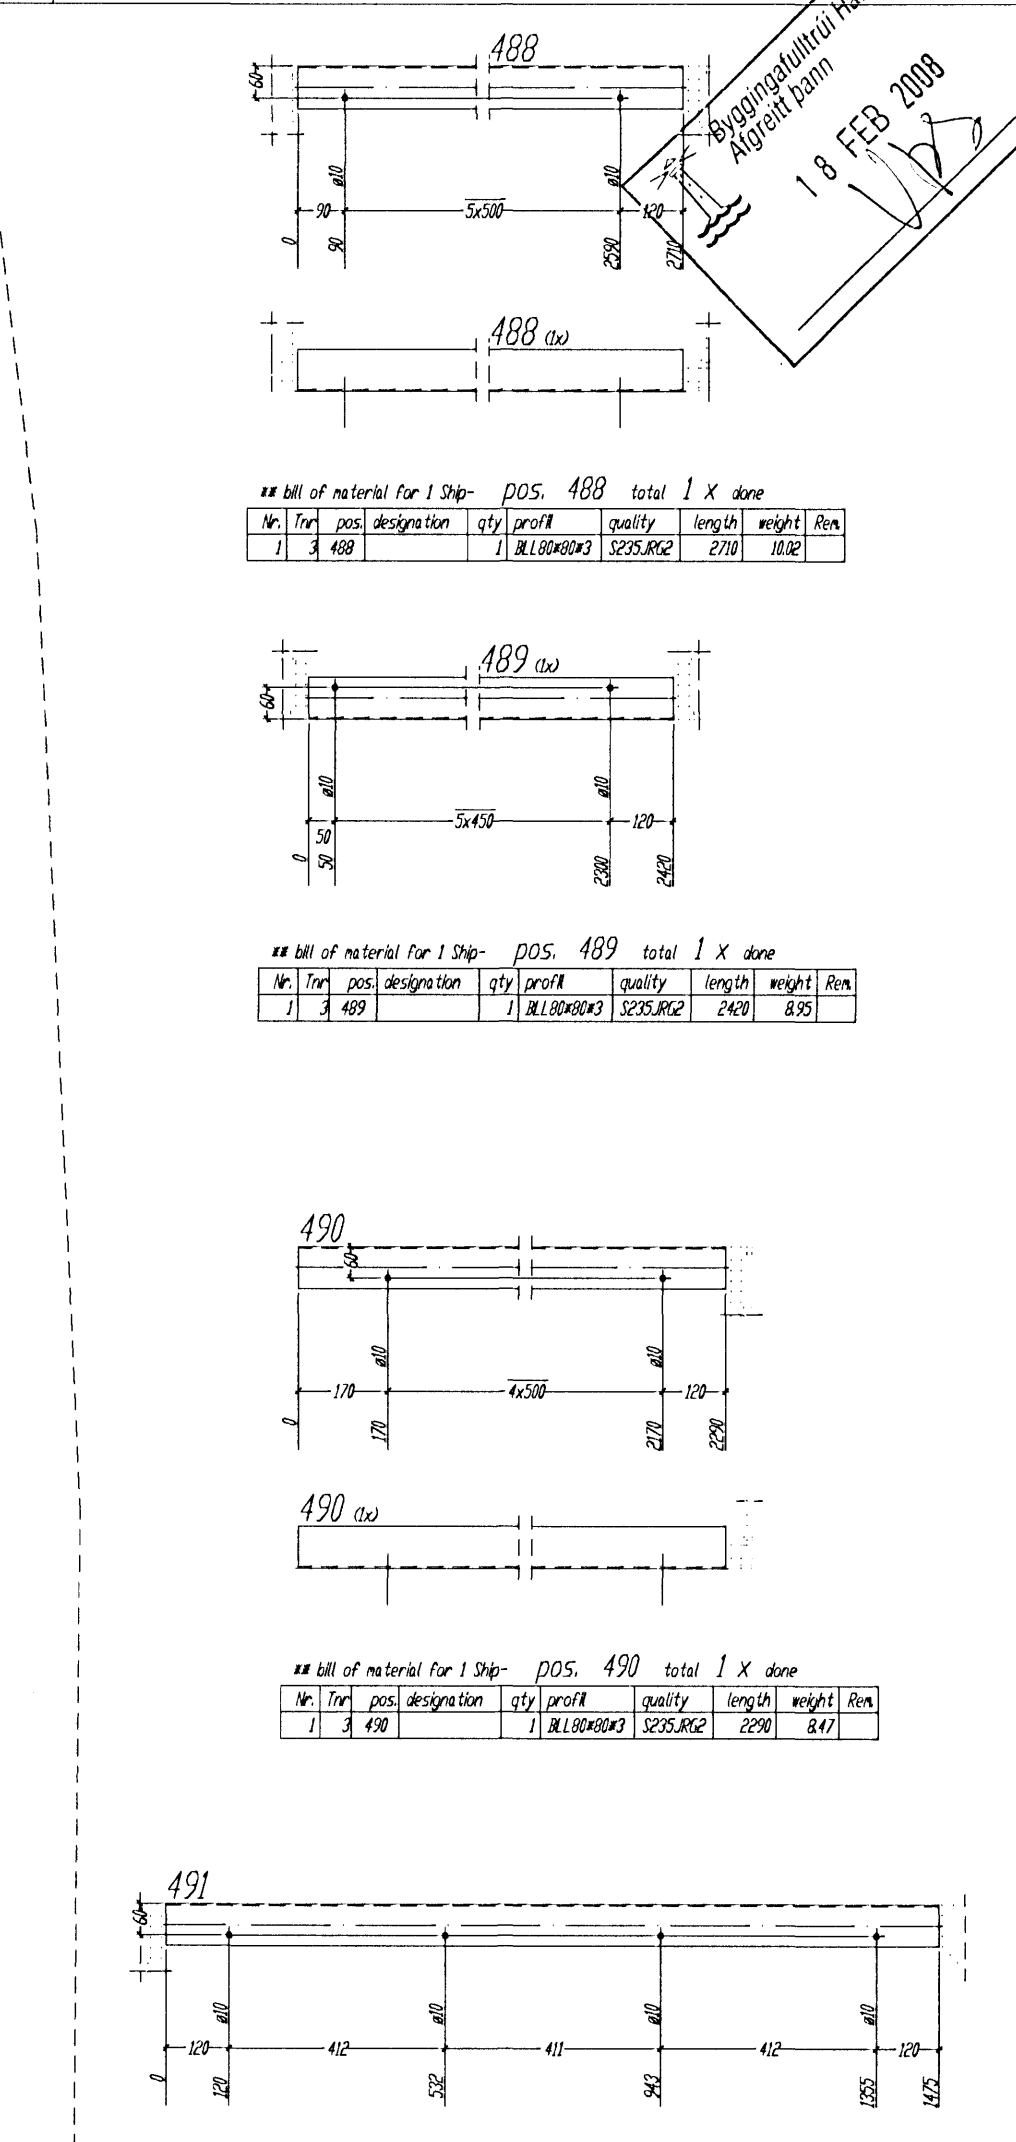
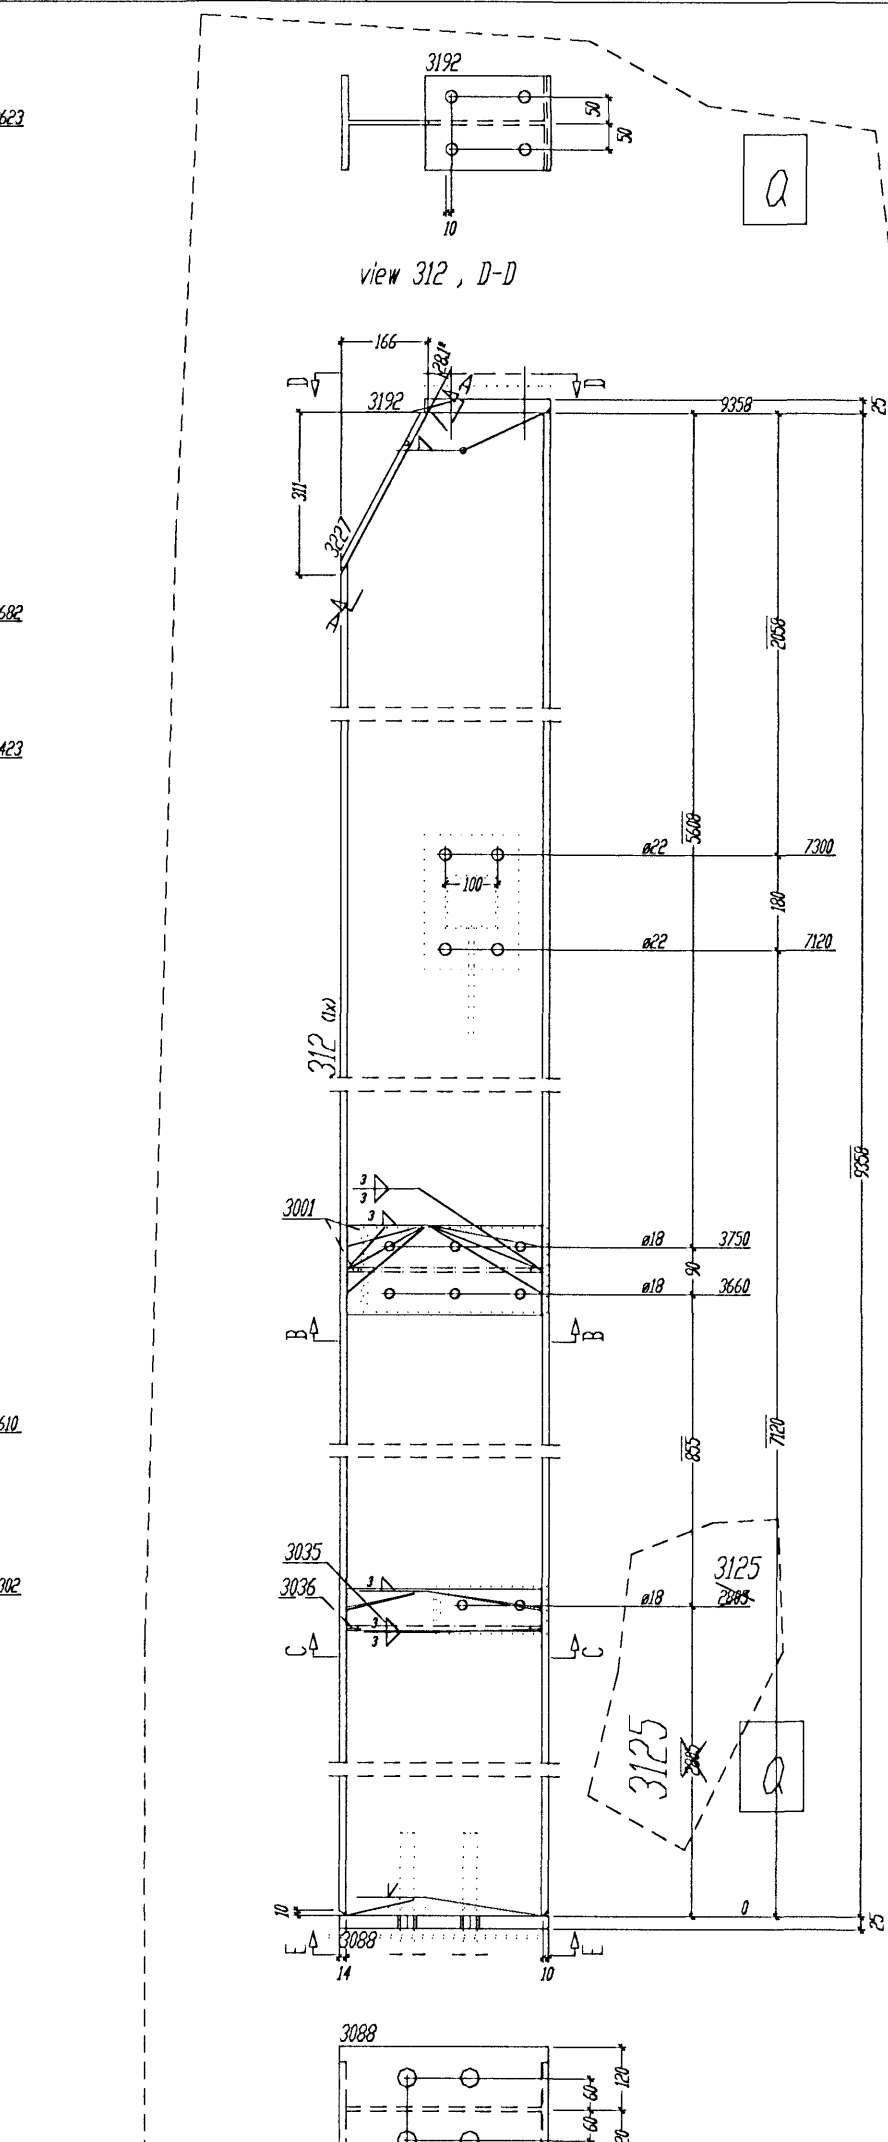
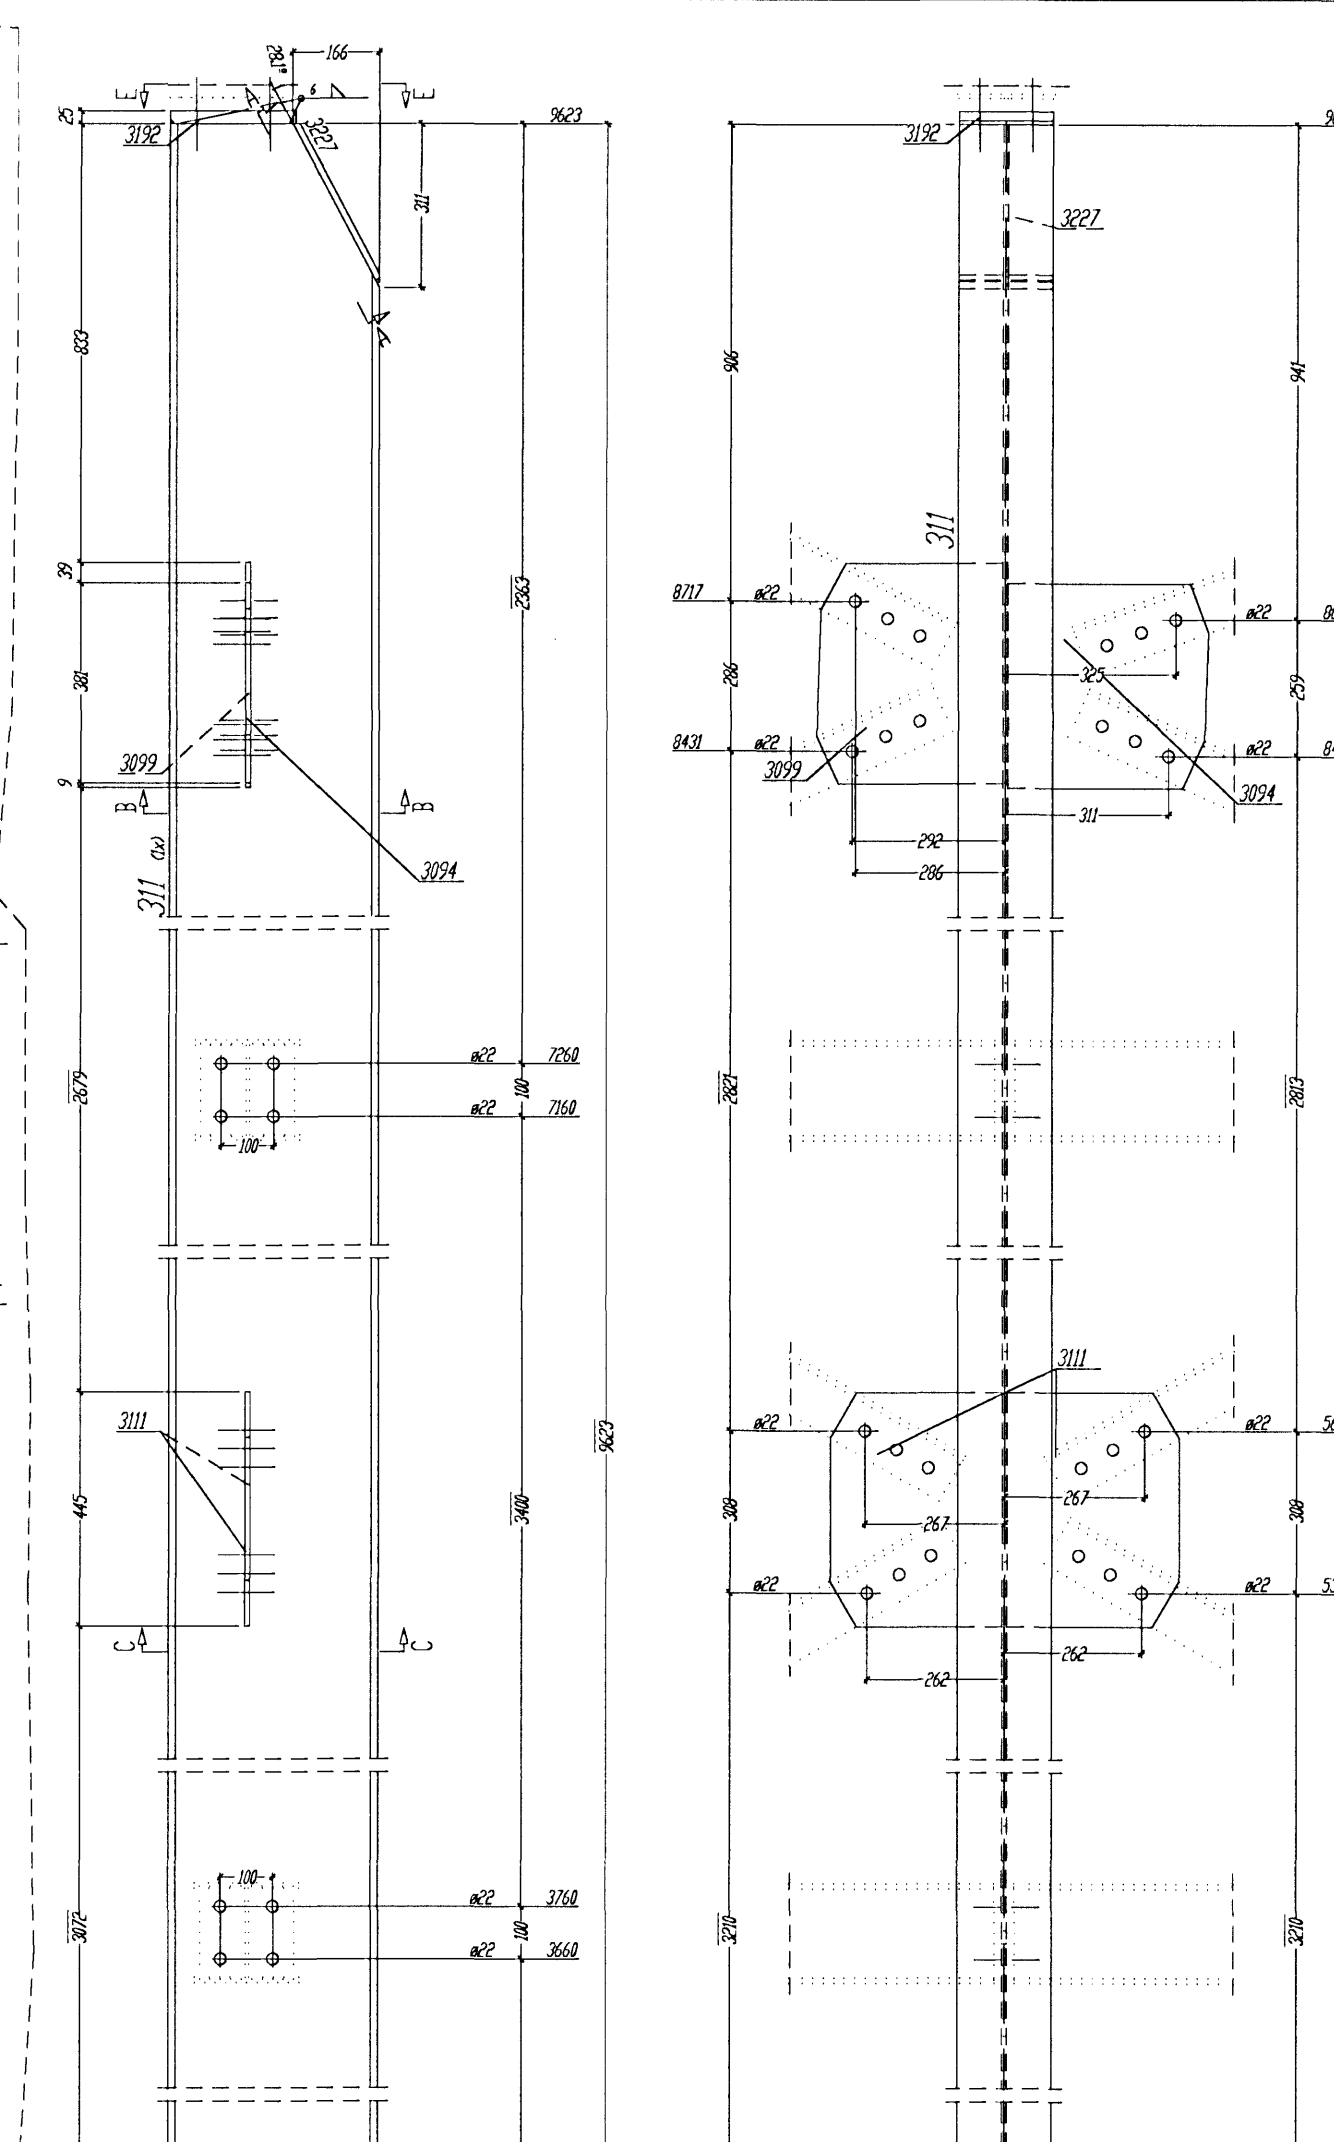
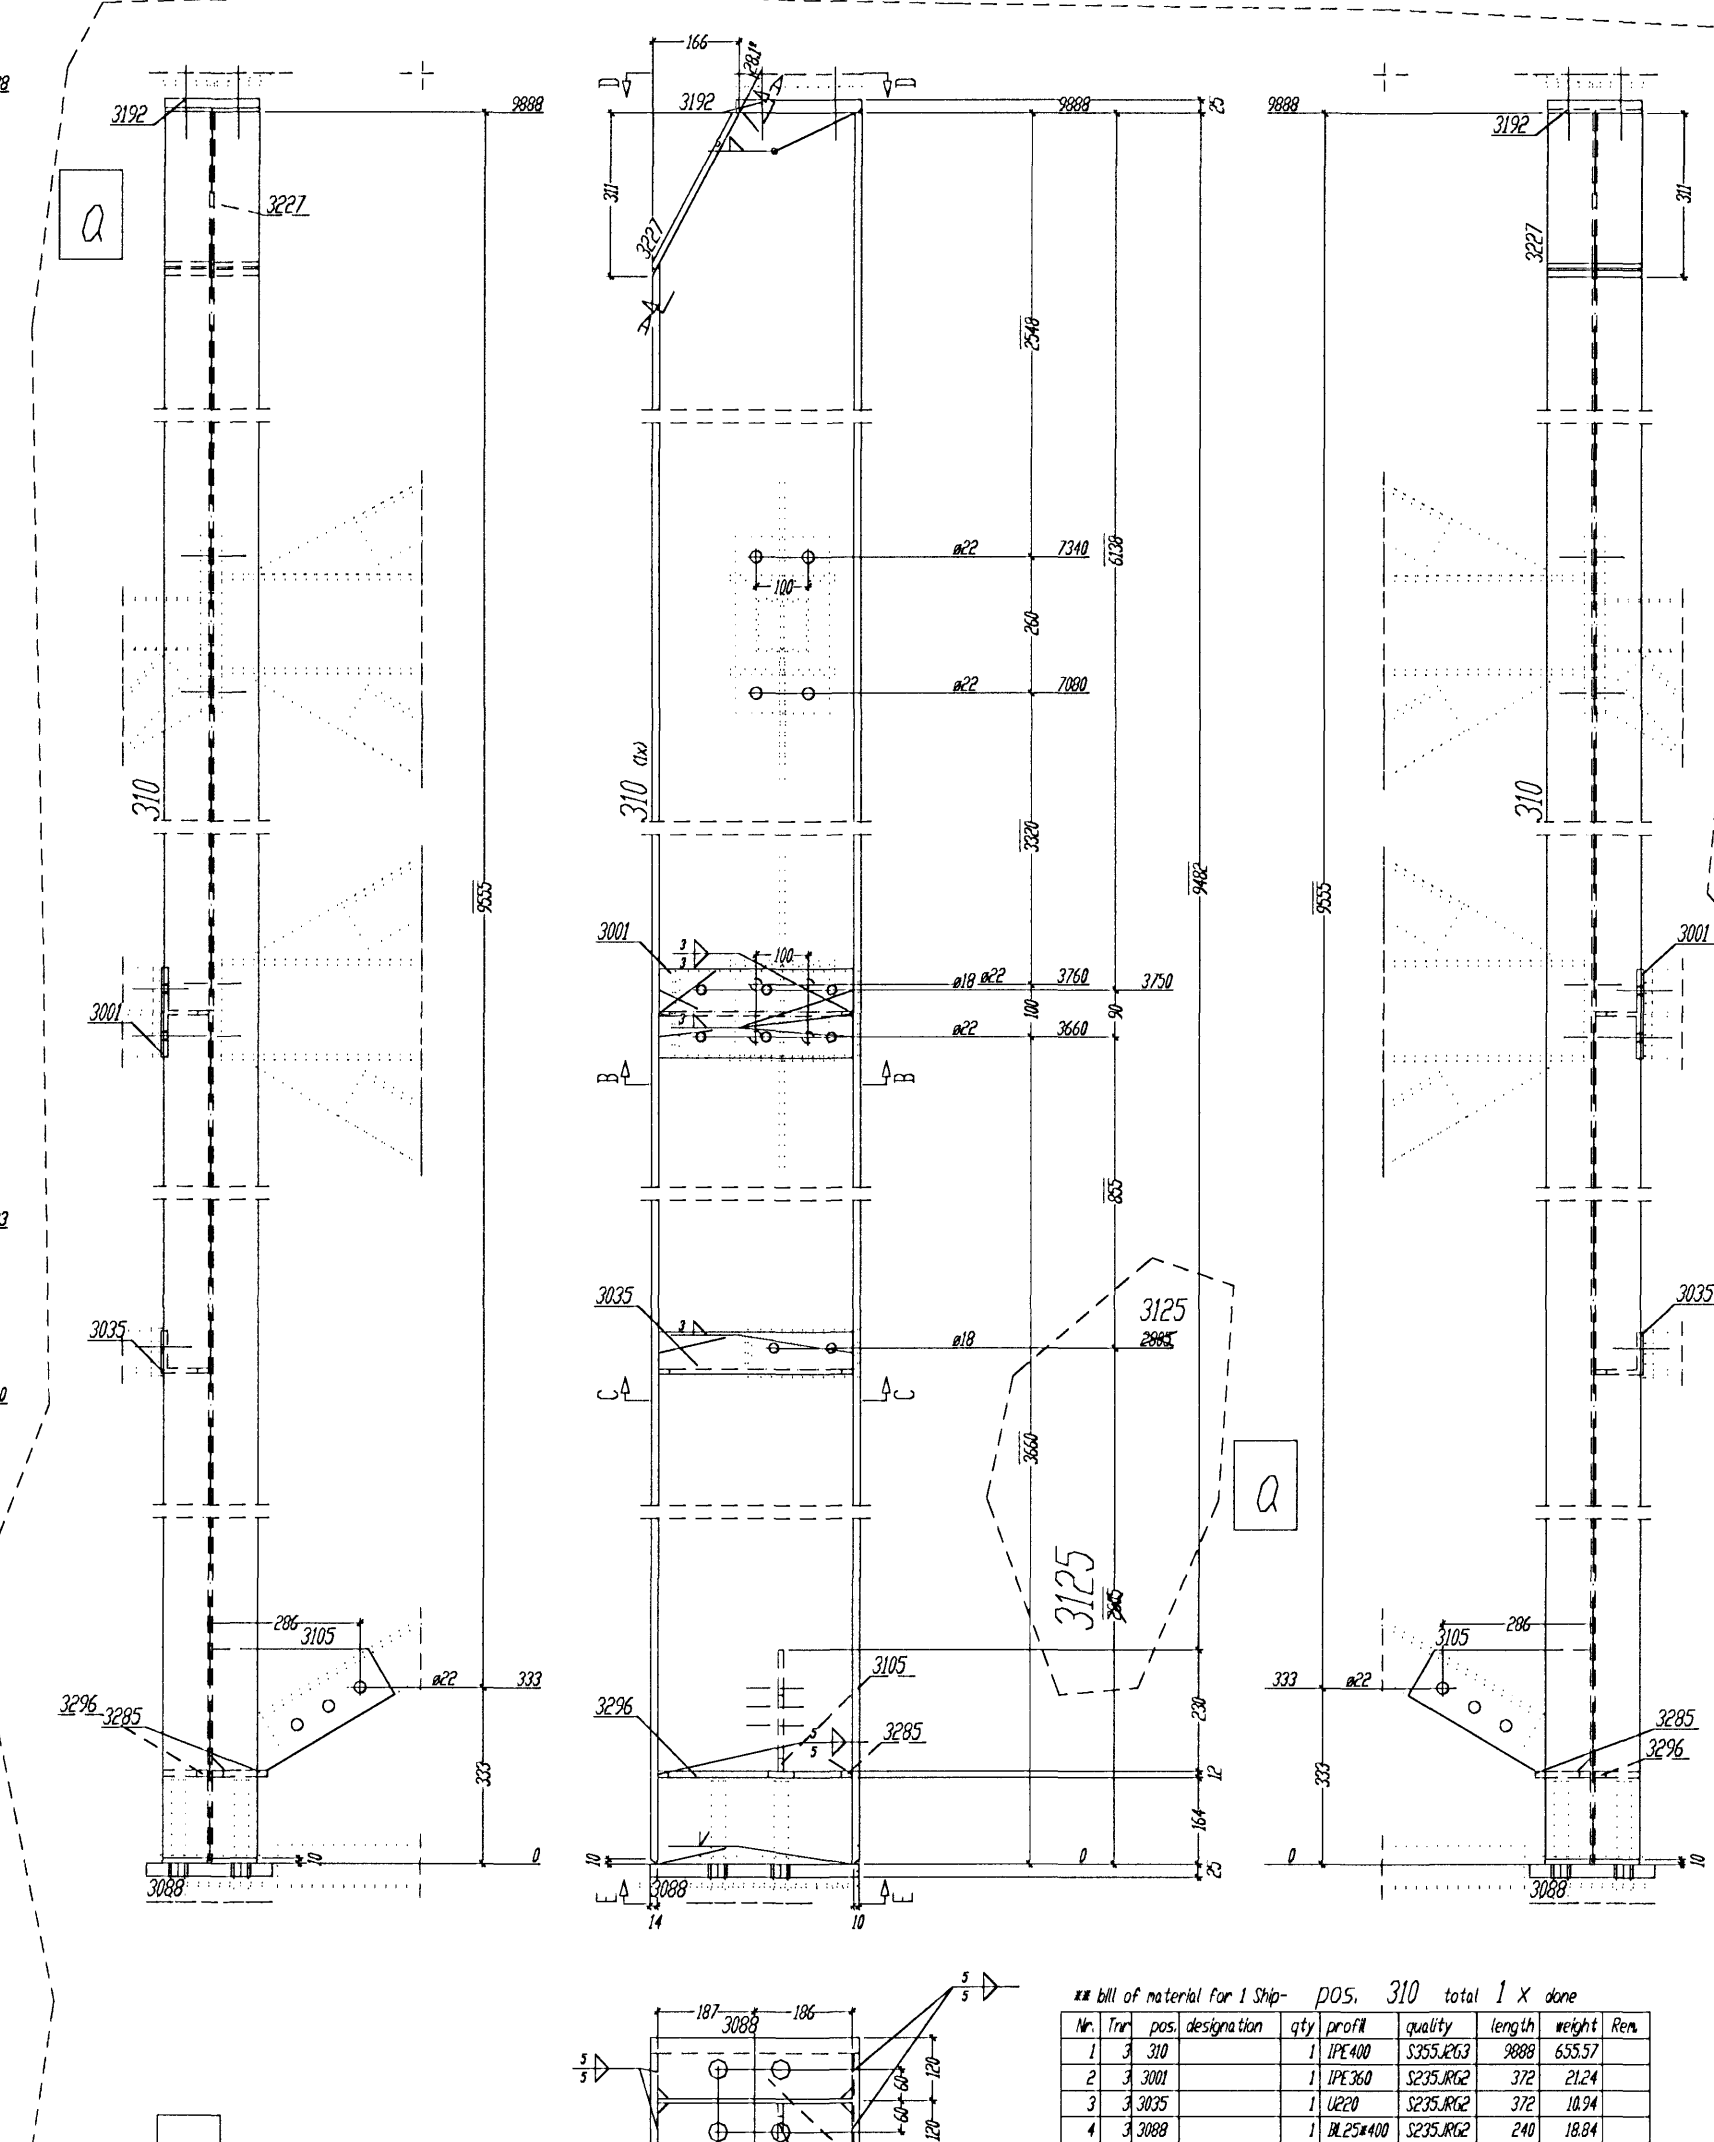


18 FEB 2008

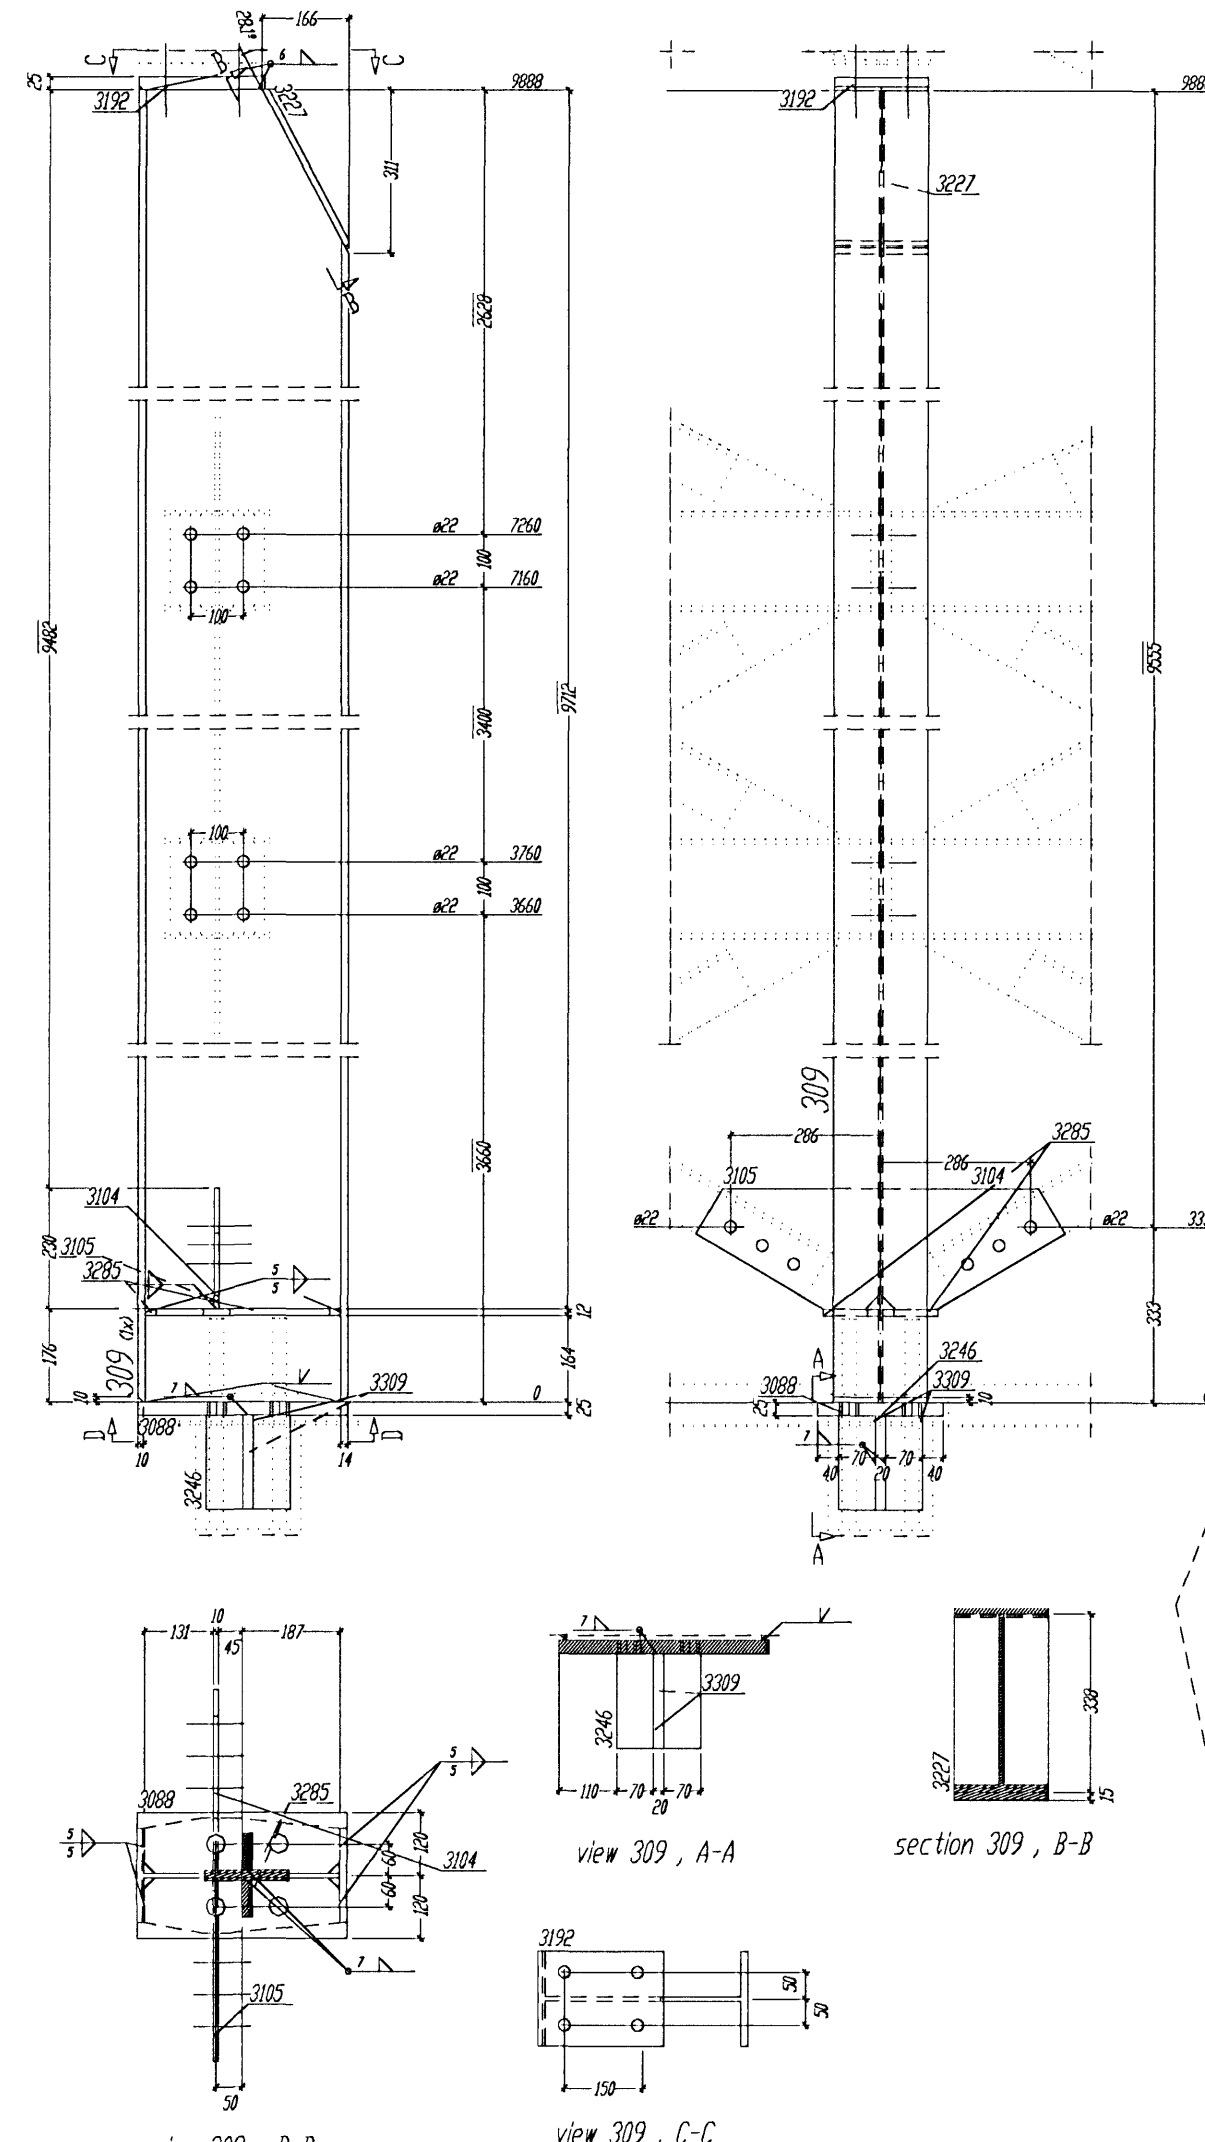

Fyrir hönd Conis ehf. kt. 600105-1400  
staðfestist að teikning þess hefur verið  
yfirlit. Teikningin er í samræmi við  
viðenska staðla og reglugerðir. 29/10/07  
Jónas B. 130655-4139  
Kennitala

Tolerance for welded constructions  
According to DIN 8203, Pt.1+2/3/4/10/82  
Welding (WPS) according to  
DIN-EN 288 - 2

All unmarked welds to be fillet  
continuous across thick,  
not greater than 0,7 d  
of the thinner element

The material for cap plates 120 mm thick  
to be examined for laminations

Required torquing/prestressing forces and forced  
tension angles according to DIN 10805 Pt. 7, 25/89

Proficiency of PW tests shall be according to  
DIN EN 288 - 2


Proficiency of the test of the thread and surface of bolts and nuts  
shall be according to DIN EN 1090 Pt. 1, 10/10

BIURO INZYNIERSKIE  
Marek i Janina MUCHA  
Dłyna, ul. Opolska 30a, 46-070 Komprachcice tel.077-46 46 757

Pos.309-312, 476-493

TJARNARVELLIR 11  
Steel Storage house

DRG 204 a