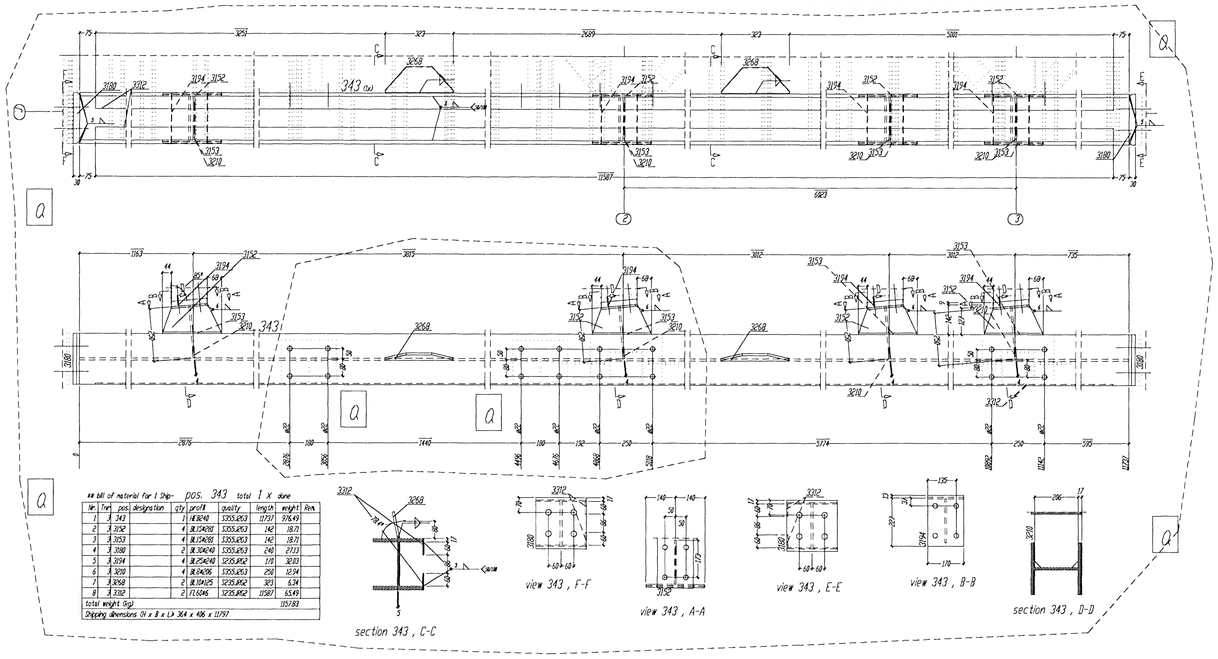

** bill of material for 1 Ship- pos. 343 total 1 X done

Nr.	Tnr	pos.	designation	qty	profil	quality	length	weight	Rem.
Shipping dimensions (H x B x L): 364 x 406 x 11797									

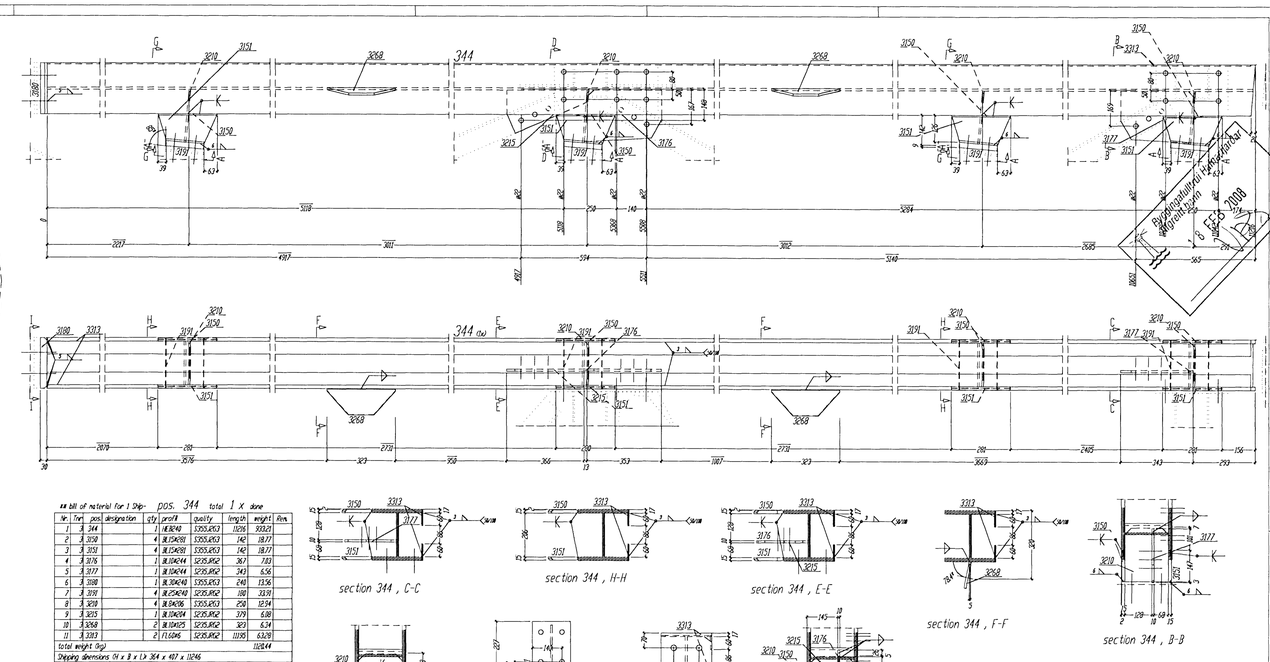

** bill of material for 1 Ship- pos. 344 total 1 X done

Nr.	Tnr	pos.	designation	qty	profil	quality	length	weight	Rem.

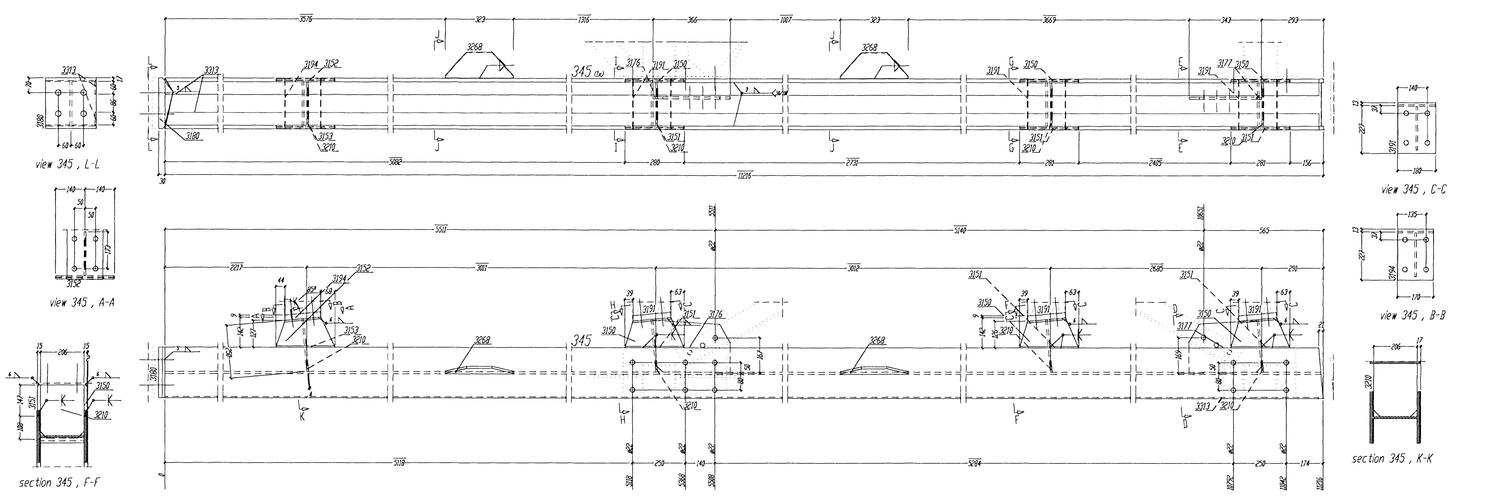

** bill of material for 1 Ship- pos. 345 total 1 X done

Nr.	Tnr	pos.	designation	qty	profil	quality	length	weight	Rem.
total weight (kg)								1113,87	
Shipping dimensions (H x B x L): 364 x 407 x 11746									

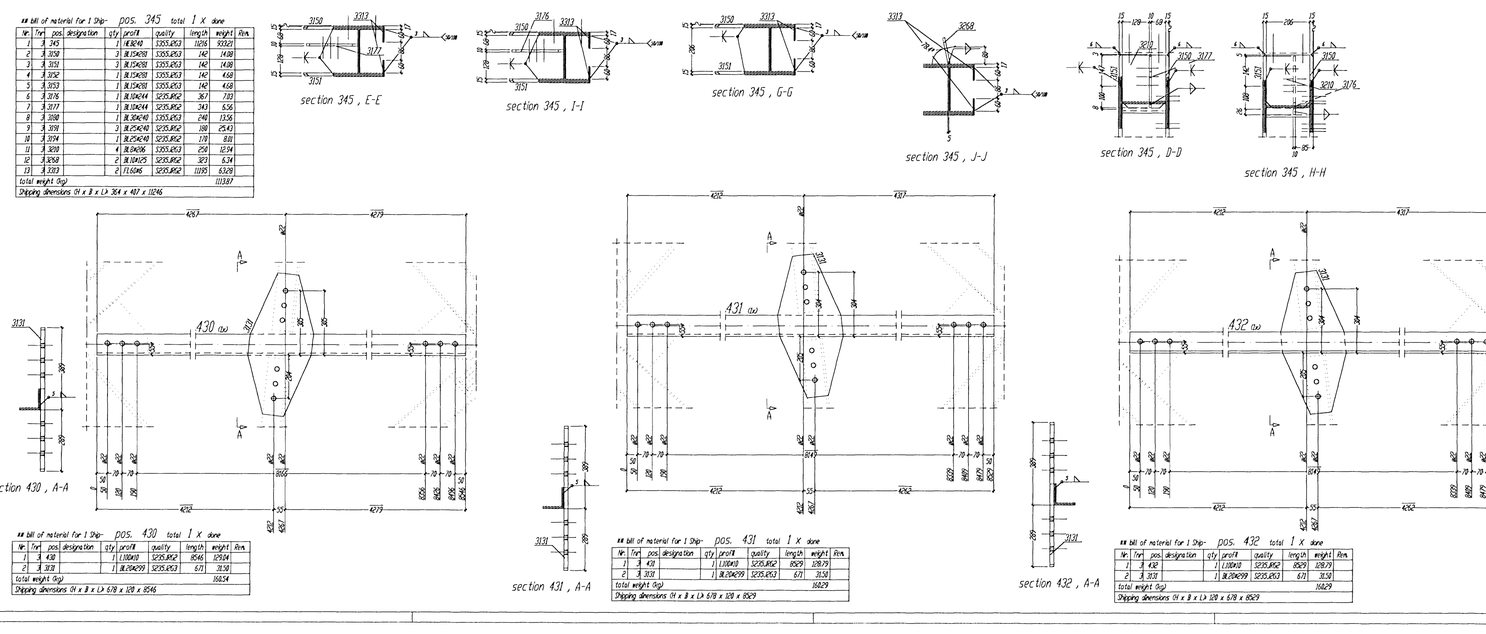

** bill of material for 1 Ship- pos. 430 total 1 X done

Nr.	Tnr	pos.	designation	qty	profil	quality	length	weight	Rem.
1		3430		1	L100X10	S235JR/J2	8546	129,14	

** bill of material for 1 Ship- pos. 431 total 1 X done

Nr.	Tnr	pos.	designation	qty	profil	quality	length	weight	Rem.
1		3431		1	L100X10	S235JR/J2	8529	128,79	

** bill of material for 1 Ship- pos. 432 total 1 X done

Nr.	Tnr	pos.	designation	qty	profil	quality	length	weight	Rem.
1		3432		1	L100X10	S235JR/J2	8529	128,79	

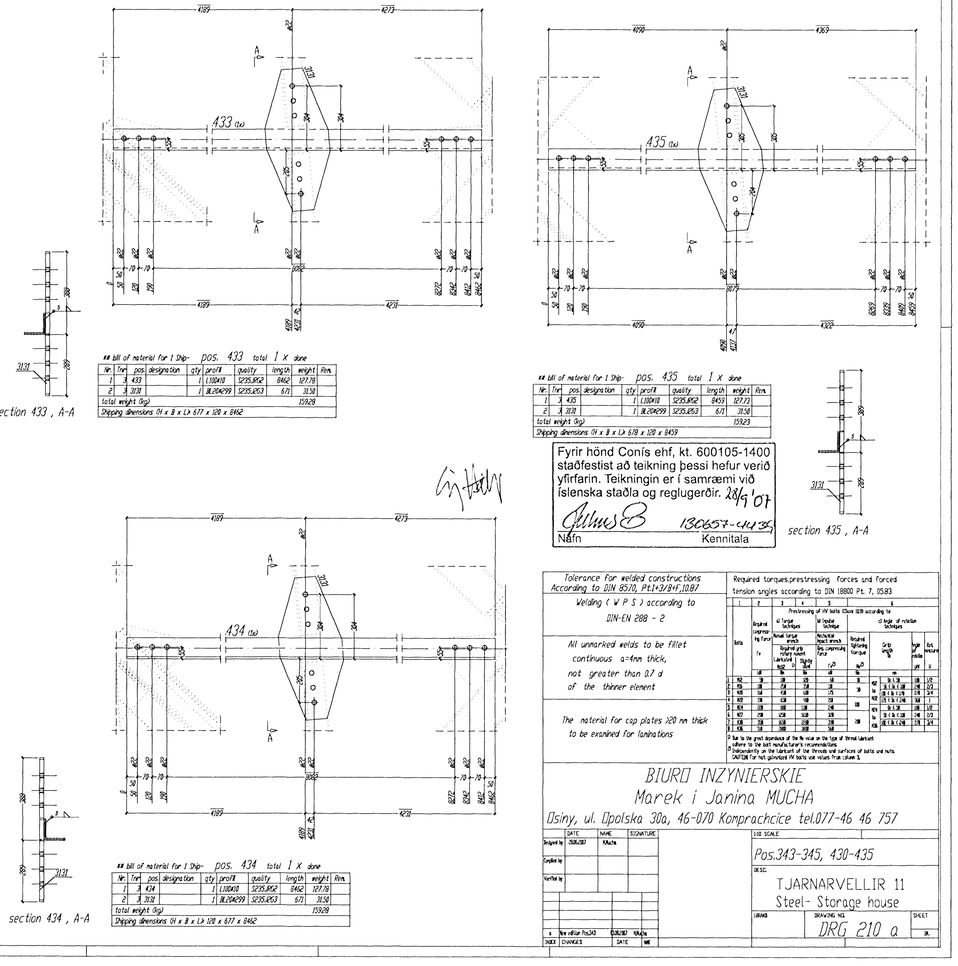

** bill of material for 1 Ship- pos. 433 total 1 X done

Nr.	Tnr	pos.	designation	qty	profil	quality	length	weight	Rem.
1		3433		1	L100X10	S235JR/J2	8462	127,78	

** bill of material for 1 Ship- pos. 435 total 1 X done

Nr.	Tnr	pos.	designation	qty	profil	quality	length	weight	Rem.
1		435		1	L100X10	S235JR/J2	8459	127,73	

** bill of material for 1 Ship- pos. 434 total 1 X done

Nr.	Tnr	pos.	designation	qty	profil	quality	length	weight	Rem.
1		434		1	L100X10	S235JR/J2	8462	127,78	

Fyrir hönd Conís ehf, kt. 600105-1400 staðfestist að teikning þessi hefur verið yfirfarin. Teikningin er í samræmi við íslenska staðla og reglugerðir. 28/9 '07

Nafn Kennitala 130657-4139

Tolerance for welded constructions
According to DIN 8570, Pt1+3/B+F, 10.87

Welding (W P S) according to DIN-EN 288 - 2

All unmarked welds to be fillet continuous a=4mm thick, not greater than 0.7 d of the thinner element

The material for cap plates ≥20 mm thick to be examined for laminations

Required torques/prestressing forces and forced tension angles according to DIN 18800 Pt. 7, 05.83


Due to the great dependence of the fit value on the type of thread lubricant, adhere to the bolt manufacturer's recommendations.
Independently on the lubricant of the threads and surfaces of bolts and nuts.
CAUTION for hot galvanized HV bolts use values from column 3.

BIURO INŻYNIERSKIE
Marek i Janina MUCHA
Olsiny, ul. Opolska 30a, 46-070 Komprachcice tel.077-46 46 757

	DATE	NAME	SIGNATURE
Designed by	28.09.2007	M.Mucha	
Checked by			
Verified by			

No.	Revision No./Date	Drawn	Checked

INDEX CHANGES DATE ME

1:50 SCALE

Pos.343-345, 430-435

DESIG.

TJARNARVELLIR 11
Steel- Storage house

DRAWING NO. DRG 210 a

SHEET 01