



Byggingarfræðingur  
16 FEB 2008

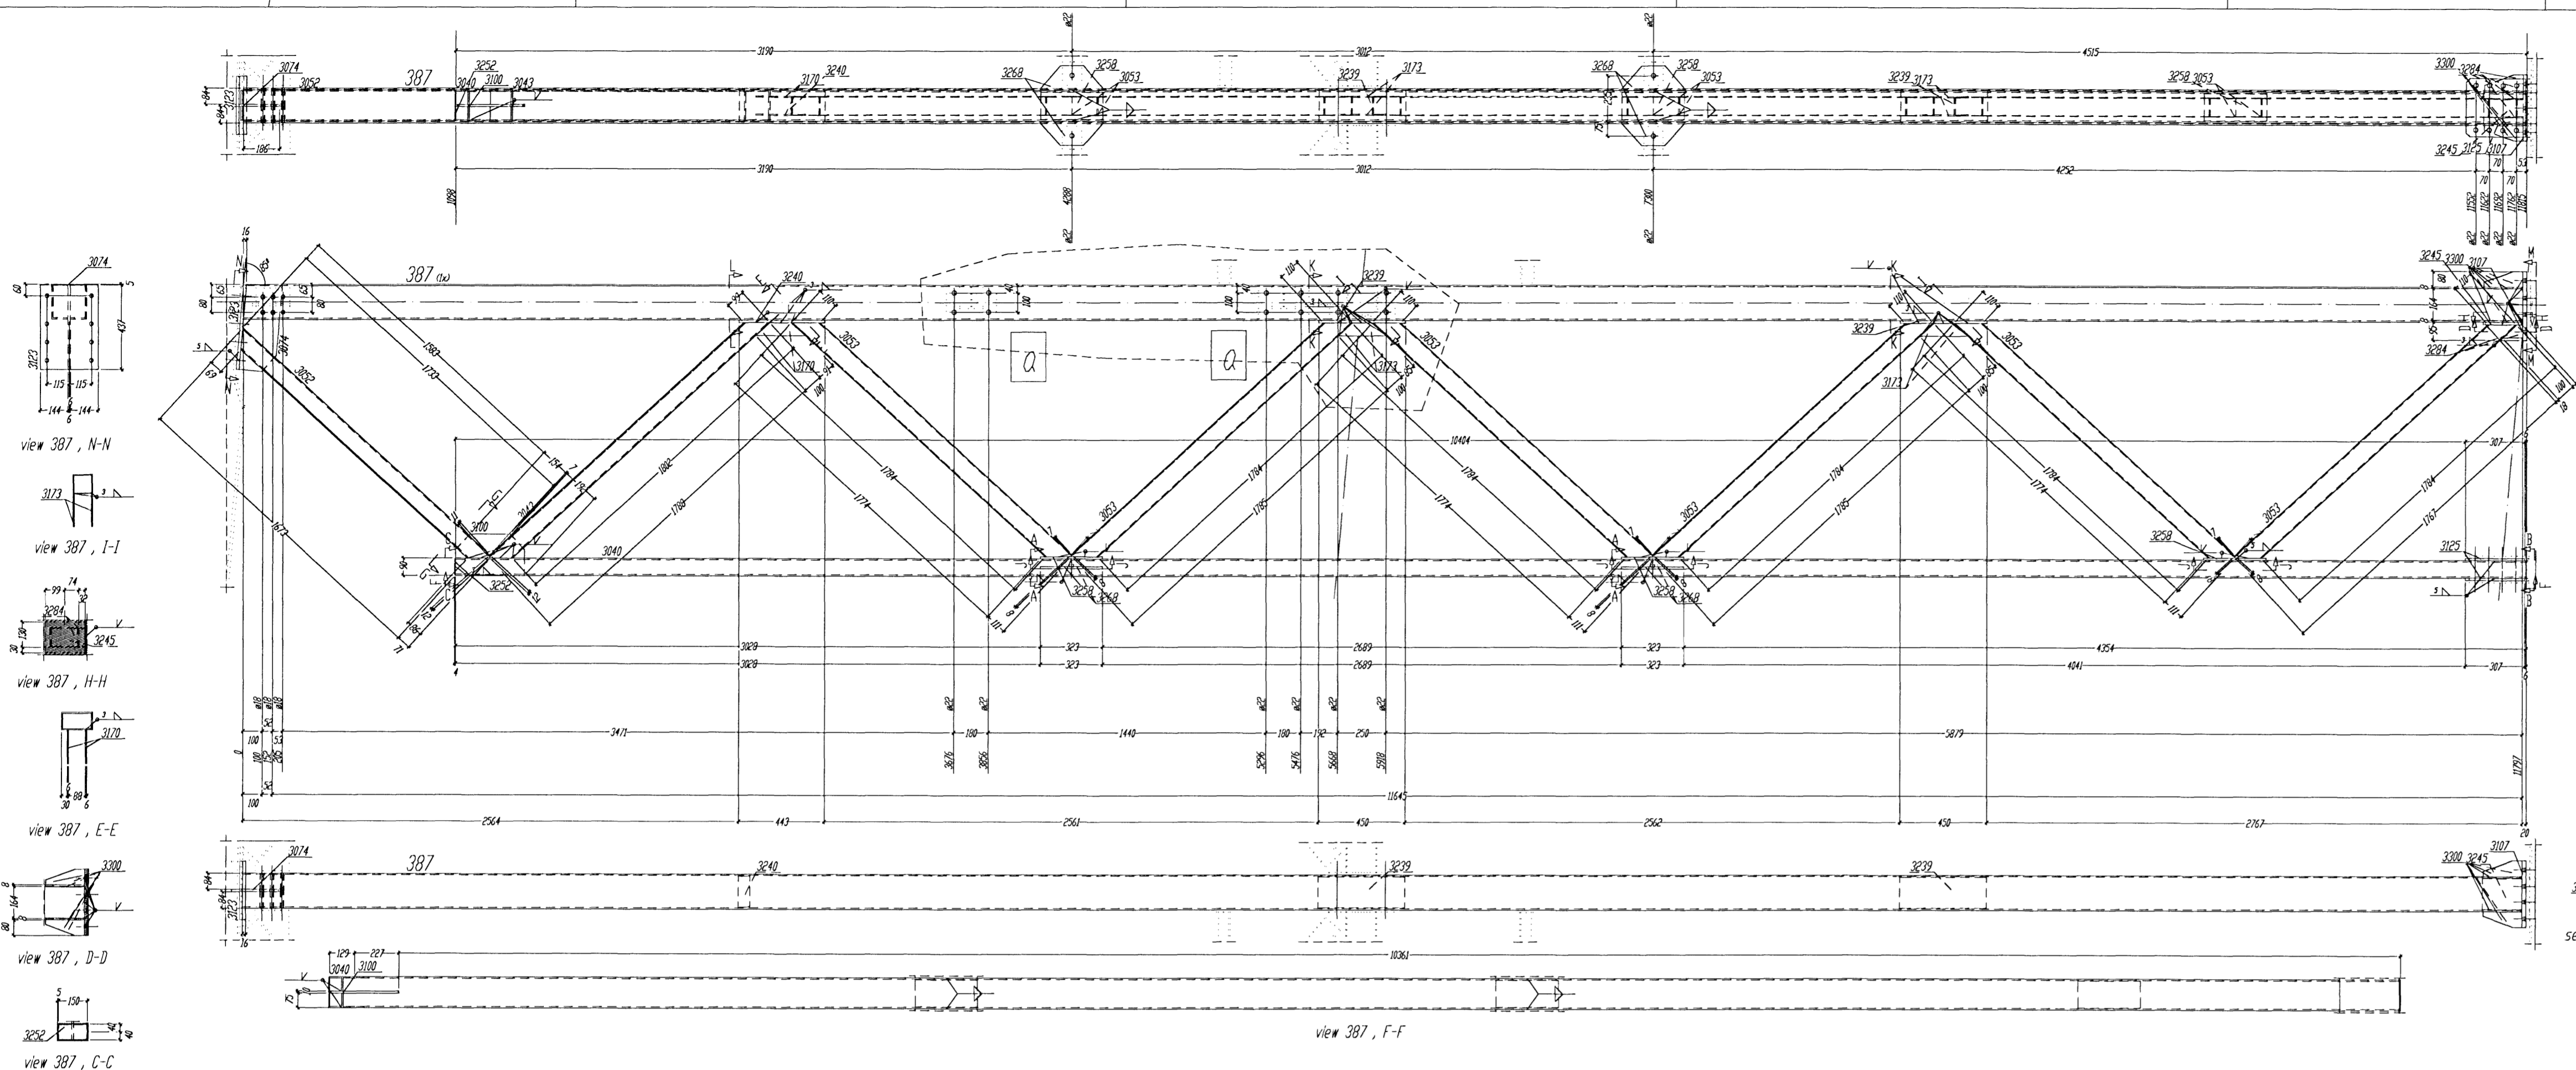

## Bill of material for 1 Shop - DOS: 387 total 1 K above

Qty	Pos.	Designation	Qty	Profile	Quantity	Length	Weight	Item
Total weight (kg)							1088,4	
Shipping dimensions (L x B x H) LA 1252 x 410 x 11855								

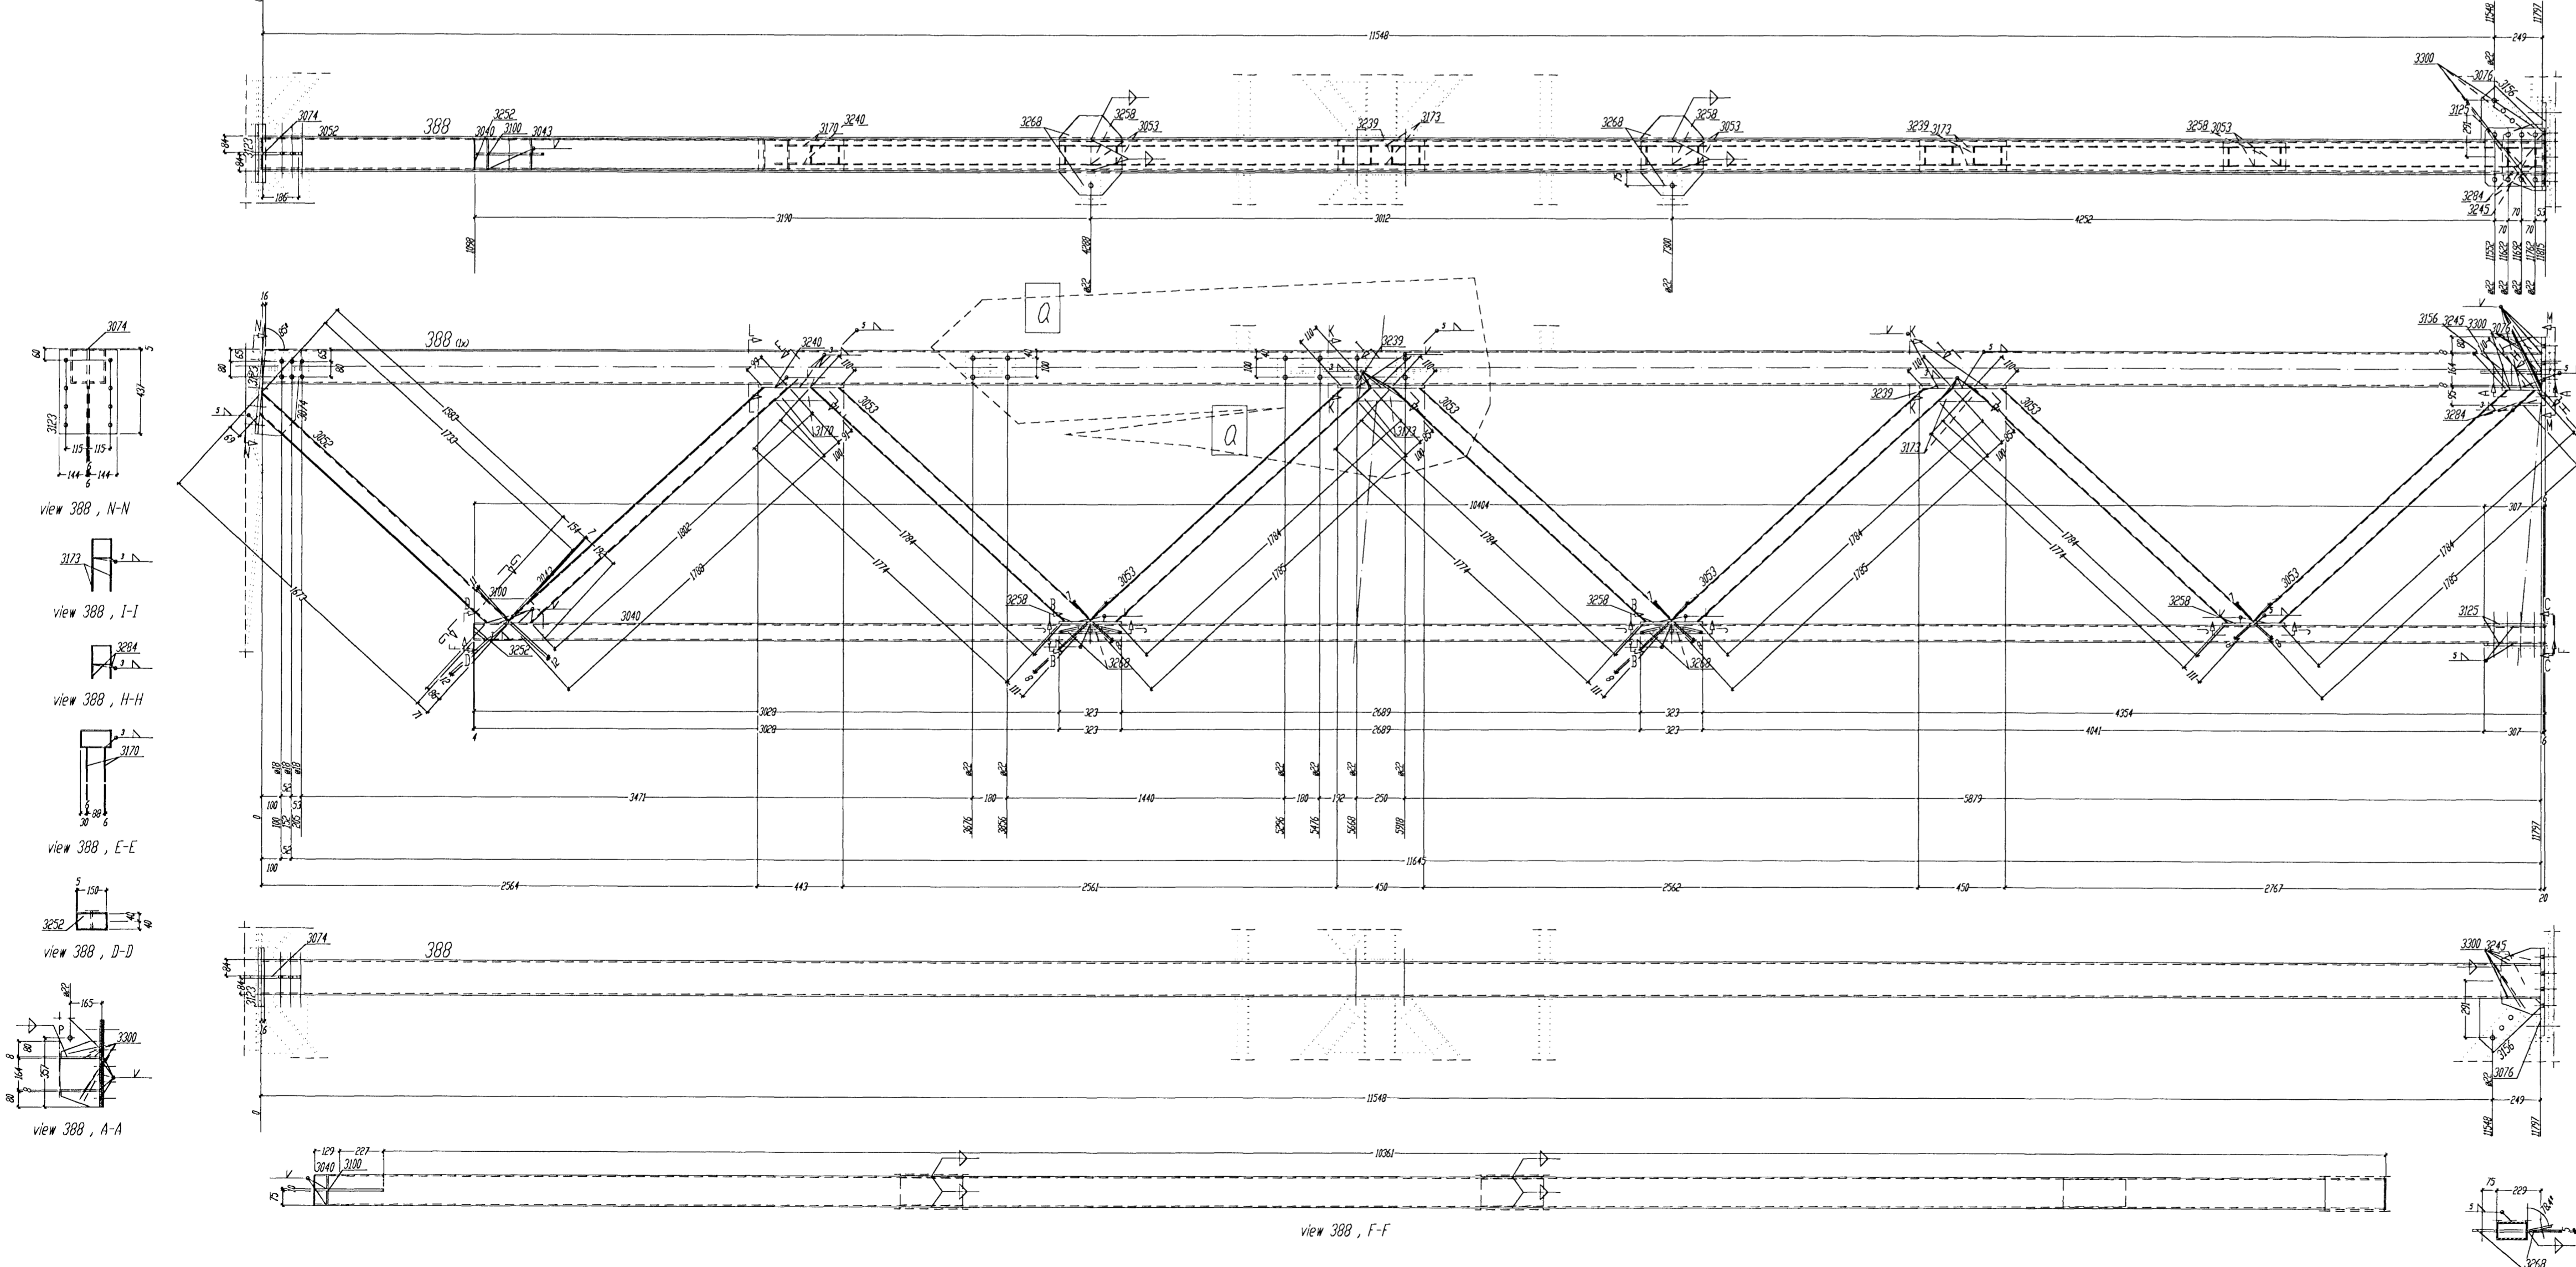

## Bill of material for 1 Shop - DOS: 388 total 1 K above

Qty	Pos.	Designation	Qty	Profile	Quantity	Length	Weight	Item
Total weight (kg)							1193,2	
Shipping dimensions (L x B x H) LA 1252 x 510 x 11855								

Fyrir hönd Conis ehf. kt. 600105-1400  
staðfestast að teikning þessi hefur verið  
yfirlit. Teikningin er í samræmi við  
Ístenska stöðla og reglugerðir: 28/9/07  
Gulmús 130657-41139  
Nafn Kennitala

Smiley

Tolerance for welded constructions  
According to DIN 9139, Pt.1-2/41:1987

Welding (W.P.S.) according to  
DIN-EN 288 - 2

All unmarked welds to be fillet  
continuous a=4mm thick,  
not greater than 0,7 d  
of the thinner element

The material for cap plates >20 mm thick  
to be evaluated for laminations

Required torsion-resisting forces and forced  
tension angles according to DIN 9880 Pt. 7, 05.83

Shape	Material	Designation	Quantity	Length	Weight	Item
1	2	3	4	5	6	7

BIURO INZYNIERSKIE  
Marek i Janina MUCHA  
Długość, ul. Opolska 30a, 46-070 Komprachcice tel.071-46 46 757

Pos.387-388

TJARNARVELLIR 11  
Steel- Storage house

DRG 222 a