


Undirritun samráðingarráðgjafar:

RISTAR OG TENGIBOX TIL VIÐMIDUNAR:


- S 1 = ABB KH-100 + DTT2-10-10
- S 3 = ABB KH-125 + DTT2-12-12
- S 5 = ABB KH-160 + DTT2-16-16
- S 6 = ABB KH-200 + DTT2-16-20
- S 8 = ABB KH-250 + DTT2-20-25
- S 10 = Lindab GTI-0-200 + MBA-1-160-200
- S 11 = Stifab TDYc K 200-600 + ALSc 160-200
- S 12 = Stifab TDYc K 250-600 + ALSc 200-250
- S 13 = Grada JD 130-160
- S 14 = Lindab PKA 400 + MBA-2-250-400
- S 15 = Lindab PKA 250 + MBA-1-200-250
- S 16 = Lindab PKA 200 + MBA-1-160-200
- S 17 = Lindab GTI-0-200 + MBA-2-125-200
- S 18 = Stifab TDYc K 160-600 + ALSc 125-160
- S 20 = Lindab GTI-0-200
- S 21 = Lindab PKA 315 + MBA-1-315-400
- S 22 = Kælirattar 600x1200mm (sjá verkjýsingu)

- E 1 = Lindab KSU 100 + MBA-0-100-100
- E 2 = Lindab KSU 125 + MBA-1-100-125
- E 3 = Lindab KSU 160 + MBA-1-125-160
- E 4 = Lindab KSU 160
- E 5 = Lindab CRL 125 + MBA-0-125-125
- E 6 = Lindab CRL 125 + MBA-1-100-125
- E 7 = Lindab CRL 160 + MBA-0-160-160
- E 8 = Lindab CRL 160 + MBA-1-125-160
- E 9 = Lindab CRL 200 + MBA-0-200-200
- E 10 = Lindab CRL 200 + MBA-1-160-200
- E 11 = Lindab CRL 250 + MBA-0-250-250
- E 12 = Lindab CRL 250 + MBA-1-200-250
- E 13 = Lindab CRL 250
- E 14 = Filtefist 400x300 (við gólf)
- E 15 = Lindab RGS-4-525-75
- E 16 = Lindab RGS-0-325-125
- E 17 = Lindab KSU 125

T 1 = Grada A 780 - 800 x 300

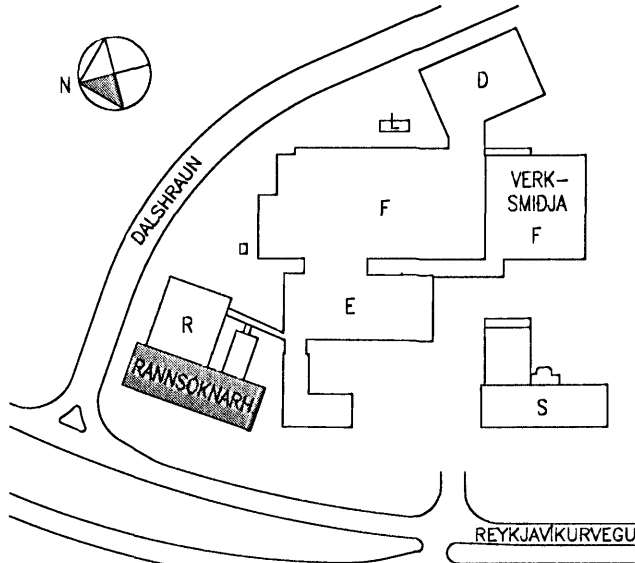

AFSTÖÐUMYND

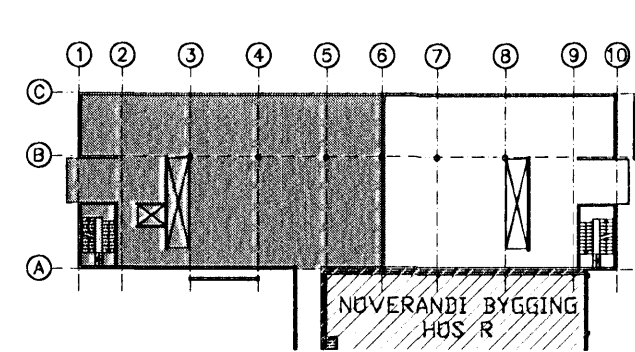

LYKILMYND

B	Tekniáritun og stökun vegna bita í ljófi	05.07.2008
A	Breytingar til samráðs við breytt skipulag	06.01.2008
Nr.	Lýsing á breytingu	Dags

actavis

Reykjavíkurvegur 80, Hafnarfirði
 R-Rannsóknarhús - Nýbygging
 Loftræstikerfi
 Grunnmynd - 3.Hæð - Hluti I

Tekning nr. IS1R-M01-03-207B

Dags: 28.09.2005 | Kvæði: 150 @ A1 | Verk nr.: 375
 Skjalnúmer: 375-Loftræstikerfi-held.dwg | Hæð: FSK/RHK | Tölud: KHK/SP | Yfirleð: FSK

LAGNATÆKNI

Hönnunar- og ráðgjafarstofa / FRV
 Hamraborg 12, 200 Kópavogur, Ísland
 Sími: 354-564 5252 Fax: 354-564 5251
 h@lagnatækni.is http://www.lagnatækni.is

Samþ: *Fjóbile S. Þrisliussau*
 Kennitala: 300346-3409

RAUNTEIKNING

18.09.2007
 Dags. *FSK* Samp.

