
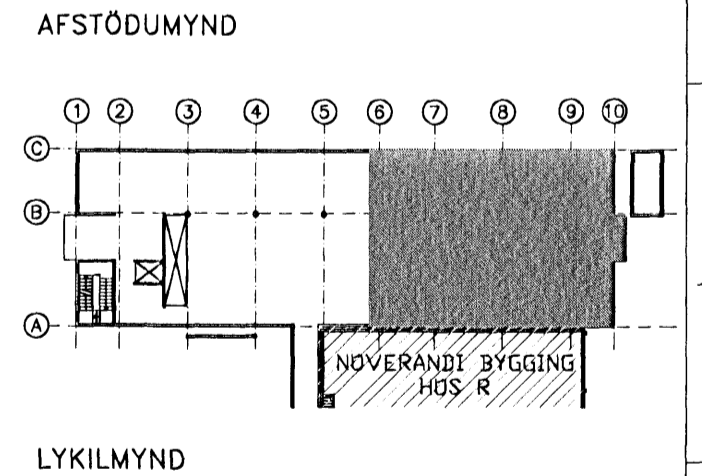


Undirritun samráðingarráðgjafar:

- RISTAR OG TENGIBOX TIL VIÐMIÐUNAR:**
- S 1 = ABB KH-100 + DTT2-10-10
  - S 3 = ABB KH-125 + DTT2-12-12
  - S 5 = ABB KH-160 + DTT2-16-16
  - S 6 = ABB KH-200 + DTT2-16-20
  - S 8 = ABB KH-250 + DTT2-20-25
  - S 10 = Lindab GTI-0-200 + MBA-1-160-200
  - S 11 = Stifab TDYc K 200-600 + ALSc 160-200
  - S 12 = Stifab TDYc K 250-600 + ALSc 200-250
  - S 13 = Grada JD 130-160
  - S 14 = Lindab PKA 400 + MBA-2-250-400
  - S 15 = Lindab PKA 250 + MBA-1-200-250
  - S 16 = Lindab PKA 200 + MBA-1-160-200
  - S 17 = Lindab GTI-0-200 + MBA-2-125-200
  - S 18 = Stifab TDYc K 160-600 + ALSc 125-160
  - S 20 = Lindab GTI-0-200
  - S 21 = Lindab PKA 315 + MBA-1-315-400
  - S 22 = Kælrifatar 600x1200mm (sjá verkýsingu)

- E 1 = Lindab KSU 100 + MBA-0-100-100
  - E 2 = Lindab KSU 125 + MBA-1-100-125
  - E 3 = Lindab KSU 160 + MBA-1-125-160
  - E 4 = Lindab KSU 160
  - E 5 = Lindab CRL 125 + MBA-0-125-125
  - E 6 = Lindab CRL 125 + MBA-1-100-125
  - E 7 = Lindab CRL 160 + MBA-0-160-160
  - E 8 = Lindab CRL 160 + MBA-1-125-160
  - E 9 = Lindab CRL 200 + MBA-0-200-200
  - E 10 = Lindab CRL 200 + MBA-1-160-200
  - E 11 = Lindab CRL 250 + MBA-0-250-250
  - E 12 = Lindab CRL 250 + MBA-1-200-250
  - E 13 = Lindab CRL 250
  - E 14 = Filtrist 400x300 (við gólf)
  - E 15 = Lindab RGS-4-525-75
  - E 16 = Lindab RGS-0-325-125
  - E 17 = Lindab KSU 125
- T 1 = Grada A 780 - 800 x 300

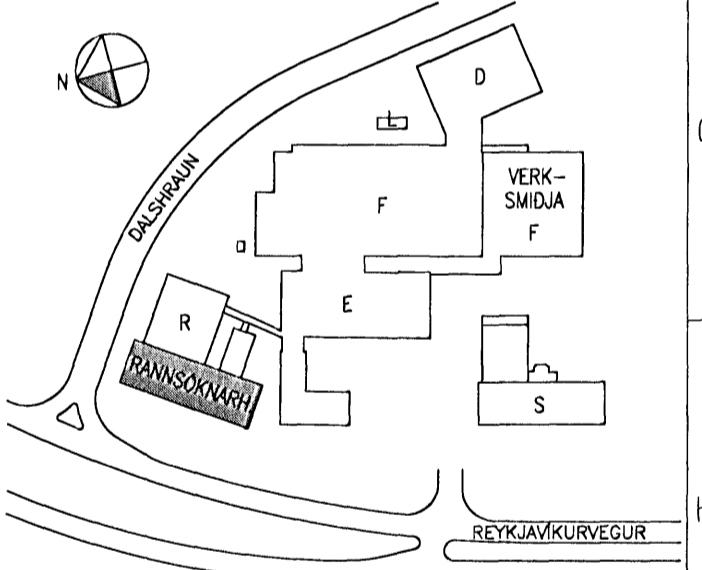

**ÚTI**  
 ARKITEKTAR  
 Jón Þór Þorvaldsson AÍ, FSSA  
 Kl. 021239 1973

**RAUNTEIKNING**  
 18.09.2007  
 Dags. FSK Samp.

A Breyting og skrifstofuáttun		08.02.2008
Nr. Lýsing & breytingu		Dags
<b>actavis</b>		
Reykjavíkuvægur 80, Hafnarfirði		
R-Rannsóknarhúsið - Nýbygging		
Loftrastikerfi		
Grunnmynd - 4.Hæð - Hluti II		
Tækningsnr. IS1R-M01-04-210A		
Dags: 28.09.2005	Kvæð: 150 @ A1	Verk nr.: 375
Skjalnúmer: 375-Loftrastikerfi-Heild.dwg		Heiti: FSK/HBG
<b>LAGNATÆKNI</b>		
Hönnunar- og ráðgjafarstofa /FRV		
Hamraberg 12, 209 Kópavogur, Ísland		
Sími: 354-564 5252 Fax: 354-564 5251		
it@lagnataekni.is http://www.lagnataekni.is		
Samp: <i>Fritjof S. Jónsson</i>		
Kennitala: 300346-3409		

