
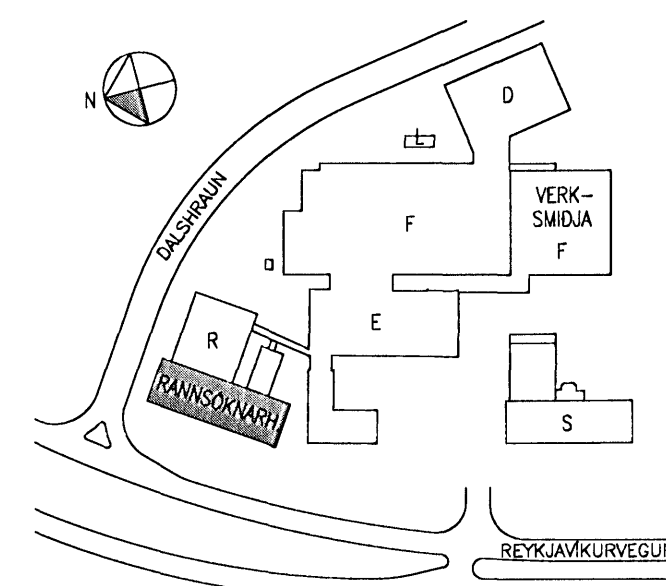


Undirritun samráðingarráðgjafa:

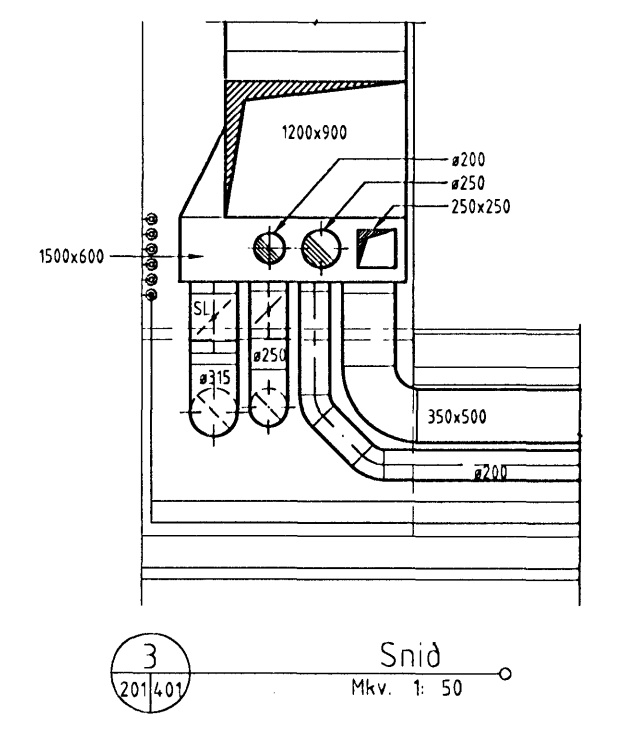

AFSTÖÐUMYND

ÓTÍ  
 ARKITEKTAR  
 Jón Þór Þorvaldsson AF, FSA  
 Húsnúmer 256 7579

A	Merkingar á AM og CD búðar	18.05.2006
Nr.	Lýsing & Breytingu	Dagur



Reykjavíkurvegur 80, Hafnarfirði  
 R-Rannsóknarhús - Nýbygging  
 Loftræstikerfi  
 Sníð í lóðrétta lagnastokka

Tekning nr.	IS1R-M01-00/01/02/03/04-401A
Dagur	28.09.2005
Skjalnúmer	315-Loftræstikerfi-held.dwg
Bládd	375

**LAGNATÆKNI**  
 Hönnunar- og ráðgjafarstofa / FRV  
 Hamraborg 12, 200 Kópavogur, Ísland  
 Sími: 351-561 5292 Fax: 351-561 5291  
 Húsnúmer: 315  
 Netfang: lagmat@lagmat.is

Samp.: **Fjórir S. Jónsson**  
 Kennitala: **300346-3409**

**RAUNTEIKNING**

18.09.2007

Dags. Samp.

FSK

