

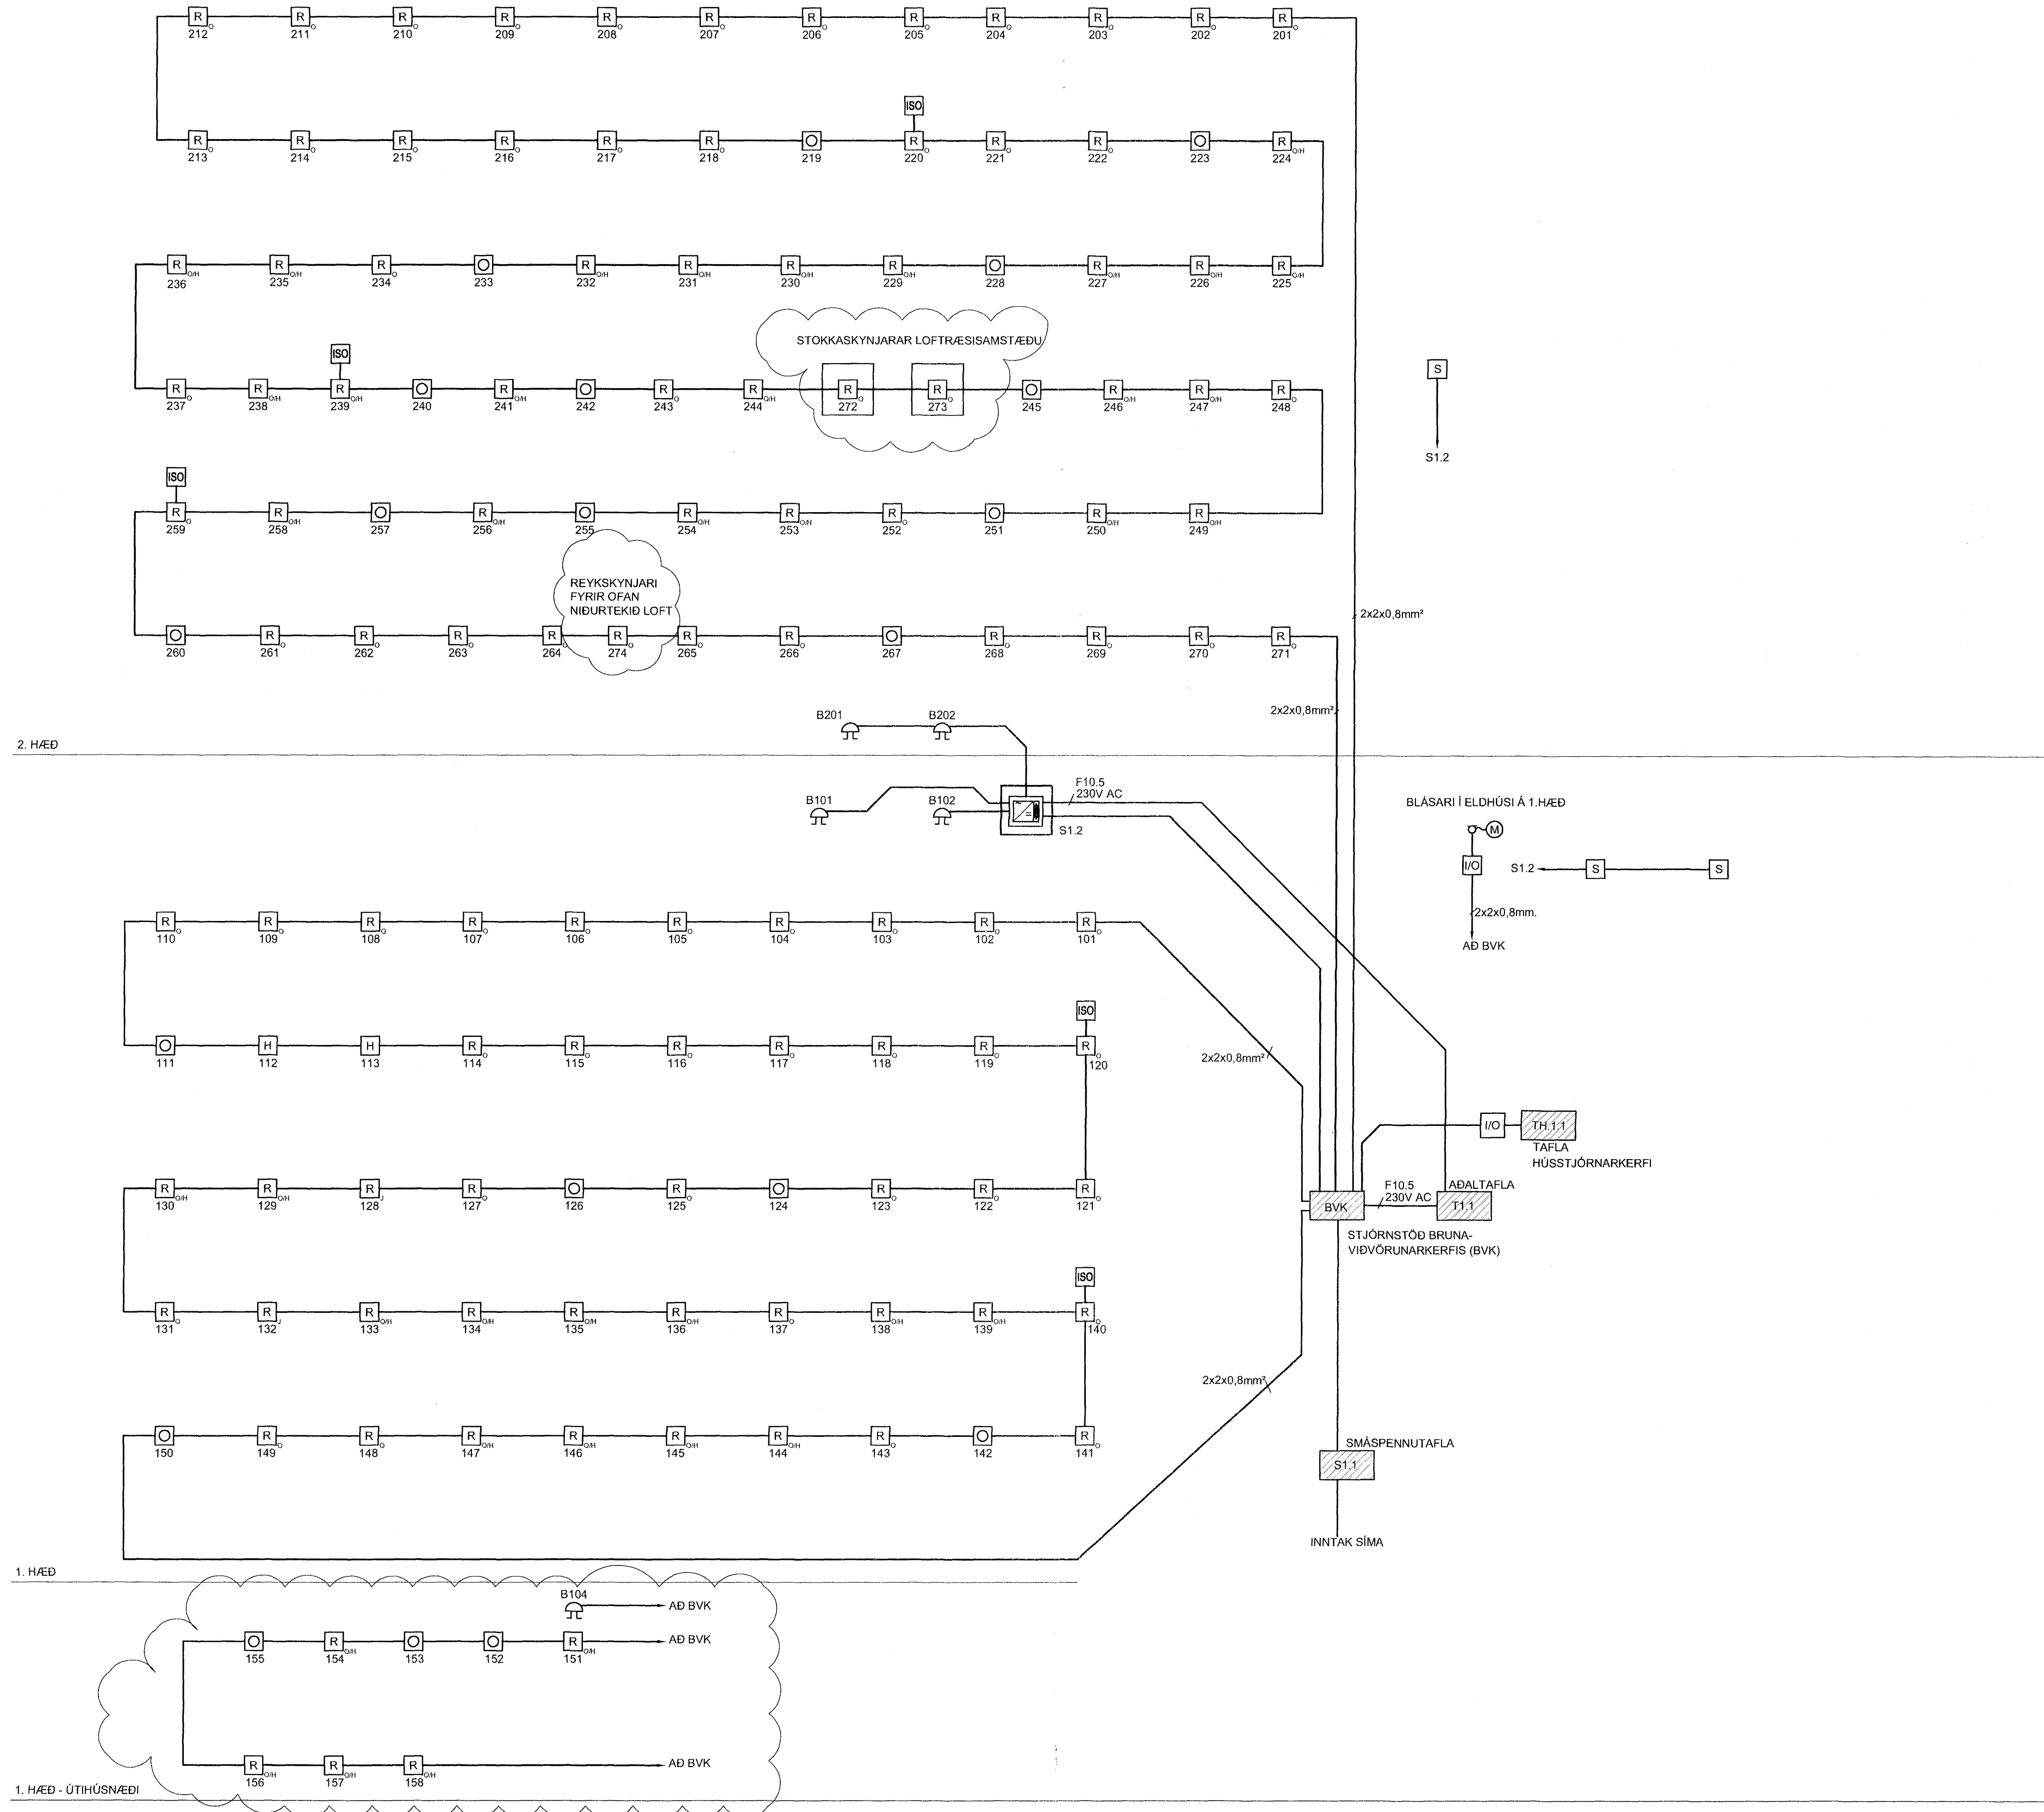


BRUNAVIÐVÖRUNARKERFI - KERFISMYND

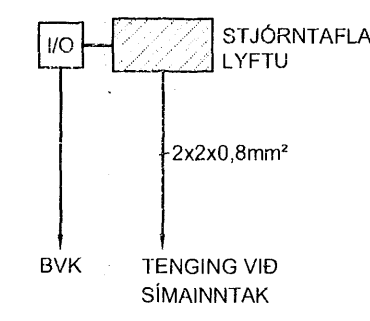

ÁRITUN SAMRÆMINGARHÖNDLUNAR

A. 11.01.2008 STOKKASKYNNJANAR LOFTRÆSISAMSTÆÐU JJ MGG  
BR. DAGS. BREYTING REYK. TEYKN.

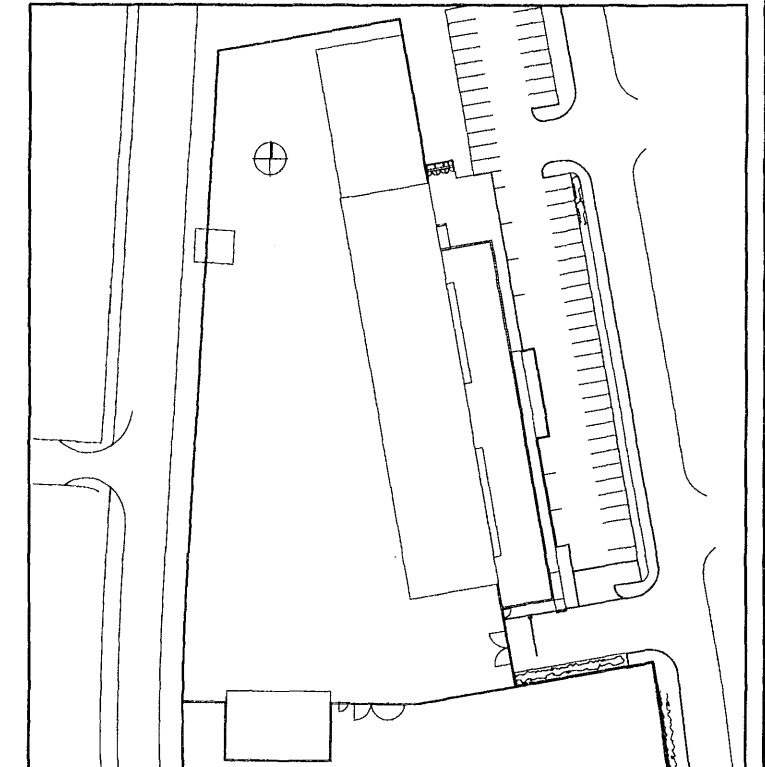

BATTERIÐ  
VEFUR: 0657  
MÖT: 27.3.08  
SAMR: [Signature]  
SKYFING: [Signature]

**VSÓ RÁÐGJÖF**  
 BRUNAVIÐVÖRUNARKERFI  
 KERFISMYND  
 BRUNAVIÐVÖRUNARKERFI

HANNAÐITERN: EASIG MGG  
 YFIRÁR: [Signature]  
 SAMBYGGI: Símon Unnarsósson  
 KT: [Signature]  
 REYKJAVÍK 11095B-7769

KVARNR: 1:50 / A1  
 VERKNR: 07102  
 TEYKN NR: R5-K-01  
 BR: A