


FRAGANGUR UNDIR PLOTU

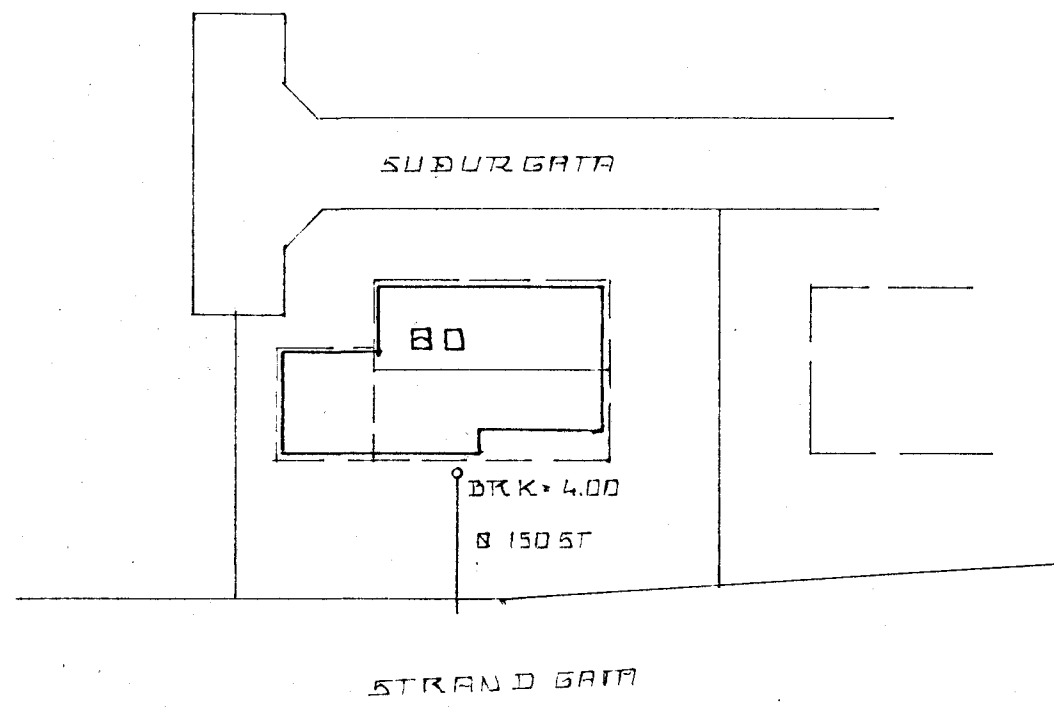

N Vatnslás

19. NOV. 1984
 HAFNARFJARDARBER
 BYGGINGAFLUTRÁÐ
[Signature]

BR SKV. ÖSKUM EIGANDA FRA TEIKNINGU DAGS SEPT '83
 VIÐ DOT DRENLOGN UNDIR PLOTU V VATNSSTREYMIS
 UPPUR KLÖPP.

JOHANNES PÉTURSSON FTFI

RVK 1/11/84		GERD NR.
REIKN. TEIKN. ÖP YFIRF.	SUÐURGATA 80 HAFNARF	VERK NR.
MELKV. 1:	GRUNN LOGN	TEIKN NR.

SJA SKYRINGAR A FYRRI TEIKNINGUM.