


- S1 : SV + PV 1-2 HÆÐ
- S2 : SB
- S3 : HL + VS
- S4 : BK
- S5 : EV
- S6 : EV
- S7 : SV + PV
- S8 : BK
- S9 : VS
- S10 : HL

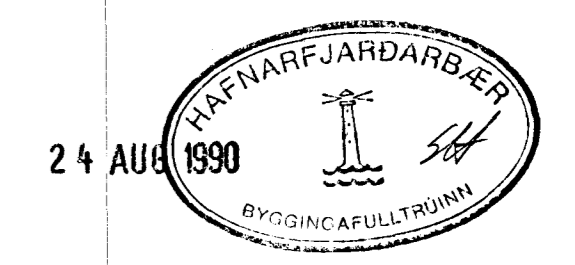

1	22.8.90	BRUNNUR OG AFREINSLI	
BR. NR.	DAGS	EDLI	BREYTINGAR
SÚBURGATA 96.98		HAFNARFJÆR	
BRUNNMYND		BRUNNLAGNA - AFSTÖÐMYND	
MÆLIKV. 1:50	1:500	Egill Þ. Þorvaldsson	
		SIGN.	
		DAGS NOV '89	
		TEIKNAD EV	
		VERK NR 8949	