


A II FERSLA EINANGR HEÐARFR. 25.4.94 R.G.

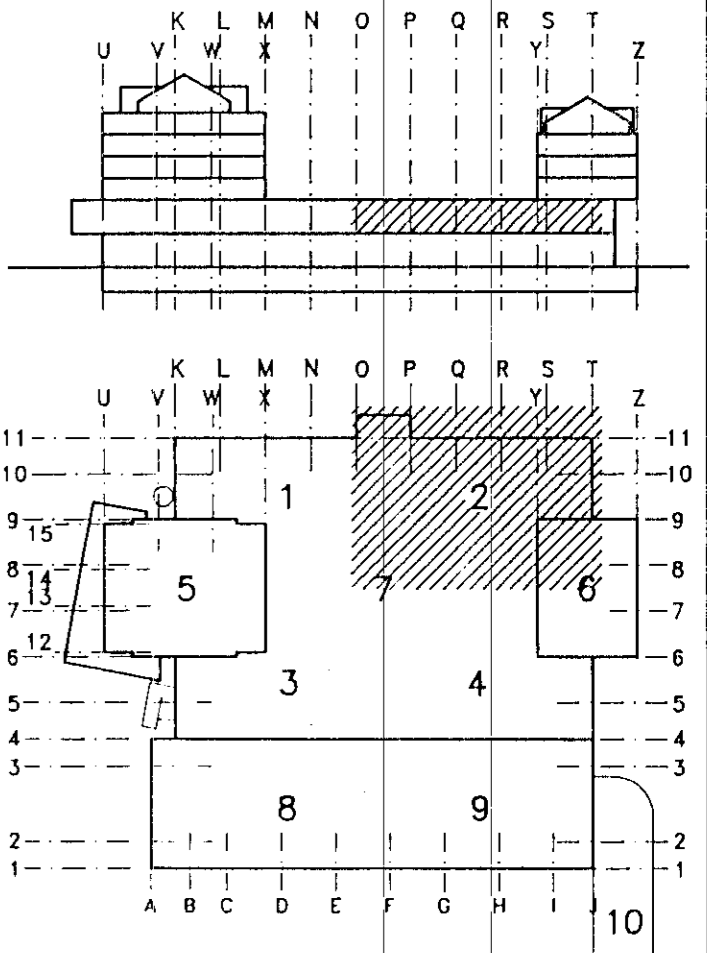

MIDBÆR
HAFNARFJARÐAR
 FJARÐARGATA 13-15

Rafn Guðmundsson TFR
 BRAUTARHOLT 8
 105 REYKJAVÍK
 SÍMI: 62 01 12
 FAX: 62 13 65

HEITI: GRUNNMYND
 2. HÆÐ
 SVEDI 2
 LOFTRÆSING

MÁL: 1:50

HANNAÐ: R. G. / T. P. / SAMP.

DAGS: 01/12 1993

TEKING NR.: LR: 22-22


BREYTING NR.: A

STIGAHÚS 2
 SJÁ TEIKN. NÖ. 24-22

Rafn Guðmundsson
 Brúdamálastofnun ríkisins
 SAMÞYKKT

05 MAY 1994

Sbr. bréf
 Theodor Árnason
Theodor Árnason

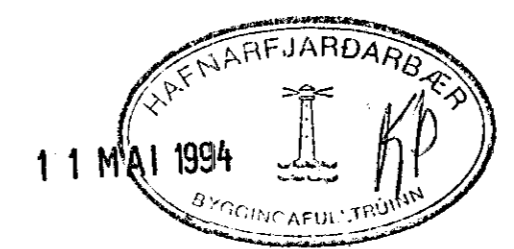

SJÁ TEIKN. NR.
 LR: 22-21

SJÁ TEIKN. NR.
 LR: 22-25

SJÁ TEIKN. NO. 24-91

SJÁ TEIKN. NR.
 LR: 22-24